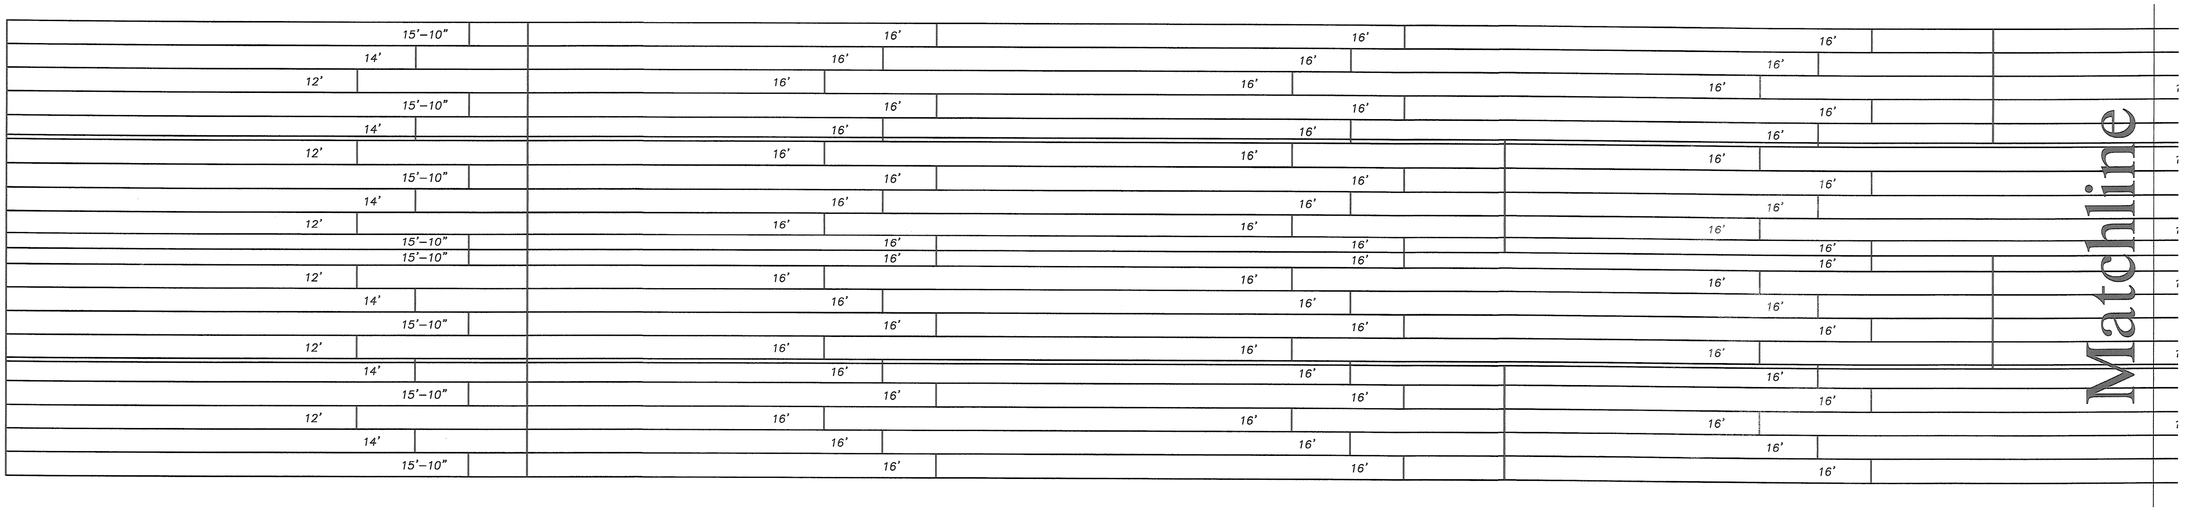

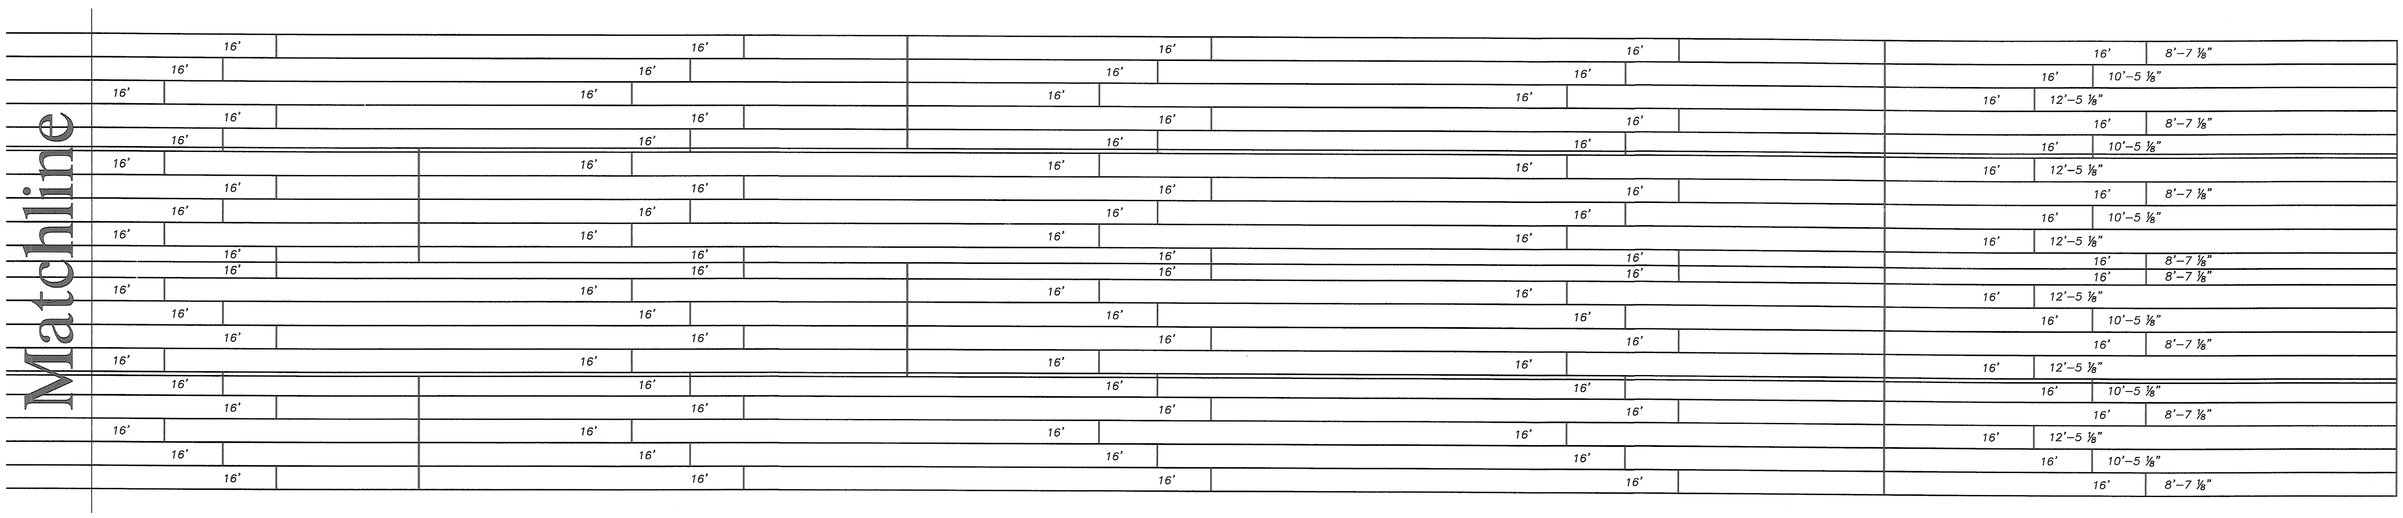

OVER-LAYMENT PLANK LAYOUT

APPROVED

RECEIVED
CK'D BY _____ OK'D BY _____
MAY 19 2004
RESUBMIT _____ APPROVED _____
BY DATE

RECEIVED

DO NOT SCALE DRAWINGS

STATE OF VERMONT
AGENCY OF TRANSPORTATION
PROPOSED IMPROVEMENT BRIDGE PROJECT

OVER-LAYMENT PLANK LAYOUT

SHOPS PREPARED BY:
WHEELER CONSOLIDATED
12127 WHITEWOOD SERVICE ROAD
WHITEWOOD, SD 57793 (605) 269-2372

TRACKING NO.: T11547		ORDER NO.: 11245	
DATE: 1/20/04	DWN: LAF	CHKD. MAC	SHEET 7 OF 10