VERTICAL GRANITE CURB
U.S. ROUTE 7 STA. 18+00 TO 19+40, LT.

GEOTEXTILE FOR SILT FENCE
U.S. ROUTE 7 STA. 17+60 TO 19+00, LT.

NOTE
1. ASSUMED 4-ROD RIGHT-OF-WAY
2. SILT FENCE TO BE PLACE WITHIN RIGHT-OF-WAY
3. SEE VTrans STANDARD C-1 FOR CURB END TREATMENT DETAILS

~~U5 U.S ROUTE 7 STA. 17+60 TO 18+00, LT. NEW 6" X 40' UNDERDRAIN CARRIER PIPE, INV IN = 223.02, INV. OUT = 222.75~~

~~U6 U.S ROUTE 7 STA. 18+00 TO 19+40, LT. NEW 6" X 140' UNDERDRAIN, INV IN = 222.75, INV. OUT AT STA. 22+50 = 216.28~~

VT STATE PLANE GRID

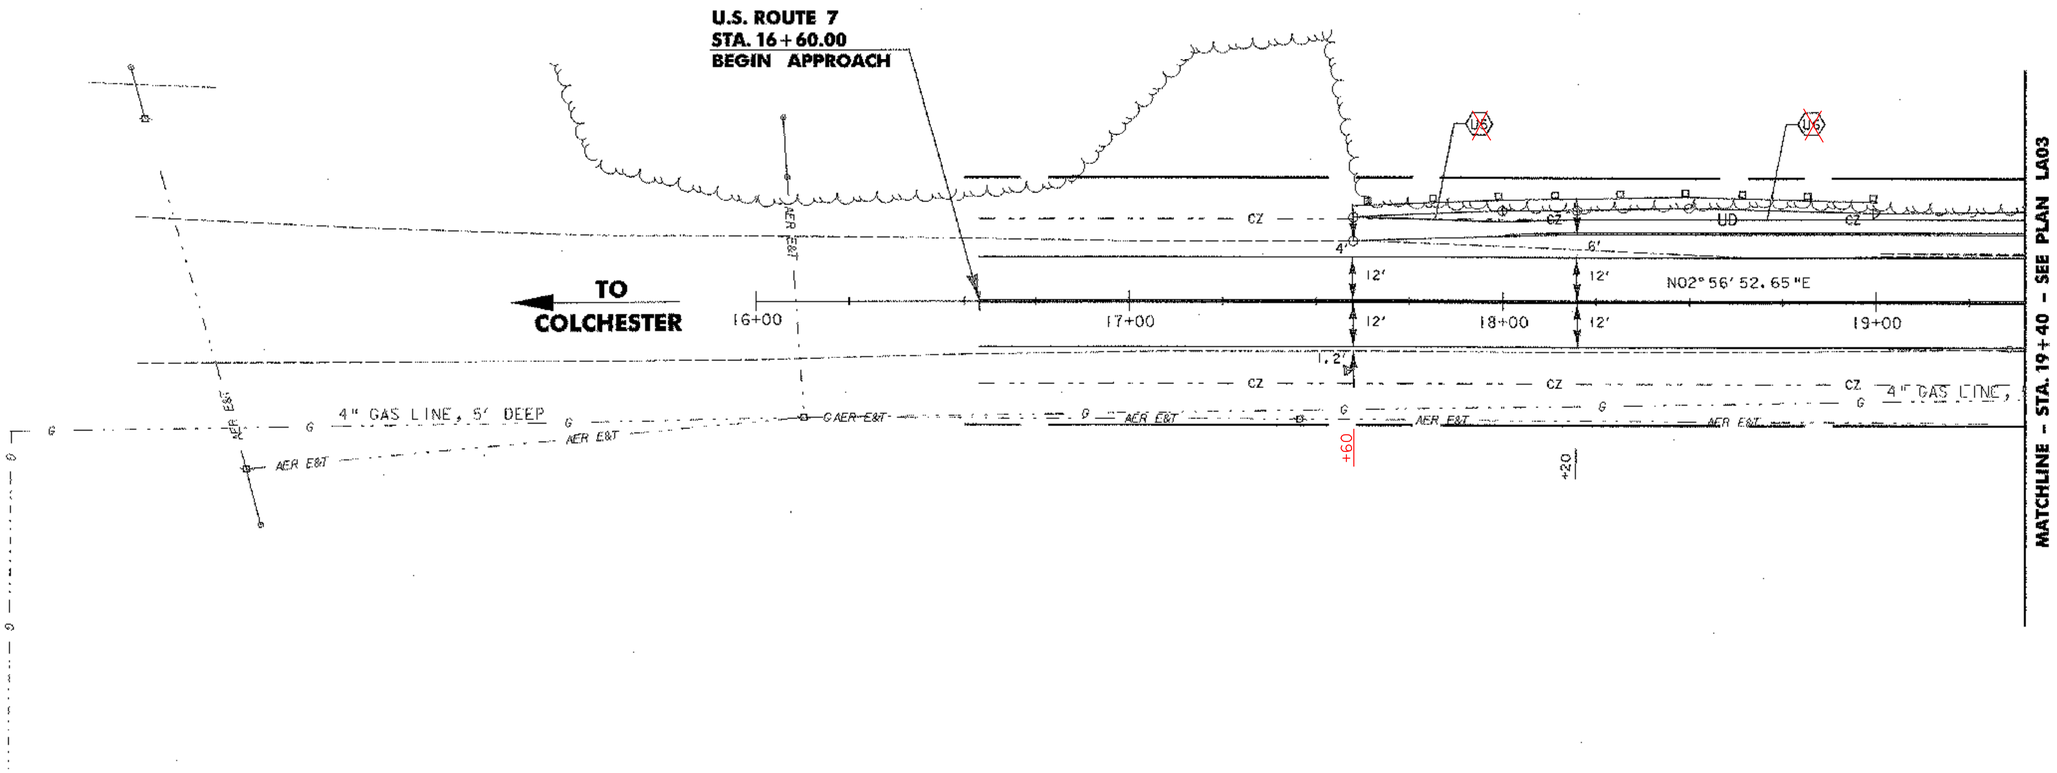

0 20 40
SCALE

Dufresne-Henry

PROJECT NAME: COLCHESTER PARK-AND-RIDE
PROJECT NUMBER: CMG PARK(18)S

FILE NAME: LA02.PTF
PROJECT LEADER: WLD
DESIGNED BY: CSP
RTE. 7 LAYOUT & EROSION LA02

PLOT DATE: 07/08/02
DRAWN BY: GGG
CHECKED BY: GAE
SHEET 14 OF 56