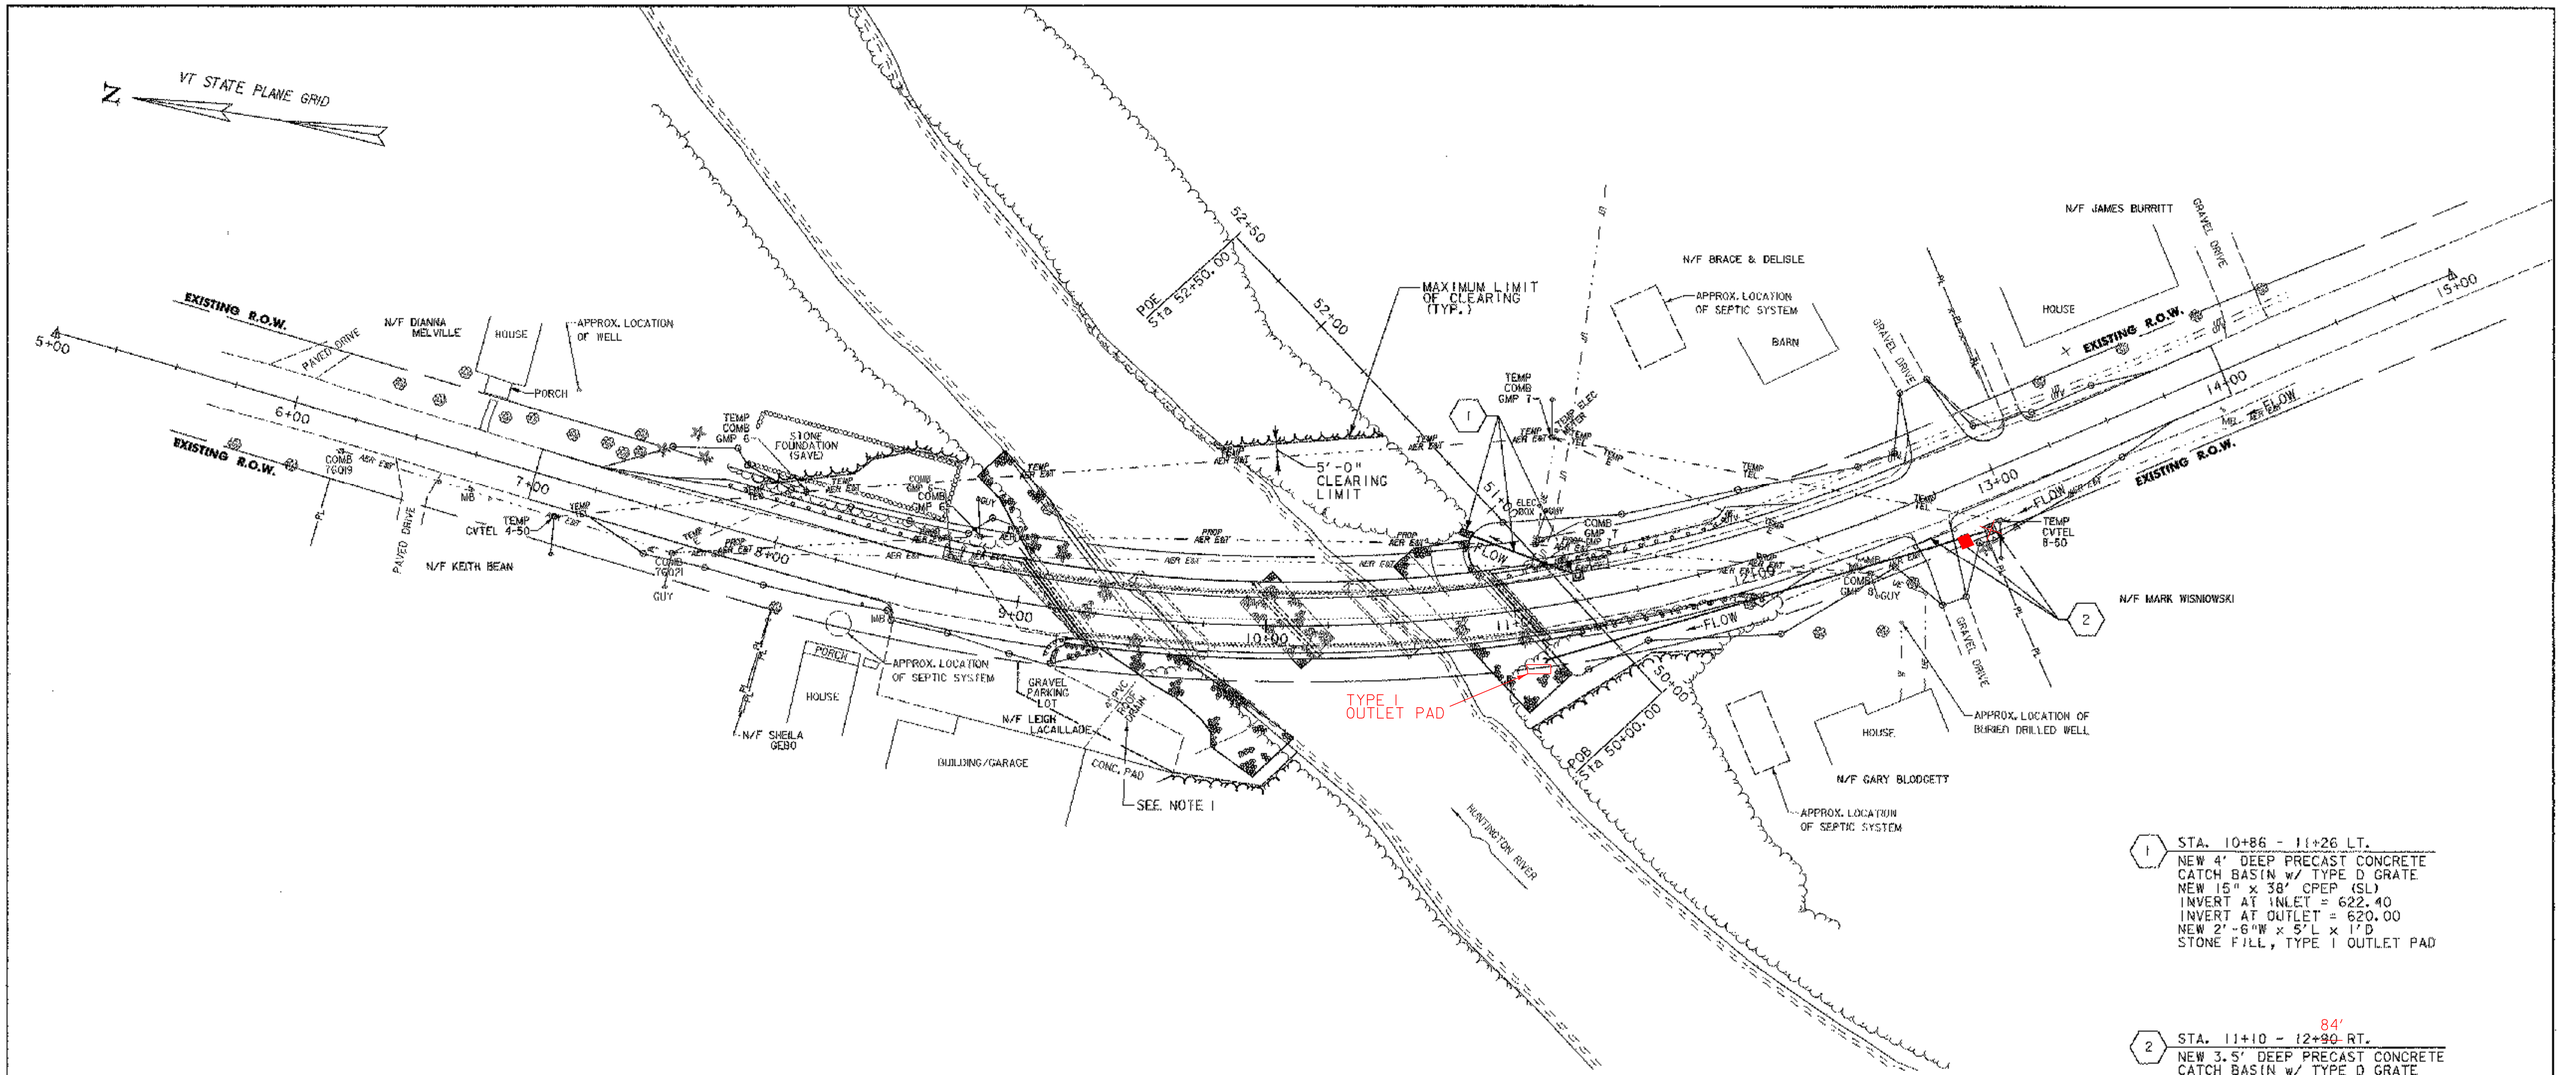

1 STA. 10+86 - 11+26 LT.
NEW 4' DEEP PRECAST CONCRETE CATCH BASIN w/ TYPE D GRATE
NEW 15" x 38' CPEP (SL)
INVERT AT INLET = 622.40
INVERT AT OUTLET = 620.00
NEW 2'-6"W x 5'L x 1'D STONE FILL, TYPE I OUTLET PAD

2 STA. 11+10 - ~~12+90~~ 84' RT.
NEW 3.5' DEEP PRECAST CONCRETE CATCH BASIN w/ TYPE D GRATE
NEW 15" x ~~182'~~ CPEP (SL) 178'
INVERT AT INLET = 618.18
INVERT AT OUTLET = ~~617.27~~ 617.27
NEW 15" CPEPES AT OUTLET
REMOVE EXISTING 12" CPEP

NOTE:

1. THE CONTRACTOR SHALL TAKE PROPER PRECAUTION TO AVOID DAMAGE TO THE EXISTING ROOF DRAIN. THE CONTRACTOR SHALL REPAIR ANY DAMAGE TO THE DRAIN AT NO COST TO THE OWNER OR TO THE PROJECT.

PROJECT NAME: HUNTINGTON
PROJECT NUMBER: BRO 1445 (29)

FILE NAME: ...\Trans\PlotFiles\09Drn&Utl.ptf PLOT DATE: 1/30/2006
PROJECT LEADER: M. CHENETTE DRAWN BY: J. OAKMAN
DESIGNED BY: D. ALTERI CHECKED BY: D. ALTERI
DRAINAGE AND UTILITY PLAN SHEET 11 OF 63

Dufresne-Henry