


# SHOP BILL

| Line | Shipping List No. Pcs | Shipping List Mark | Pcs Req'd | Code | Symbol | Section Dim's | Feet | Inches | Assembly Mark | Remarks | Mtrl. Spec. | Mtrl. App. P.O. No. | Line Item |
|---|---|---|---|---|---|---|---|---|---|---|---|---|---|
| 1 | | | | | | | | | | | | | |
| 2 | 1 | 14F1 | | | | CROSSFRAMES | | | | | | | |
| 3 | | | 1 | | WT | 15X49.5 | 8 | 9 11/16 | A | V | M270-50W | 2775LE | 1 |
| 4 | | | 1 | | WT | 6X13 | 8 | 9 15/16 | C | V | M270-50W | 2703LE | 1 |
| 5 | | | 1 | | L | 6X6X½ | 4 | 7⅞ | D | V | M270-50W | 2639BY | 1 |
| 6 | | | 1 | | L | 6X6X½ | 4 | 9 7/16 | E | V | M270-50W | 2639BY | 1 |
| 7 | | | 2 | | PL | ½X12½ | 1 | 6 | G | V BEND | M270-50W | 2693NH | 15 |
| 8 | | | 2 | | PL | ½X11¾ | 1 | 3¼ | H | V BEND | M270-50W | 2693NH | 15 |

DOMESTIC MATERIAL

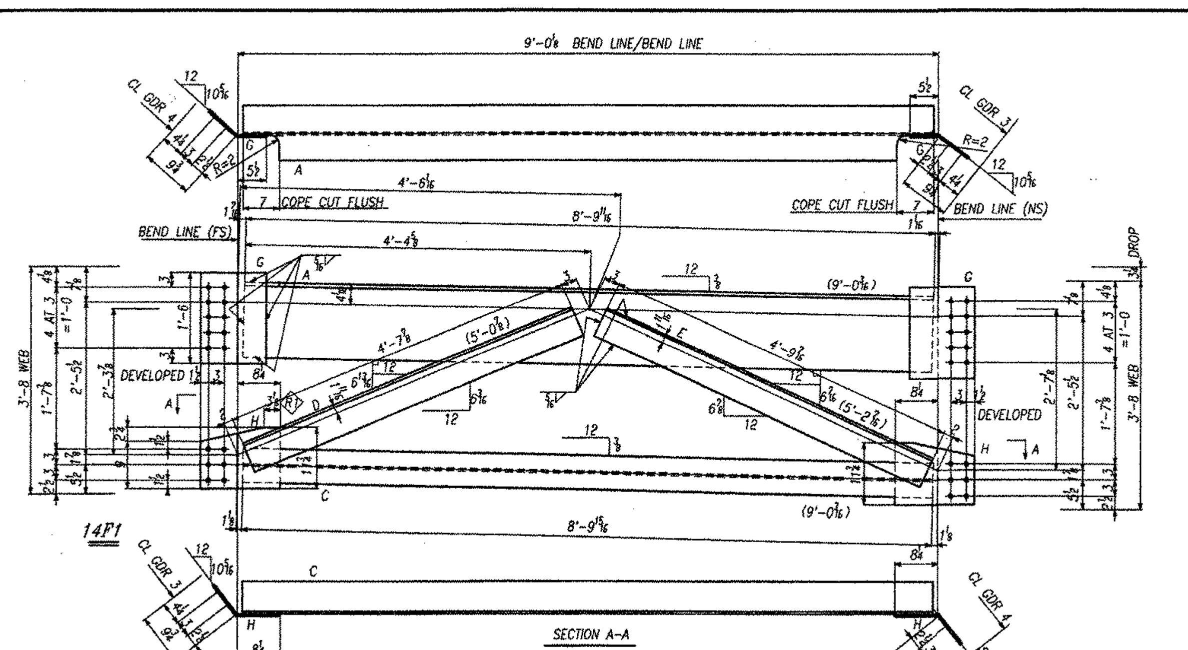


RECEIVED
CK'D BY ______ OK'D BY [signature]
FEB 7 - 2007
RESUBMIT ______ APPROVED ✓
BY [signature] DATE 2/22/07

STA 9+19.57 TO STA 11+01.07
BRIDGE # 42 EAST STREET (TH# 4)
HUNTINGTON, VT
CHITTENDEN COUNTY

FABRICATED BY NASH HOLES 15/16"
SHOP PAINT NONE
GENERAL NOTES SEE HN1

| DATE | NO. | BY | REVISIONS |
|---|---|---|---|
| 1-29-06 | R1 | FEW | ADDED DIMENSION TO PL H |

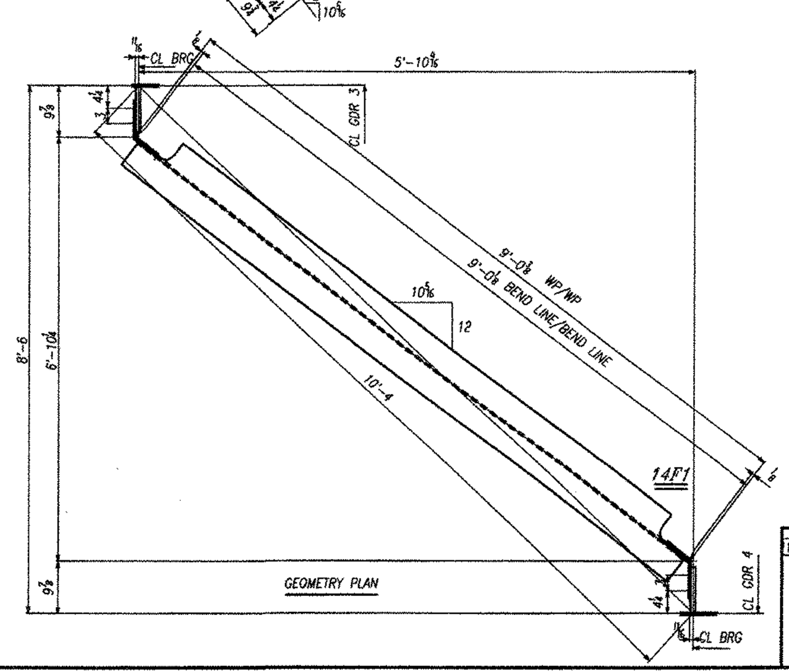ORDER NO. 06-18362H25
DETAILS OF ABUTMENT DIAPHRAGM
PROJECT BRIDGE # 42 EAST STREET (TH #4) CLASS 3 (LOCAL ROAD)
LOCATION HUNTINGTON, VT
CUSTOMER PARENT CONSTR. INC.

**CAROLINA STEEL CORPORATION**
GREENSBORO, NC (336) 275-9711

MADE BY L. Vasilescu
CHECKED BY JJF
SOLID LOADER FMW
DATE 8\29\06
SHEET HF14