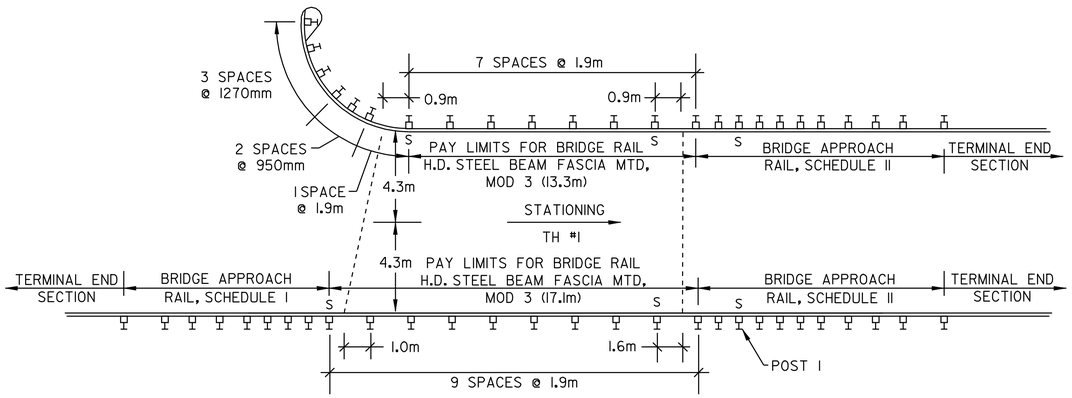

LUNENBURG – BRIDGE #16
STA 7+203 (FIELD MEASURED)= MM 4.48

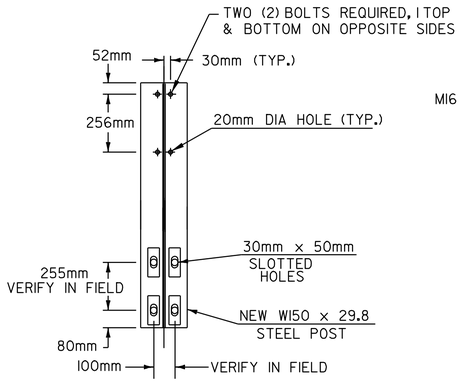

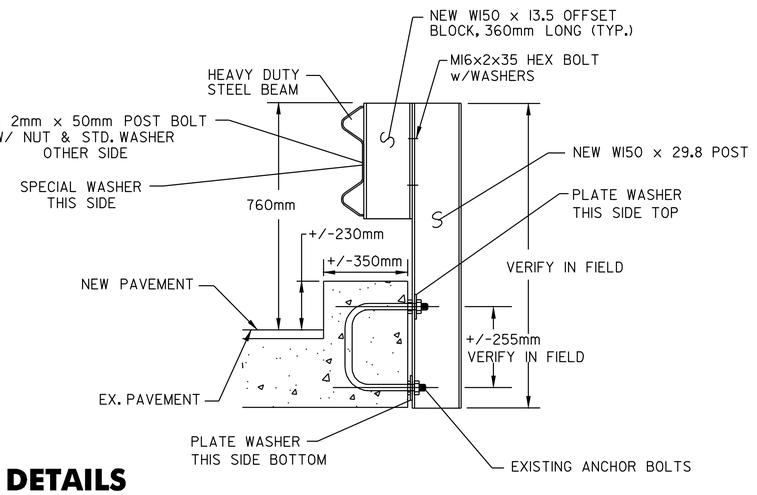

POST DETAILS

NOTES:

1. BOLTS, NUTS & WASHERS SHALL BE GALVANIZED AND CONFORM TO SECTION 714.05, EXCEPT THAT POST BOLTS SHALL CONFORM TO STANDARD G-1M REQUIREMENTS AND BE CORROSION RESISTANT.
2. POSTS, PLATE AND SPECIAL WASHER SHALL BE AASHTO M270/M270 GRADE 345W STEEL

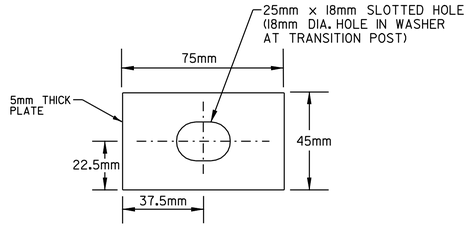

SPECIAL WASHER DETAIL

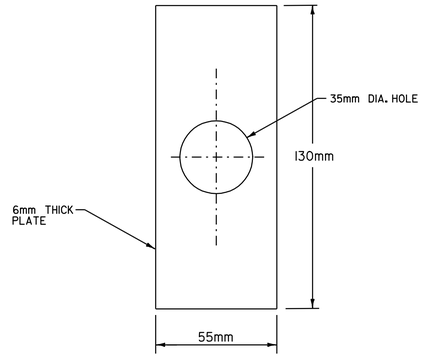

PLATE WASHER DETAIL

VDOT Metric

BRIDGE
DETAIL
SHEET #2

DESIGNED BY BCE/PJM DATE 12-01
DRAWN BY C.E.A., INC. DATE 12-01
DESIGN FILE NO. pave/01cl150/pcl50.dgn
PRF FILE pcl50br2.1 DATE PLOTTED 10-AUG-2007 14:
PROJ. NAME **LUNENBURG**
PROJ. NO. **STP 2301(7)S**
SHEET **19** OF **20** SHEETS