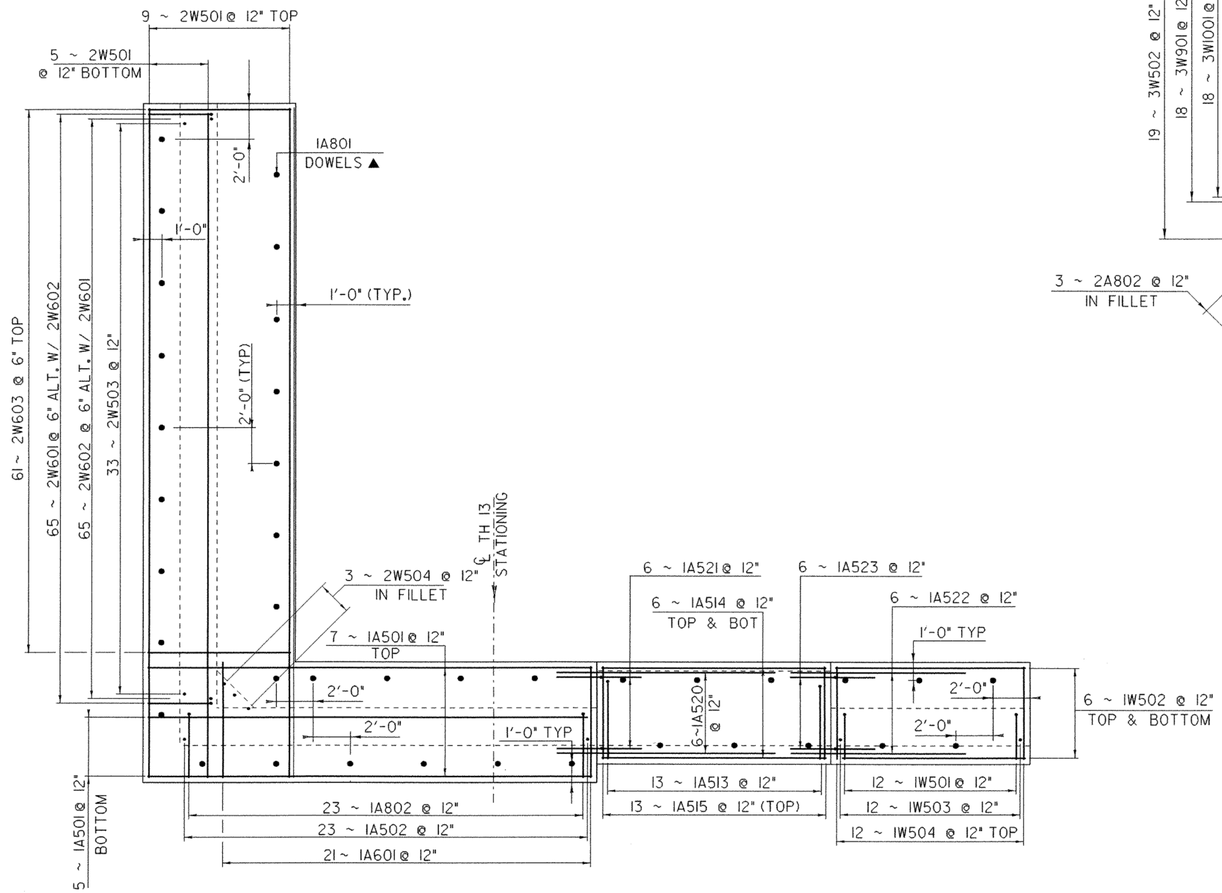

ABUTMENT #1 FOOTING REINFORCING PLAN

SCALE 1/4" = 1'-0
1 0 2 4 6

FOOTING REVISED 6/29/07
SEE SHEET PLOT DATE 11-JUL-2007

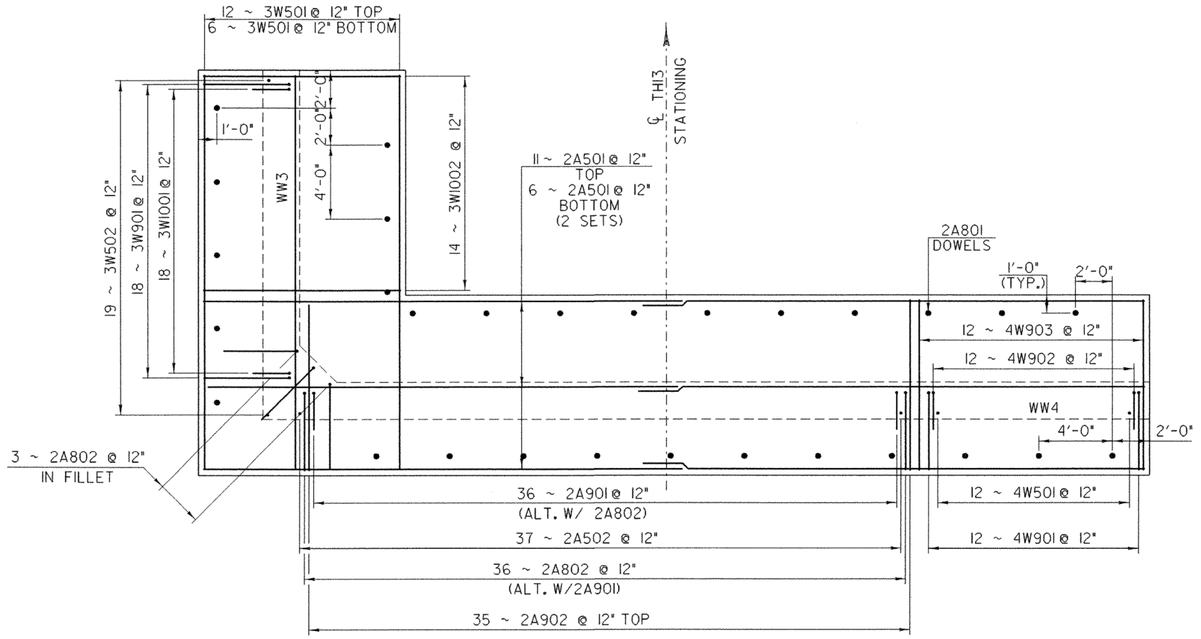

ABUTMENT #2 FOOTING REINFORCING PLAN

SCALE 1/4" = 1'-0
1 0 2 4 6

NOTE:
NF = NEAR FACE
FF = FAR FACE
EF = EACH FACE
▲ = CUT TO FIT IN FIELD
3" CLEAR UNLESS OTHERWISE SPECIFIED ON THE PLANS
2'-2" BAR LAP UNLESS OTHERWISE SPECIFIED ON THE PLANS

FOOTING REINFORCING

PROJECT NAME: BARTON
PROJECT NUMBER: BRO 1449 (29)

FILE NAME: /str5/01j168/sj168sub.dgn
PROJECT LEADER: W. SYMONDS
DESIGNED BY: J. LACROIX
sj168ftg.i
PLOT DATE: 02-APR-2007
DRAWN BY: J. SALVATORI
CHECKED BY: T. SUMNER
SHEET 57 OF 84