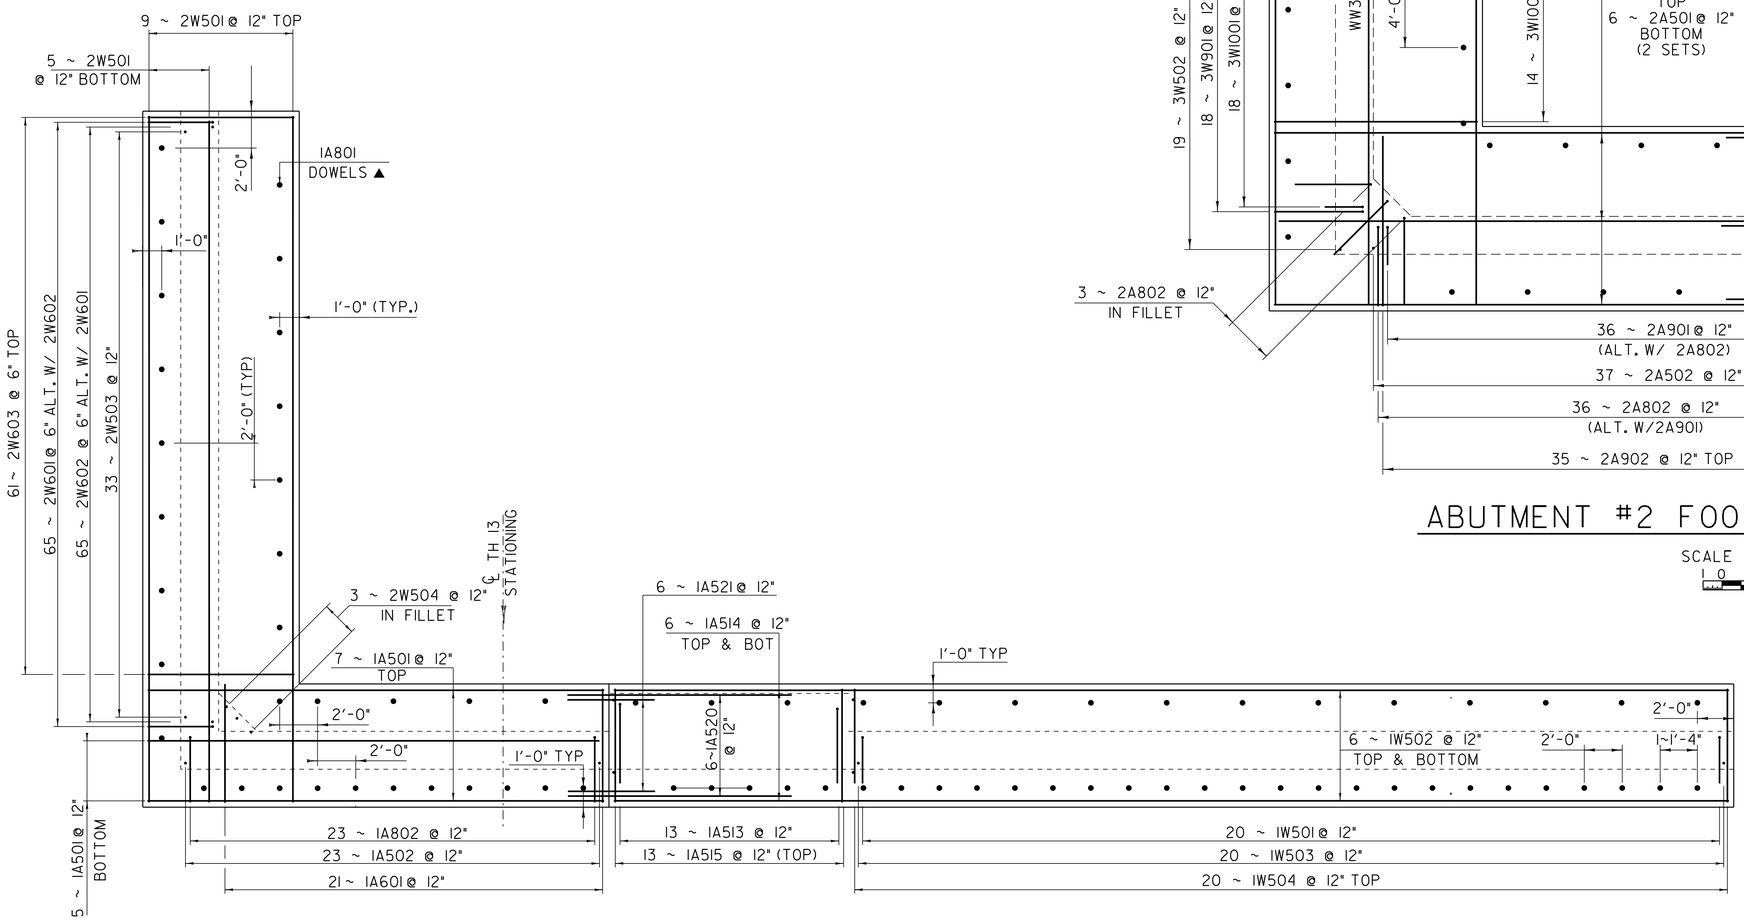

ABUTMENT #1 FOOTING REINFORCING PLAN

SCALE 1/4" = 1'-0
1 0 2 4 6

ftg - revised 6/29/07

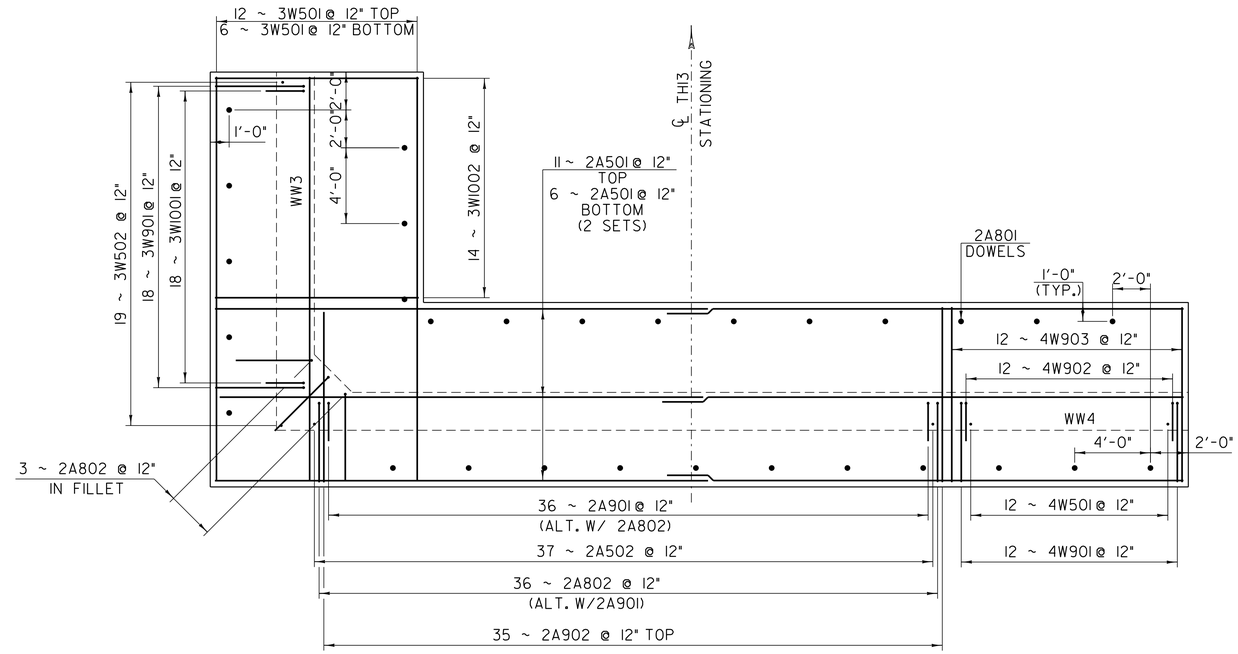

ABUTMENT #2 FOOTING REINFORCING PLAN

SCALE 1/4" = 1'-0
1 0 2 4 6

NOTE:

NF = NEAR FACE
FF = FAR FACE
EF = EACH FACE
▲ = CUT TO FIT IN FIELD
3" CLEAR UNLESS OTHERWISE SPECIFIED ON THE PLANS
2'-2" BAR LAP UNLESS OTHERWISE SPECIFIED ON THE PLANS

FOOTING REINFORCING

PROJECT NAME:	BARTON
PROJECT NUMBER:	BRO 1449 (29)

FILE NAME: /str5/01j168/sj168sub.dgn	PLOT DATE: 12-SEP-2011
PROJECT LEADER: W. SYMONDS	DRAWN BY: J. SALVATORI
DESIGNED BY: J. LACROIX	CHECKED BY: T. SUMNER
sj168ftg.i	SHEET 57 OF 84