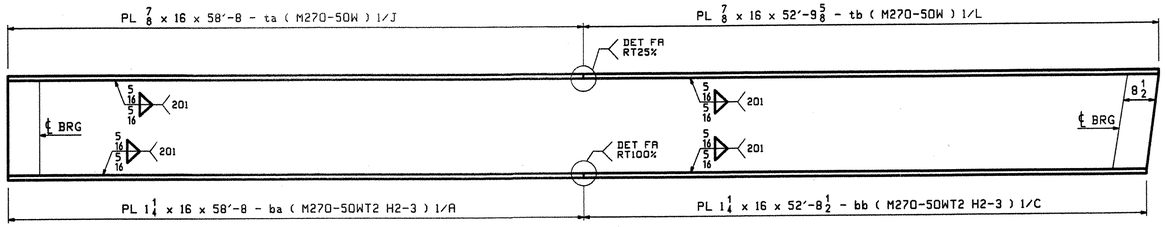

FLANGE DIAGRAM FOR 1G1 THRU 5G5

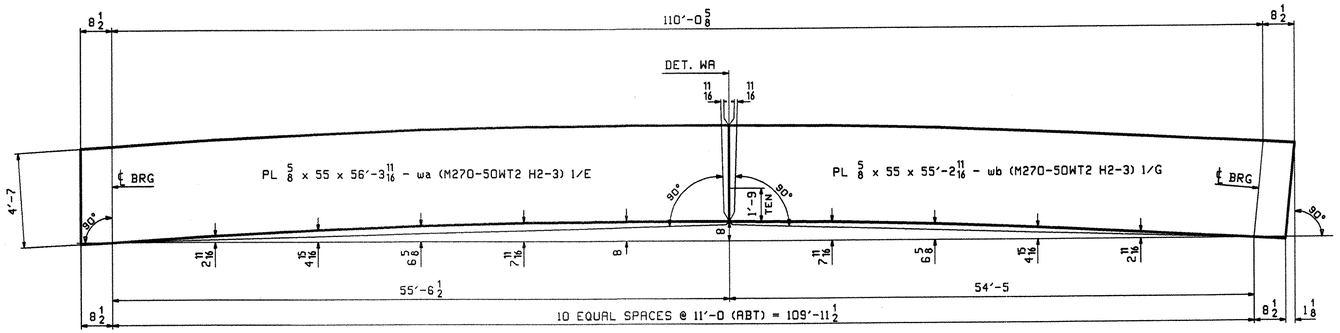

CAMBER DIAGRAM FOR 1G1 THRU 5G5

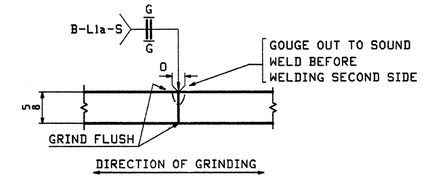

WEB PLATE SPLICE DETAIL "WA"

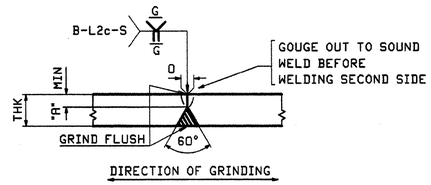

FLANGE PLATE SPLICE DETAIL "FA"

FLG THK	"A"
7/8	1/4
1 1/4	3/8

RECEIVED
OK'D BY JKL OK'D BY
JUL 24 2007
RESUBMIT APPROVED ✓
BY WY DATE 7/27/07

REV.	REMARKS	DATE	DWN	CHK	APP	Q.A.	NO.	DIA.	LGT	TYPE	WASHER
	OUT FOR APPROVAL 6/14/07										
	OUT FOR APPROVAL 7/20/07										
	ISSUED TO SHOP										
	FIELD & OFFICE										

MATERIAL:	ELECTRODES:	HOLES:	SHOP BOLTS:
A709-50W (UN)		NONE	NONE

SURFACE PREP. & PAINT:
SEE DRAWING GN1

DESCRIPTION: CAMBER DIAGRAM	DRAWN BY	DATE
JOB: TOWN HIGHWAY #3 OVER WILLOUGHBY RIVER BRIDGE NO. 61 TOWN OF BARTON, VILLAGE OF ORLEANS COUNTY OF ORLEANS, VERMONT CONTRACTOR: JA McDONALD	JTB	06/06
	CHKD BY	
	ELC	06/07
	APPROV BY	
TENSOR 2722	SUPERVISOR	W. J. GATTI
PROJ NO. BRO 1449(29)	Q.A.	
CUSTOMER: VERMONT AOT		

CASCO BAY STEEL STRUCTURES, INC.
75 SPRING HILL ROAD SACO, MAINE 04072
PHONE (207) 282-7360 FAX. (207) 282-1179

JOB NO.	DRG. NO.
328	C1
	REV. △

NOTES:

1. FOR GENERAL NOTES SEE DWG GN1.
2. H2-3 DENOTES MATERIAL SUBJECT TO CHARPY V-NOTCH TEST AT H FREQ. FOR ZONE 2

ELC Wed, Jun 13, 2007 11:53:36 AM /users/jobs/2722/C1.dwg

093 SS