1-800-225-4977 prior to any excavation at locations which may be in the immediate vicinity of underground utilities.

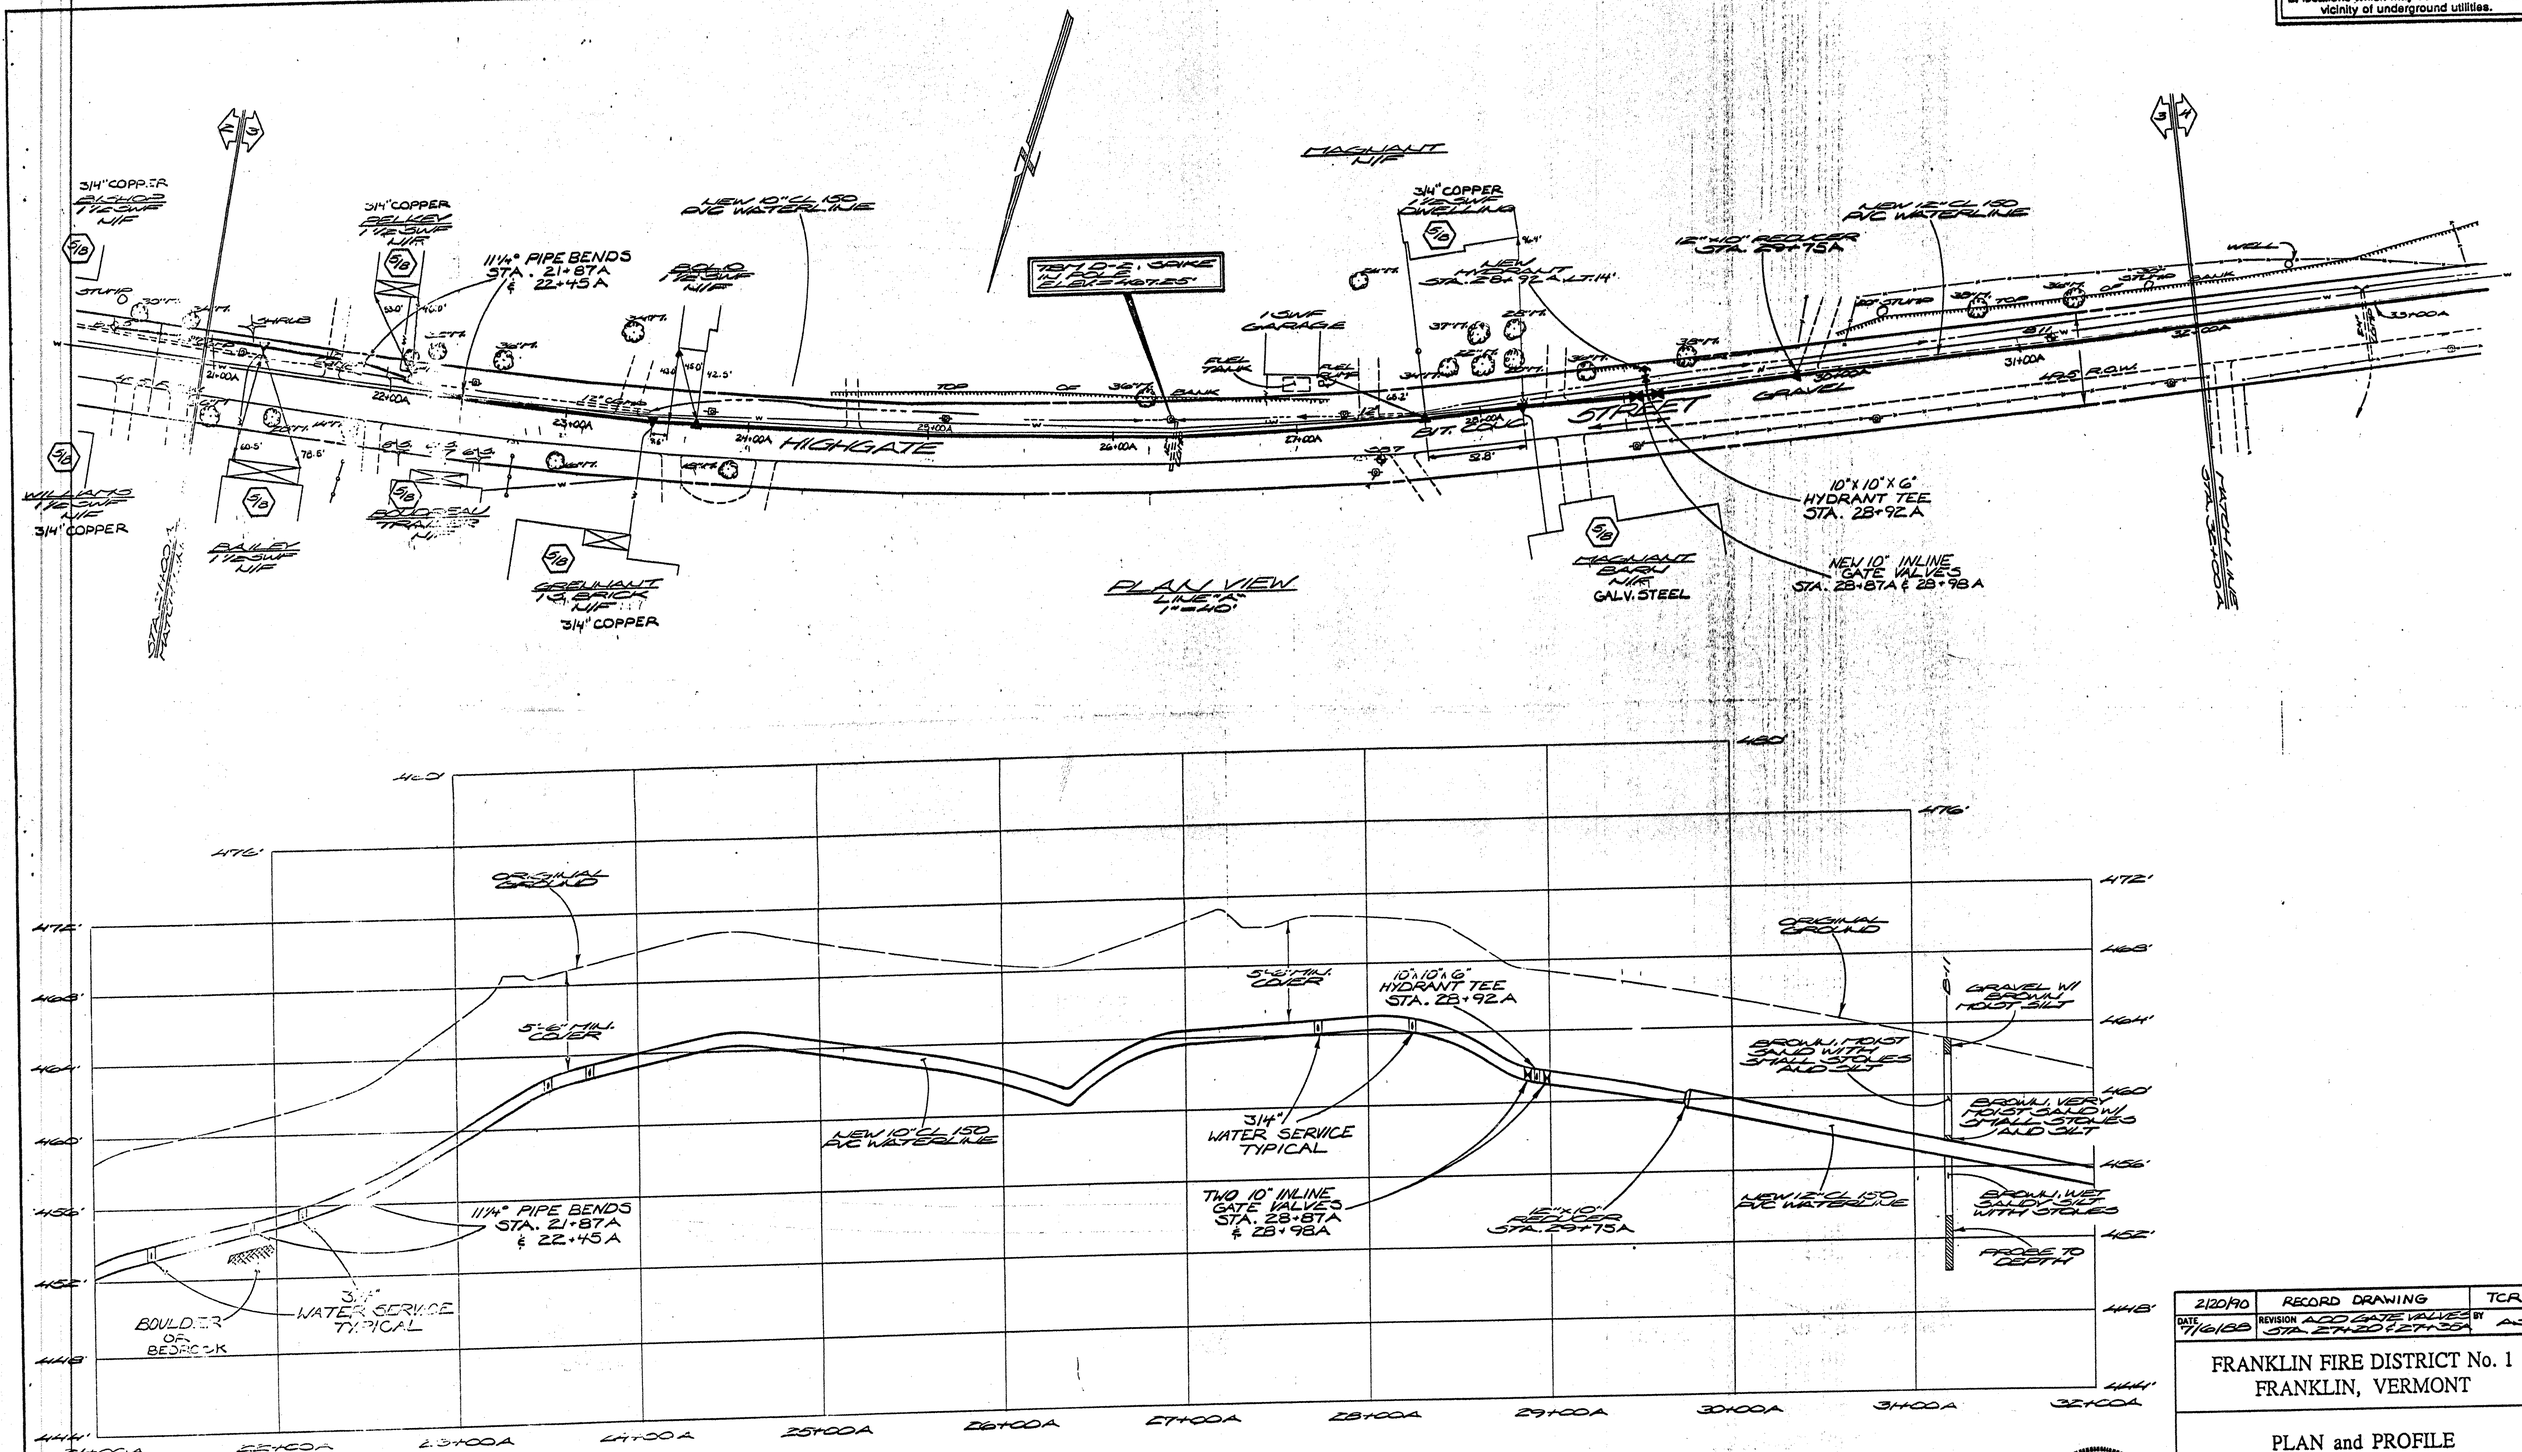

RECORD DRAWING
FEBRUARY 1990

STATE OF VERMONT ALOIS STRANSKY NO. 5393 REGISTERED PROFESSIONAL ENGINEER

2/20/90	RECORD DRAWING		TCR
DATE 7/6/88	REVISION ADD GATE VALVES STA. 27+20 & 27+30	BY	AS

FRANKLIN FIRE DISTRICT No. 1
FRANKLIN, VERMONT

PLAN and PROFILE
21 + 00A to 32 + 00A

SURVEY MRM	Donald L. Hamlin	SCALE SHOWN	
DESIGN AS	CONSULTING ENGINEERS, INC. Essex Junction, Vermont	DATE 5/24/88	
DRAWN JRD		DRW. NO. 3 of 20 60 OF 60	
CHECKED AS/MCW			

87-110 | 5814