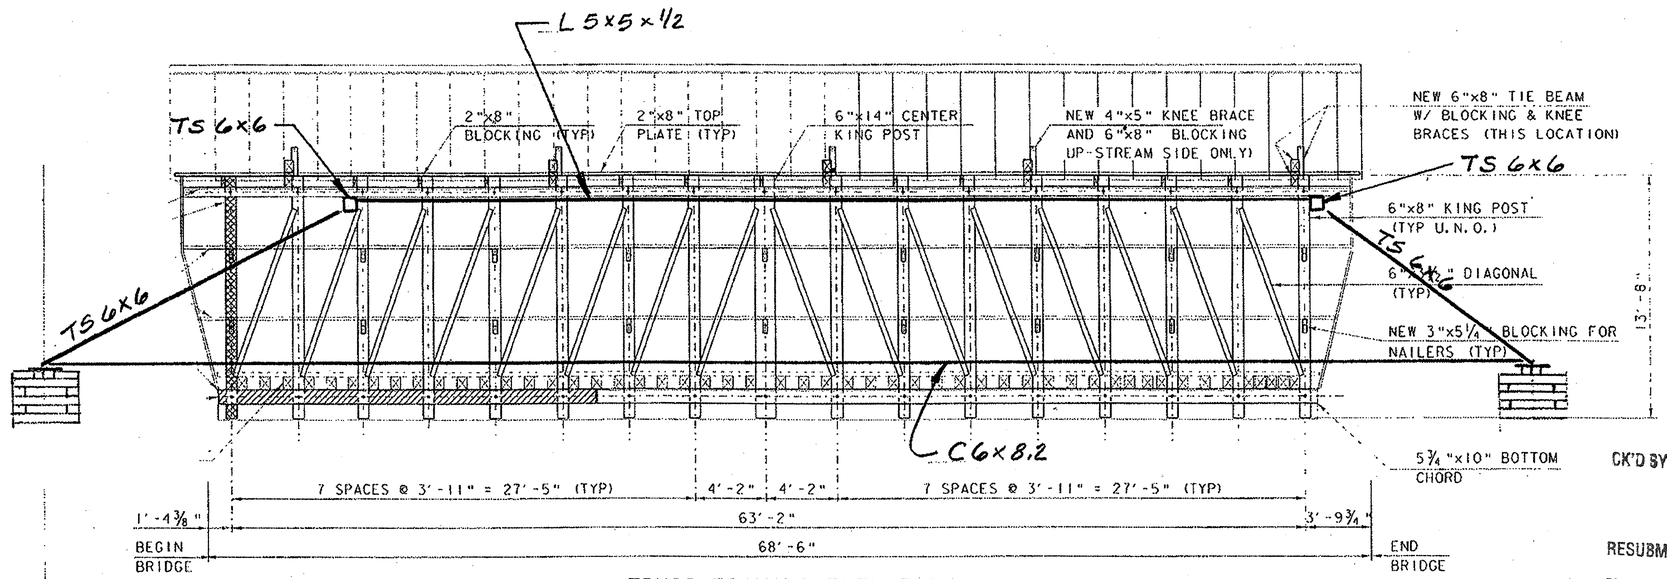

TRUSS FRAMING ELEVATION

SCALE ¼" = 1'-0"

SOUTH TRUSS SHOWN
NORTH TRUSS SIMILAR

ALL LUMBER AND TIMBER IS EXISTING UNLESS NOTED OTHERWISE.

RECEIVED

CK'D BY _____ OK'D BY _____

APR 1 2 2006

RESUBMIT _____ APPROVED _____

BY DATE

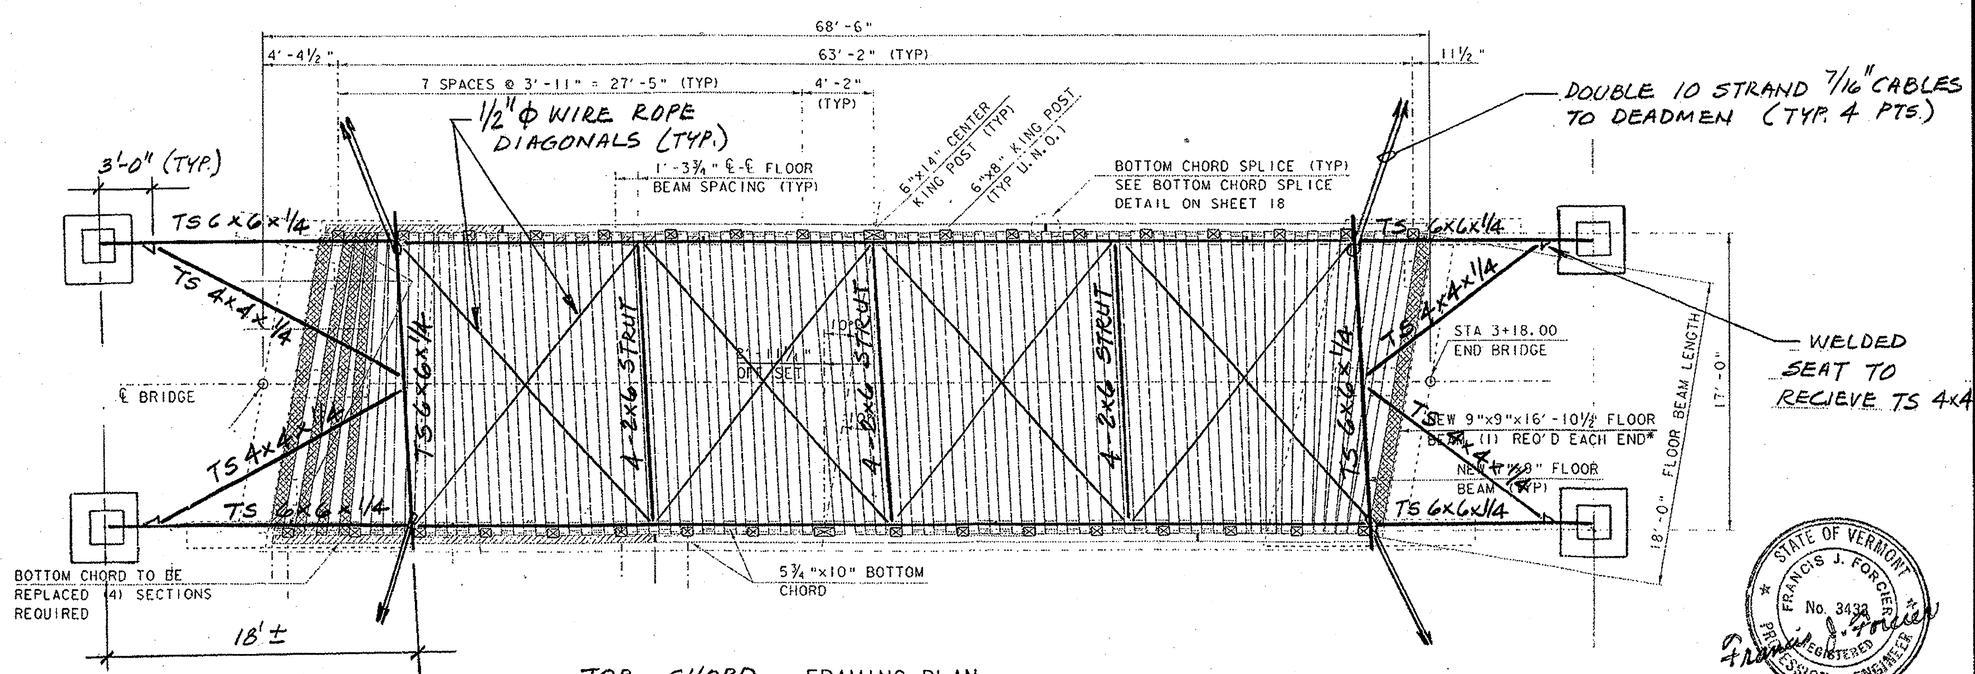

TOP CHORD FRAMING PLAN

SCALE ¼" = 1'-0"

STATE OF VERMONT
FRANCIS J. FORCIER
No. 3433
REGISTERED PROFESSIONAL ENGINEER

Francis J. Forcier
4-05-06

Dufresne-Henry
North Springfield, Vermont
Tel. (802) 886-2261 • FAX (802) 886-2240
www.dufresne-henry.com

Rev.	Description	By	Date

VERMONT

CILLEY COVERED BRIDGE

TEMPORARY SUPPORT SYSTEMS

TUNBRIDGE

Project No.	2005038
Proj. Manager	F.J. FORCIER
Proj. Designer	F.J. FORCIER
Drawn By	FJF
Checked By	
Scale	AS SHOWN
Approved	
Date	MARCH 2006

S1

Sheet of

B