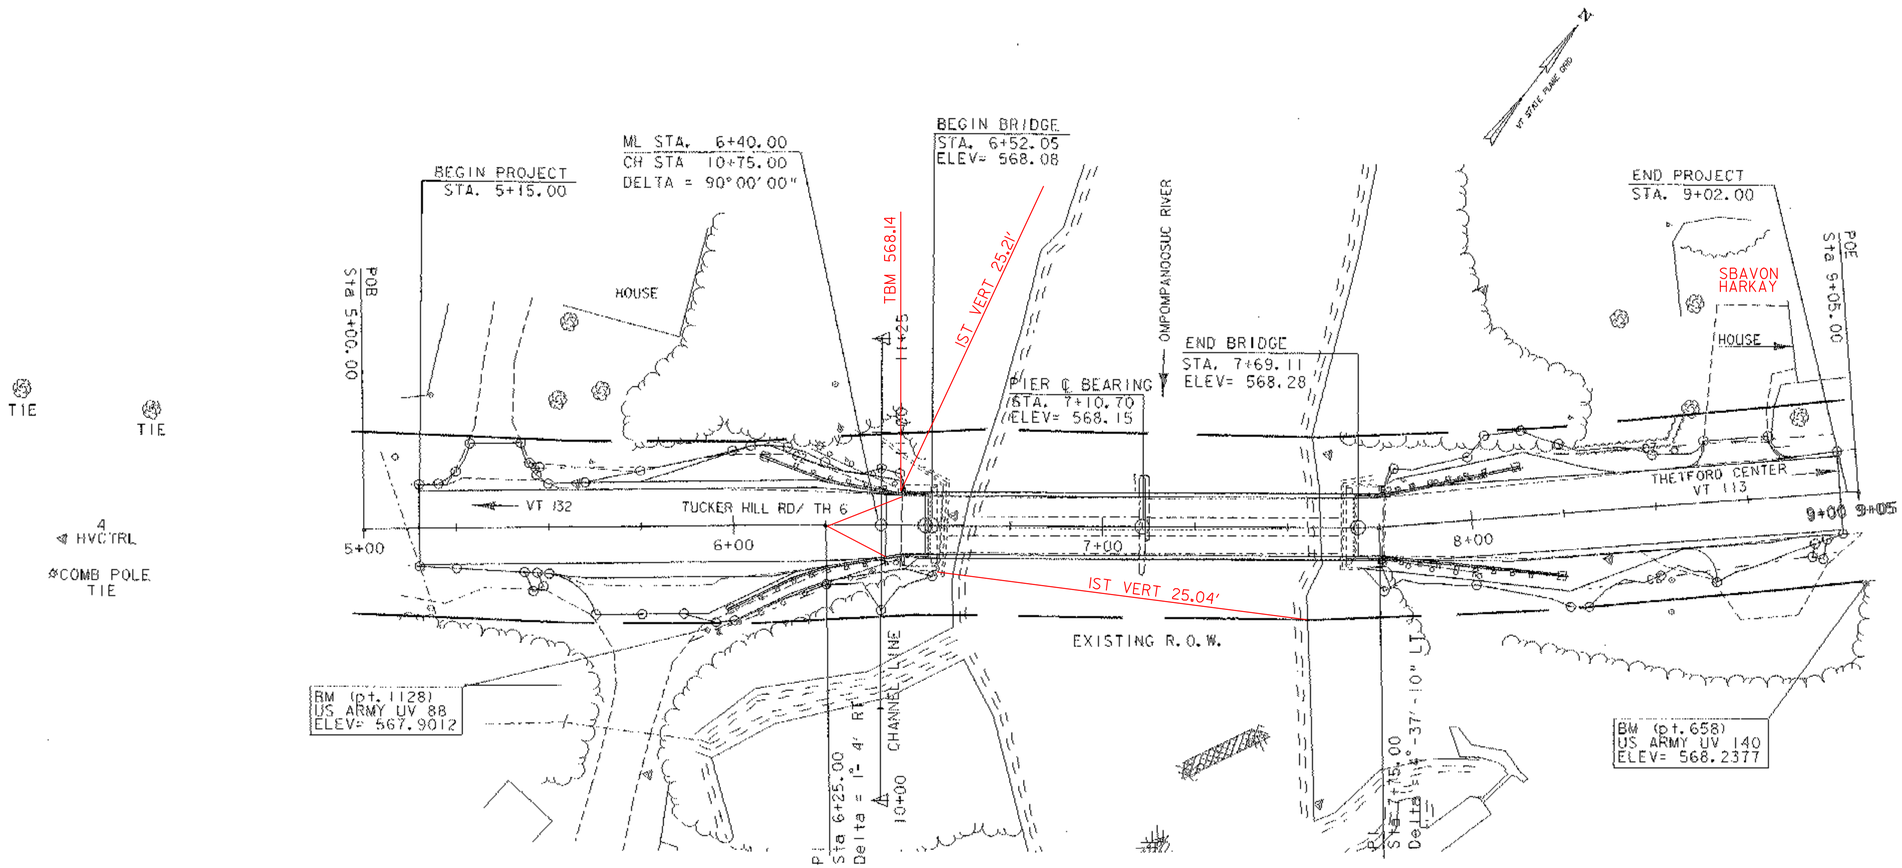

CONSTRUCT DRIVE

STA.
5+30.00 LT
5+75.00 RT
8+75.00 LT

STEEL BACKED TIMBER RAIL

STA.	TO	STA.
5+98.00 RT	-	6+55.91 RT
6+07.86 LT	-	6+55.91 LT
7+65.50 LT	-	8+14.00 LT
7+65.50 RT	-	8+24.50 RT

ITEM 646.21 4" YELLOW LINE

STA.	TO STA.	LENGTH	
5+15.00	6+25.00	110 ft.	(DOUBLE YELLOW LINE = 220ft.)
7+90.00	9+00.00	110 ft.	(DOUBLE YELLOW LINE = 220ft.)

STEEL BACKED TIMBER RAIL ANCHORS

STA.
5+99.20 RT
6+08.90 LT
8+12.98 LT
8+23.28 RT

BRIDGE DECK TIMBER RAIL

STA.	TO	STA.
6+53.41 RT	-	7+68.00 RT
6+53.41 LT	-	7+68.00 LT

0 20 40
SCALE IN FEET
1"=20'

LAYOUT SHEET

PROJECT NAME: THETFORD
PROJECT NUMBER: BHO 1444 (43)

FILE NAME: Structures\s03j036bdr.dgn
PROJECT LEADER: M.EVANS-MONGEON
DESIGNED BY: G. ROKES
IPARM: s03j036lo.1

PLOT DATE: 27-SEP-2006
DRAWN BY: G.ROKES
CHECKED BY: S. SCRIBNER
SHEET 9 OF 60