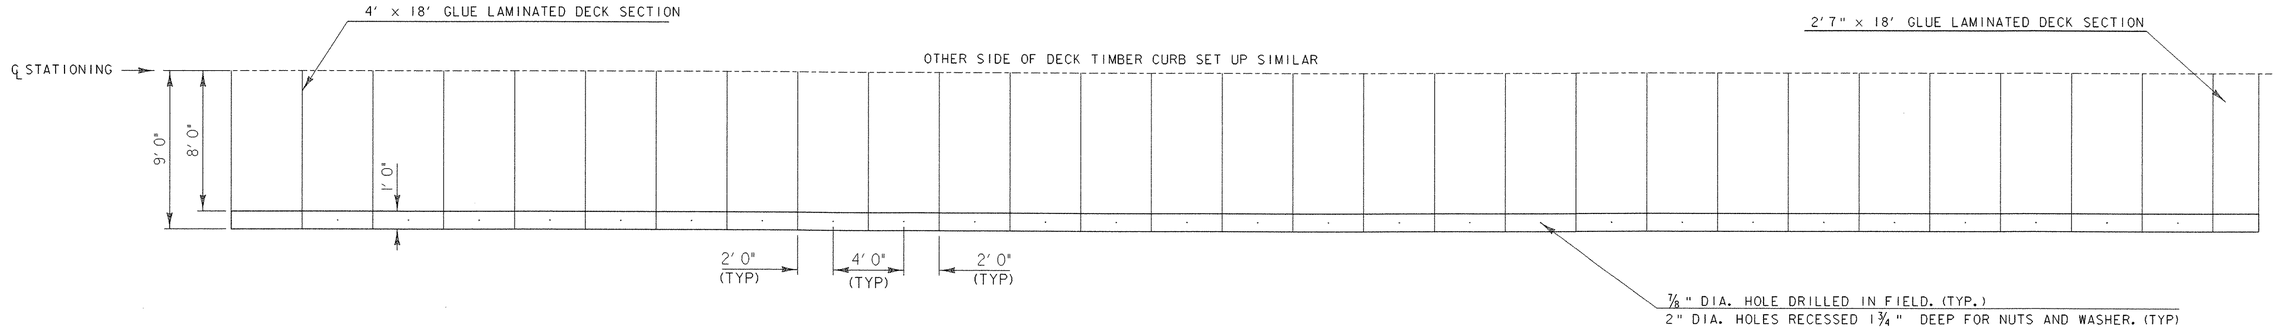

TIMBER CURB TO DECK PLACMENT PLAN VIEW

SCALE 1/4"=1'

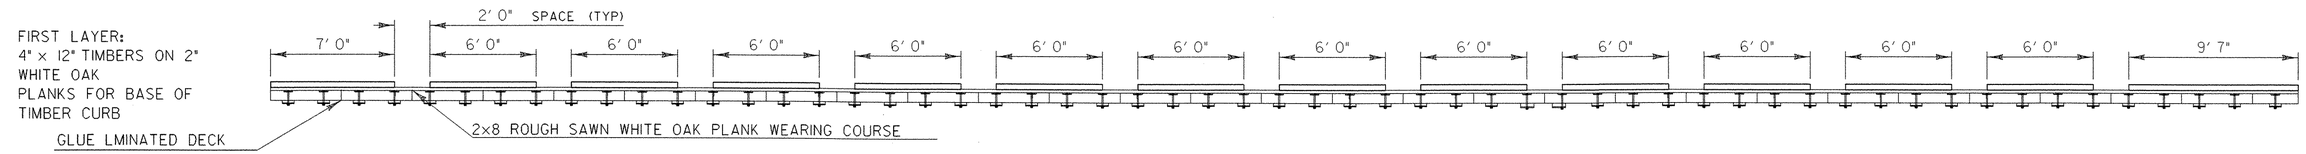

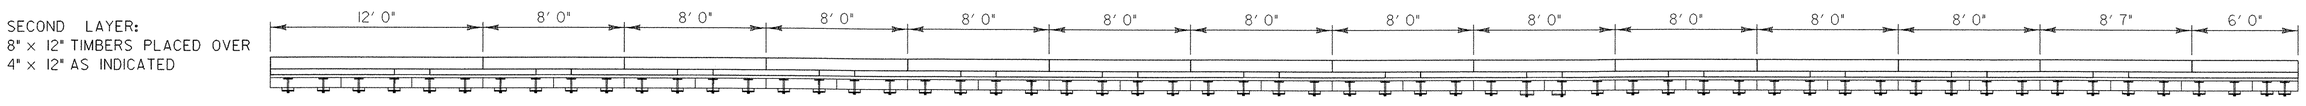

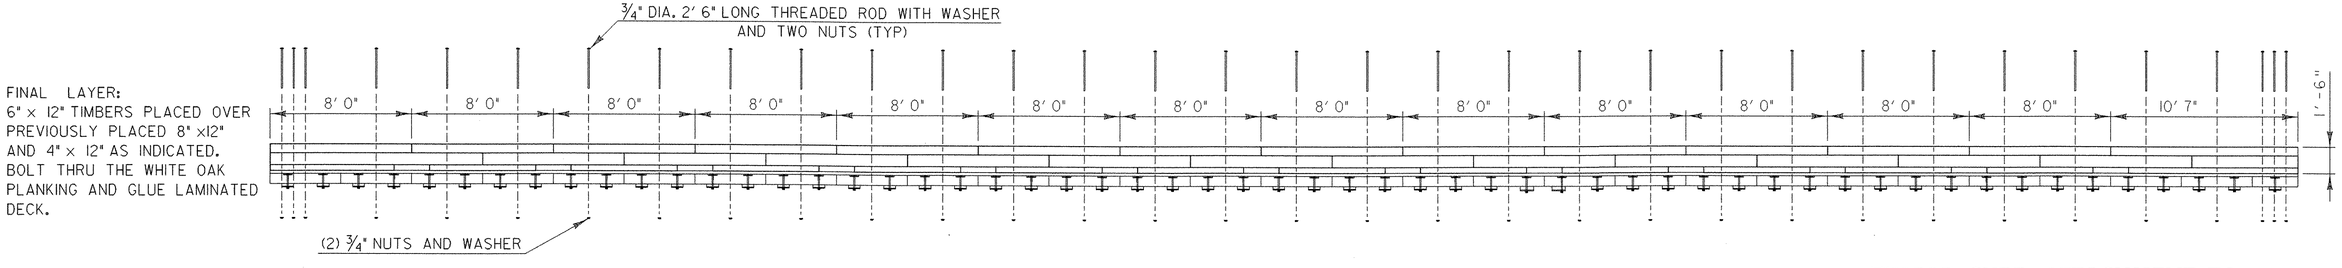

TIMBER CURB ASSEMBLY ELEVATION VIEW

SCALE 1/4"=1'

REVISED OCT. 24, 2006

TIMBER CURB ATTACHMENT TO DECK LAYOUT SHEET

PROJECT NAME:	THETFORD
PROJECT NUMBER:	BHO 1444 (43)
FILE NAME: Structures\s03j036abt.dgn	PLOT DATE: 24-OCT-2006
PROJECT LEADER: M.EVANS-MONGEON	DRAWN BY: G.ROKES
DESIGNED BY: M. EVANS-MONGEON	CHECKED BY: S. SCRIBNER
IPARM: s03j036tra.i	SHEET 33 OF 60