FED. ROAD REG. NO.	STATE	CONTRACT NO.	SHEET NO.	TOTAL SHEETS
1	N.Y.		29	43

COUNTY ROAD 18 OVER POULTNEY RIVER
WASHINGTON COUNTY, NY / RUTLAND COUNTY, VT
TOWN OF HAMPTON, NY / POULTNEY, VT
CAPITAL PROJECT IDENTIFICATION NO. 1753.76

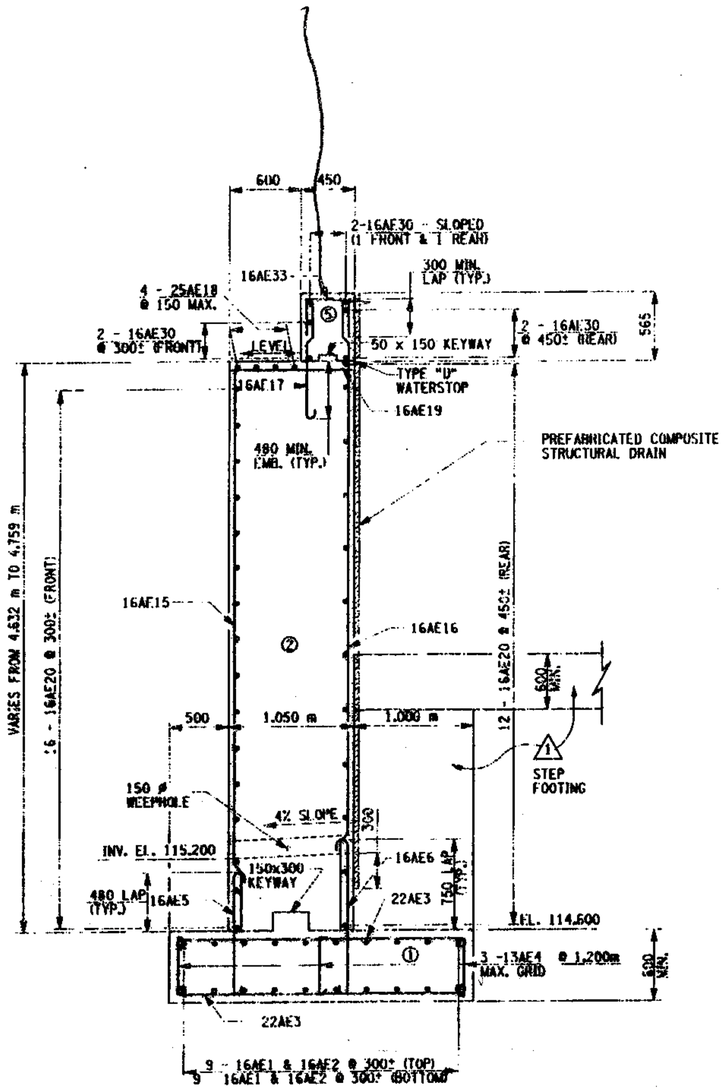

EAST ABUTMENT REINFORCEMENT
SECTION A-A

0 0.5 1.0 1.5 2.0 2.5 M
SCALE

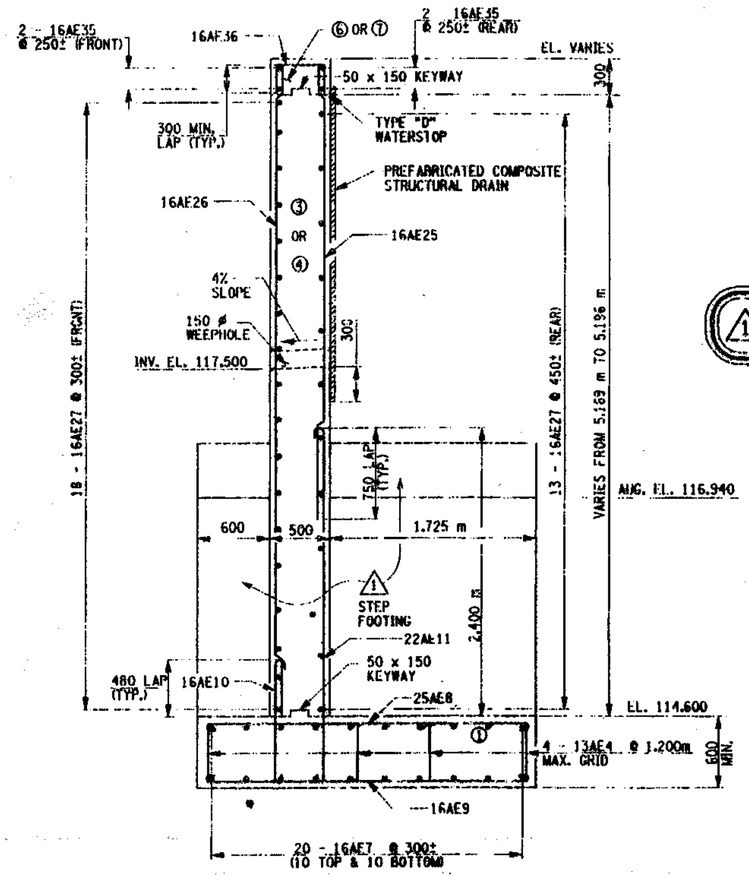

WINGWALL REINFORCEMENT
(TYPICAL)
SECTION B-B

0 0.5 1.0 1.5 2.0 2.5 M
SCALE

⚠1 AS BUILT: REVISIONS 9/2003

NOTES:

FOR LOCATION OF SECTIONS, SEE DWG. NO. ST-11.

FOR KEYWAY AND WATERSTOP DETAILS, SEE DWG. NO. ST-14.

ALL COVER SHALL BE 75 mm IN THE FOOTING AND 50 mm ELSEWHERE, UNLESS OTHERWISE NOTED.

ALL DIMENSIONS ARE IN mm UNLESS OTHERWISE NOTED

AS BUILT REVISIONS

SIGNATURE — DATE 9/2003

COUNTY ROAD 18 OVER POULTNEY RIVER

EAST ABUTMENT SECTION REINFORCEMENT

WASHINGTON COUNTY
DEPARTMENT OF PUBLIC WORKS

FILENAME	REGION	DATE	DRAWING NO.
1753/6AA.A1G	ONE	3/2002	ST-13

DESIGN SUPERVISOR TJC — JOB MANAGER TJC — DESIGNED BY EKT — DRAWN BY RJN — CHECKED BY LMK — ESTIMATED BY EKT — CHECKED BY EKT

FILE NAME = j:\work\12007\CADD\AsBuilts\17537ba.dgn
DATE/TIME = 11/04/2003 - 10:07:08 AM
USER = RJN