| FED ROAD REG. NO. | STATE | CONTRACT NO. | SHEET NO. | TOTAL SHEETS |
|---|---|---|---|---|
| 1 | N.Y. | | 31 | 43 |

COUNTY ROAD 18 OVER POULTNEY RIVER
WASHINGTON COUNTY, NY / RUTLAND COUNTY, VT
TOWN OF HAMPTON, NY / POULTNEY, VT
CAPITAL PROJECT IDENTIFICATION NO. 1753.76




TRANSVERSE SECTION

0 0.5 1.0 1.5 2.0 2.5 M

SCALE

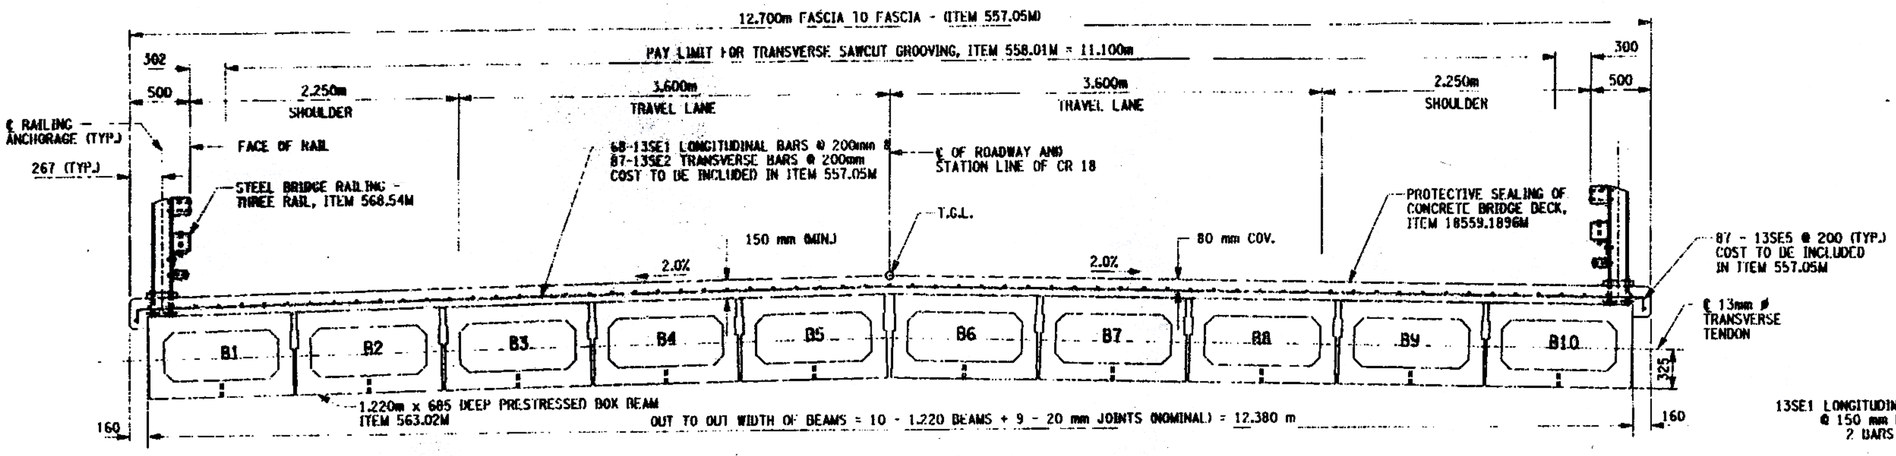


BEAM LAYOUT

0 1 2 3 4 5 M

SCALE

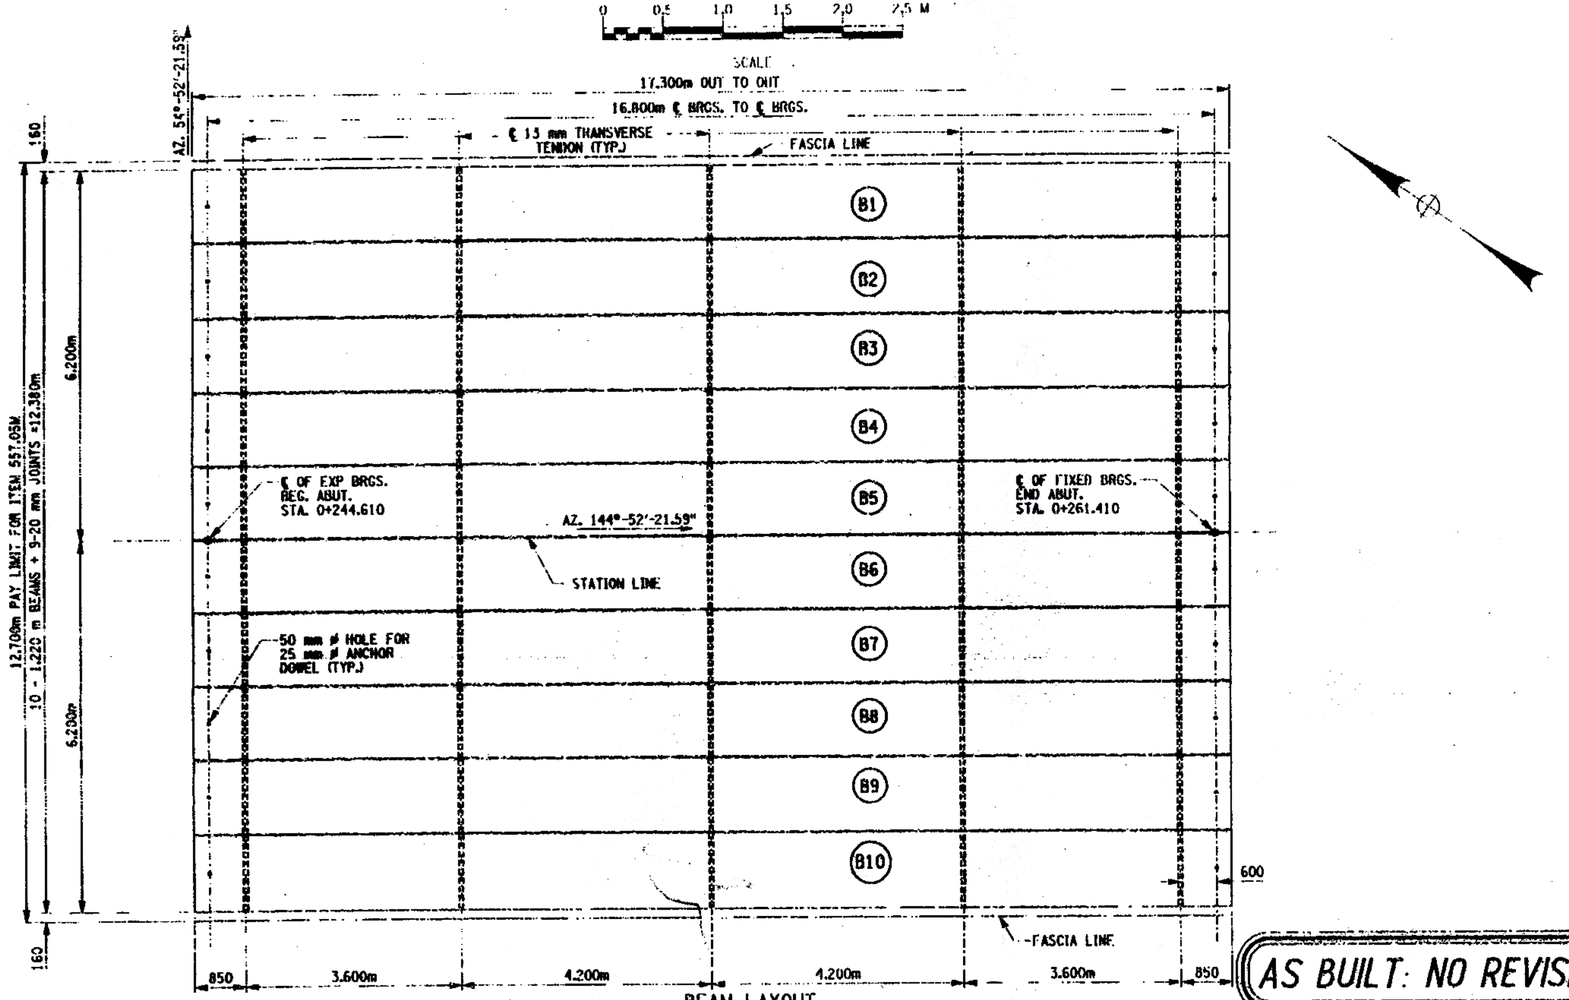


REINFORCEMENT DETAIL
FOR DECK OVERHANG
NOT TO SCALE




ELEVATION A-A
(SHOWING DRIP GROOVE DETAIL)
NOT TO SCALE

NOTE:
DRIP GROOVE RUNS PERPENDICULAR FROM THE FASCIA BEAM TO THE FASCIA.

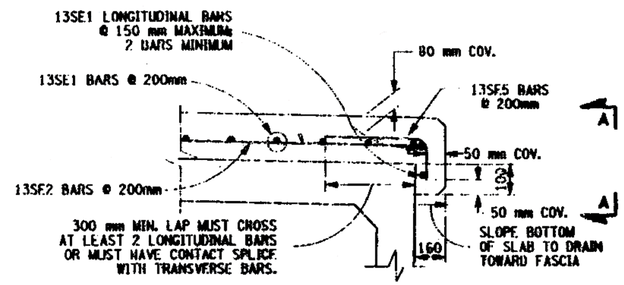ALL DIMENSIONS ARE IN mm UNLESS OTHERWISE NOTED

AS BUILT REVISIONS

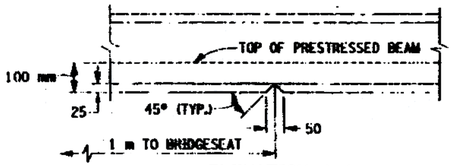Lawrence E. Stevens 9/2003
SIGNATURE DATE

AS BUILT: NO REVISIONS 9/2003

COUNTY ROAD 18 OVER POULTNEY RIVER

TRANSVERSE SECTION AND PRESTRESSED CONCRETE BEAM LAYOUT

WASHINGTON COUNTY
DEPARTMENT OF PUBLIC WORKS

EARTH TECH

| FILENAME | REGION | DATE | DRAWING NO. |
|---|---|---|---|
| 175376AA.T1A | ONE | 3/2002 | ST-15 |

DESIGNED BY EKT CHECKED BY LAK
DRAWN BY RAK
ESTIMATED BY EKT
DESIGN SUPERVISOR TJC JOB MANAGER TJC
FILE NAME = I:\work\V2007\CADD\Bridge\175376aa.tle
DATE/TIME = 12/4/2003 , 16:06:22 PM
USER = RJN