STATE OF VERMONT
AGENCY OF TRANSPORTATION

TRAFFIC SIGN SUMMARY SHEET

MILEMARKER, STATION, OR SIGN NUMBER	SIGN LEGEND	SIGN DIMENSIONS EA	WIDTH (in)	HEIGHT (in)	NEW & SALVAGED SIGNS "A"	"B"	SALV SIGN	SALV TIS	EXIST POST RETAIN	SALVAGE	NO. OF POSTS	FLANGED CHANNEL lb/ft 1.12	2.0	3.0	SQUARE STEEL (in) lb/ft 1.75	2.0	2.5	ANCHOR	SLEEVE	NEW SIGN POSTS: TUBULAR ALUMINUM O/(in) lb/ft 3.0	4.0	4.0 MOD	FOUNDATION	TUBULAR STEEL Ø (in) lb/ft 3.0	3.5	4.0	5.0	W-SHAPE STEEL FTG. SIZE 24"	30"	WEIGHT	POST SIZE	SIGN FRAME REQUIRED	REMARKS	SIGN DETAIL: DETAIL ON SHEET NUMBER	STD. SHEET NUMBER
												OPTION ITEMS							1.3	1.7	1.7		7.6	9.0	10.8	14.6								
W12-2		2	30"	30"	12.50						2			X																		STA. 100+55.00, RT. 12.0 STA. 103+15.00, LT. 12.0		E-155
W5-3		2	30"	30"	12.50						2			X																		STA. 100+25.00, RT. 12.0 STA. 103+45.00, LT. 12.0	33	SEE BELOW
VR-017		2	24"	30"	10.00																											STA. 100+55.00, RT. 12.0 STA. 103+15.00, LT. 12.0		E-141
R1-1		1	30"	30"	6.25						1			X																		STA. ~~101+15.00~~, RT. 12.0 101+09		E-143
R1-2		1	36"	36"	9.00						1			X																		STA. 102+85.00, LT. 12.0		E-146
												FT	FT	FT 96.5	FT	FT	FT		EA	LB	LB	LB		LB	LB	LB	LB							
	TOTALS				SF 50.25	SF	EA.	SF				FT 96.5			FT					LB			EA.	LB				EA.	EA.	LB				

FINAL POST LENGTHS ARE TO BE DETERMINED IN THE FIELD. POST SIZES ARE COMPUTED BASED ON INFORMATION FURNISHED ON THE STANDARD SHEETS AND THE ROADWAY TRAFFIC & SAFETY SECTION'S "SIGN POST DESIGN GUIDELINE."

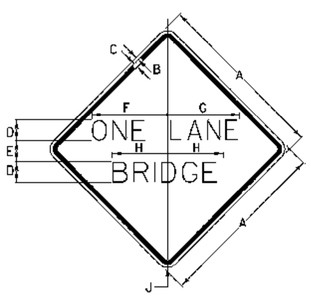

COLORS
LEGEND - BLACK (NON - REFL.)
BACKGROUND - YELLOW (REFL.)

SIGN	DIMENSIONS (INCHES) A	B	C	D	E	F	G	H	J
MIN.	30	1/2		5C	3 1/4	13 5/16	12 11/16	9 1/8	1 7/8
STD.	36	5/8		6C	4	16	15 1/4	11 1/2	2 1/4
SPECIAL	48		1 1/4	8C	5	21 1/4	20 1/4	15 3/8	3

MODEL
Untitled Sheet
HTA PROJECT NO.
904213

Hoyle, Tanner & Associates, Inc.

PROJECT NAME: FAIRFIELD
PROJECT NUMBER: BHO 1448(32)

FILE NAME: Z04J144TS.dgn
PROJECT LEADER: J.H.WEAVER
DESIGNED BY: J.BICJA
TRAFFIC SIGN SUMMARY

PLOT DATE: 4/25/2008
DRAWN BY: J.B.McQUAID
CHECKED BY: S.T.JAMES
SHEET 33 OF 36