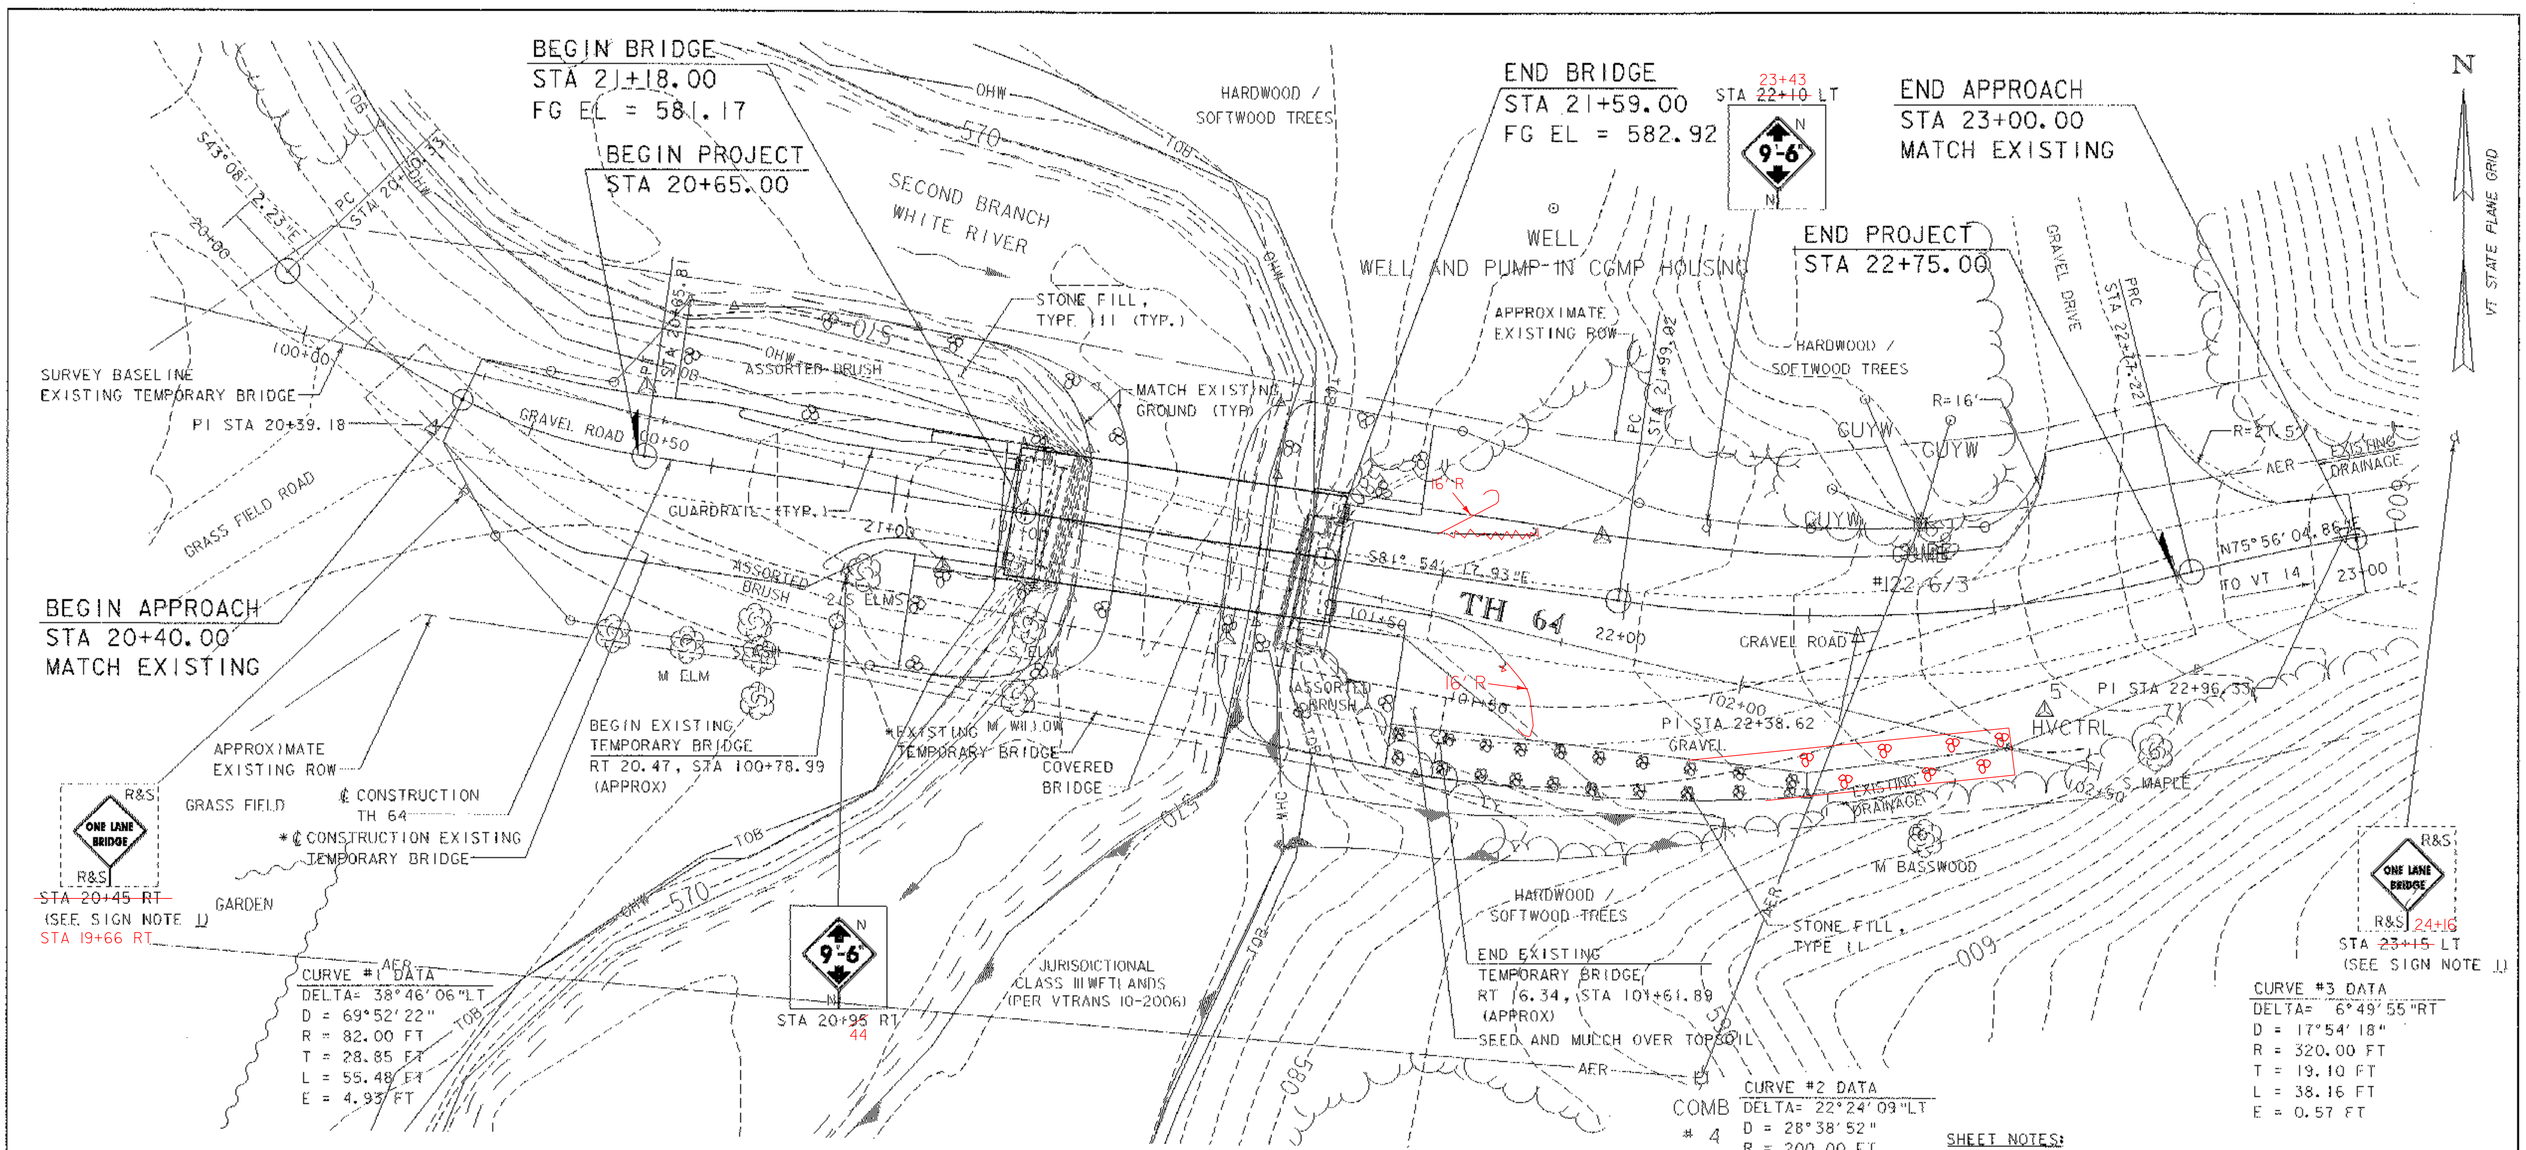

* SEE TEMPORARY BRIDGE AND APPROACHES NOTE ON SHEET 25.

PLAN

SCALE: 1:10

0 10 20

SCALE IN FEET

CONSTRUCTION NOTES

STEEL BEAM GUARDRAIL
(WITH ROUNDED W-BEAM END SECTIONS)

STA 20+79.40, 7.0 LT - STA 21+16.00, 5.5 LT
STA 20+92.20, 10.2 RT - STA 21+16.00, 5.5 RT
STA 21+61.00, 5.5 LT - STA 21+86.00, 7.0 LT REVISED AS SHOWN
STA 21+61.00, 5.5 RT - STA 21+84.80, 10.2 RT REVISED AS SHOWN

LANDSCAPING NOTES

1-SALIX NIGRA (HEIGHT 4' - 6') (BLACK WILLOW) STA 20+85.00, 24.0' RT
1-ACER SACCHARINUM (HEIGHT 4' - 6') (SILVER MAPLE) STA 20+65.00, 24.0' RT

TYPE III STONE FILL

STA 20+69.00 LT - STA 21+31.00 LT
STA 21+04.00 RT - STA 21+31.00 RT
STA 21+46.00 LT - STA 21+71.00 LT
STA 21+46.00 RT - STA 21+71.00 RT

TYPE II STONE FILL

STA 21+~~71~~ 77.00 RT - STA 22+~~25~~ 71.00 RT

SIGN LEGEND

N = NEW SIGN OR POST
S = SALVAGED SIGN OR POST
R&S = REMOVE AND SALVAGE SIGN OR POST

SHEET NOTES:

1. VARIABLE WIDTH TRAVEL WAY LINES NOT SHOWN FOR CLARITY. SEE CROSS SECTIONS FOR TRAVEL WAY AND SLOPE BREAK INFORMATION.

SIGN NOTES:

1. REMOVE AND SALVAGE EXISTING ONE LANE BRIDGE SIGNS PLACED DURING THE TEMPORARY BRIDGE CONTRACT. REINSTALL ONE AT EACH APPROACH AS DIRECTED BY THE RESIDENT ENGINEER FOR BEST SIGHT DISTANCE.
2. COST FOR REMOVAL OF SALVAGED SIGNS SHALL BE INCLUDED IN ITEM 675.50. COST FOR ERECTING SALVAGED SIGNS AND POSTS SHALL BE INCLUDED IN ITEMS 675.60 AND 675.61 RESPECTIVELY.

DATUM	
VERTICAL	NAVD88
HORIZONTAL	NAD 83(96)
ADJUSTMENT	Compass

VHB Vanasse Hangen Brustlin, Inc.

PROJECT NAME: RANDOLPH
PROJECT NUMBER: BHO 1444 (44)

FILE NAME: z04J146plansht.dgn
PROJECT LEADER: S. HODGDON
DESIGNED BY: K. ZIENKIEWICZ
PLAN SHEET

PLOT DATE: 26-JUN-2007
DRAWN BY: K. WENTWORTH
CHECKED BY: S. HODGDON
SHEET 9 OF 39