


PLAN

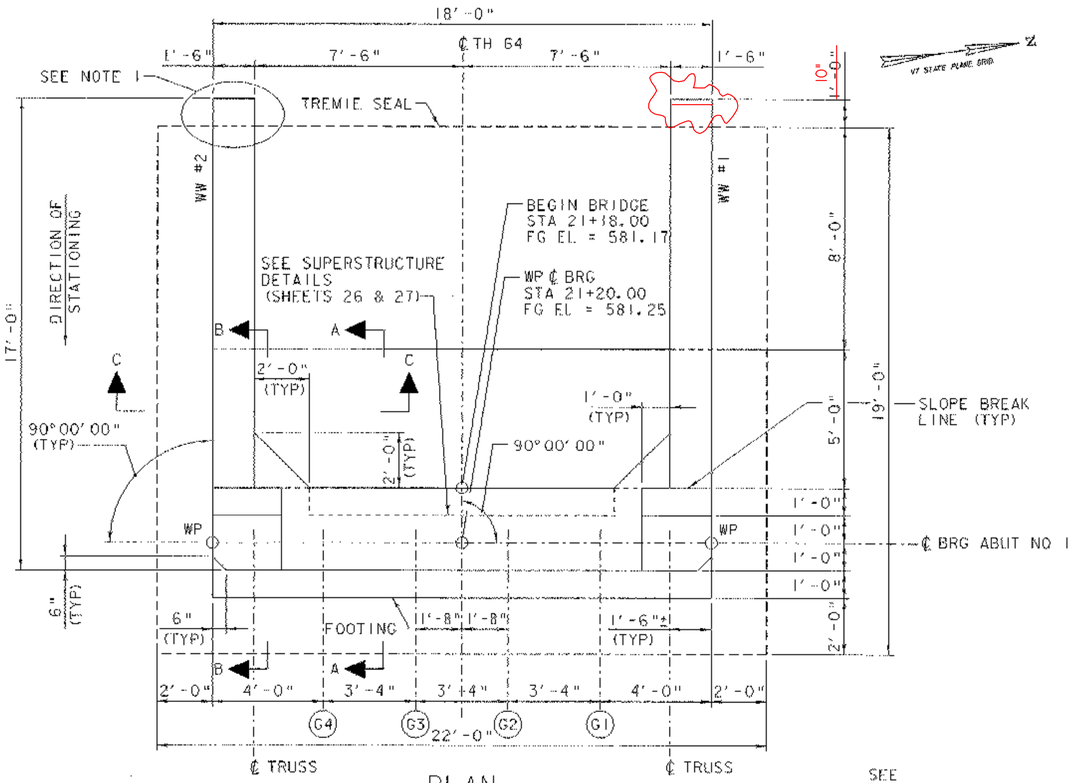


SECTION A-A
(TREMIE SEAL NOT SHOWN)




SECTION B-B
(TREMIE SEAL NOT SHOWN)

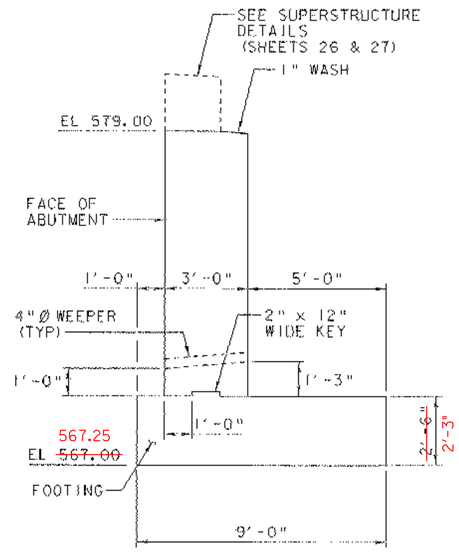


SECTION C-C
(TREMIE SEAL NOT SHOWN)

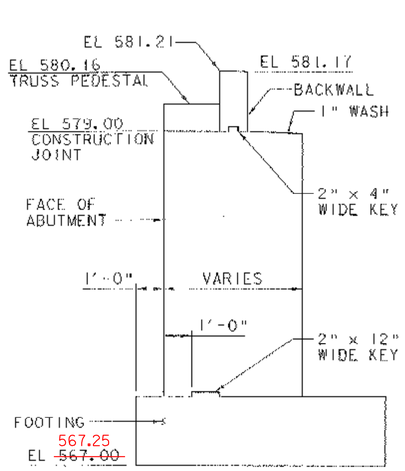


SECTION D-D

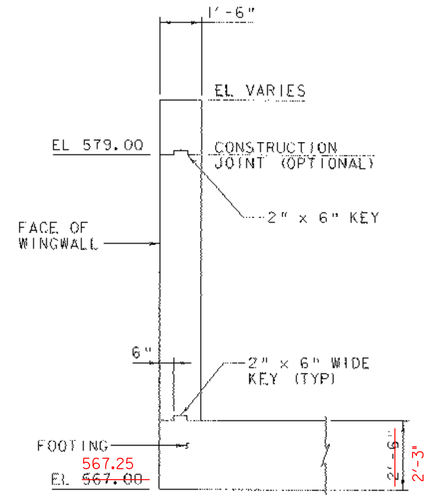


ELEVATION

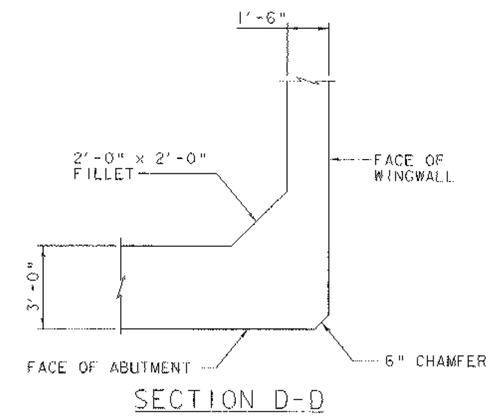


WINGWALL #1 ELEVATION
(WINGWALL #2 SIMILAR, OPPOSITE HAND)

NOTE:
1. CONTRACTOR MAY ADJUST TREMIE SEAL CONFIGURATION SLIGHTLY AT THE ENDS OF WINGWALL 1 AND 3 TO ACCOMMODATE SHEETING REMOVAL AT NO ADDITIONAL COST TO THE AGENCY.

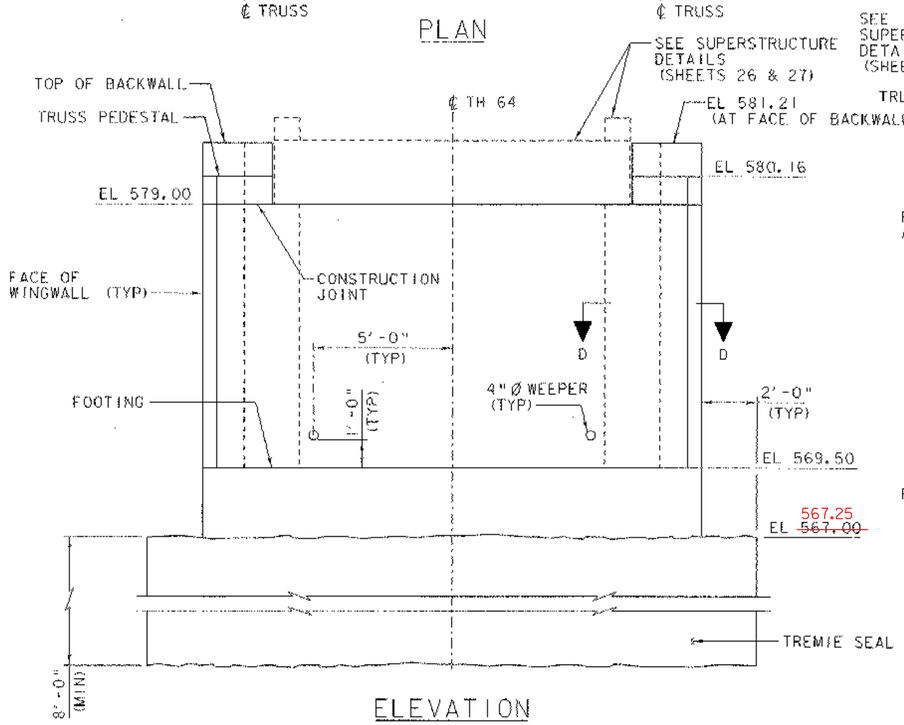SCALE 3/8" = 1'-0"
1 0 1 2 3 4

VHB Vanasse Hangen Brustlin, Inc.
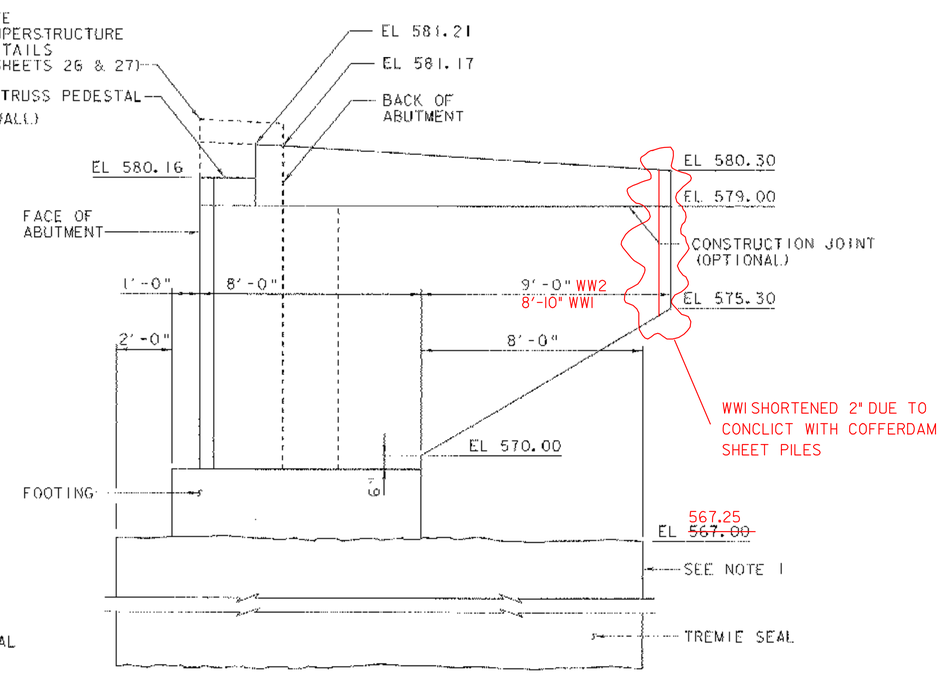
| | |
|---|---|
| PROJECT NAME: RANDOLPH | |
| PROJECT NUMBER: BHO 1444 (44) | |
| FILE NAME: z04j146abut1.dgn | PLOT DATE: 26-JUN-2007 |
| PROJECT LEADER: S. HODGDON | DRAWN BY: K. WENTWORTH |
| DESIGNED BY: S. HODGDON | CHECKED BY: K. ZIENKIEWICZ |
| ABUTMENT NO 1 DETAILS SHEET | SHEET 33 OF 39 |