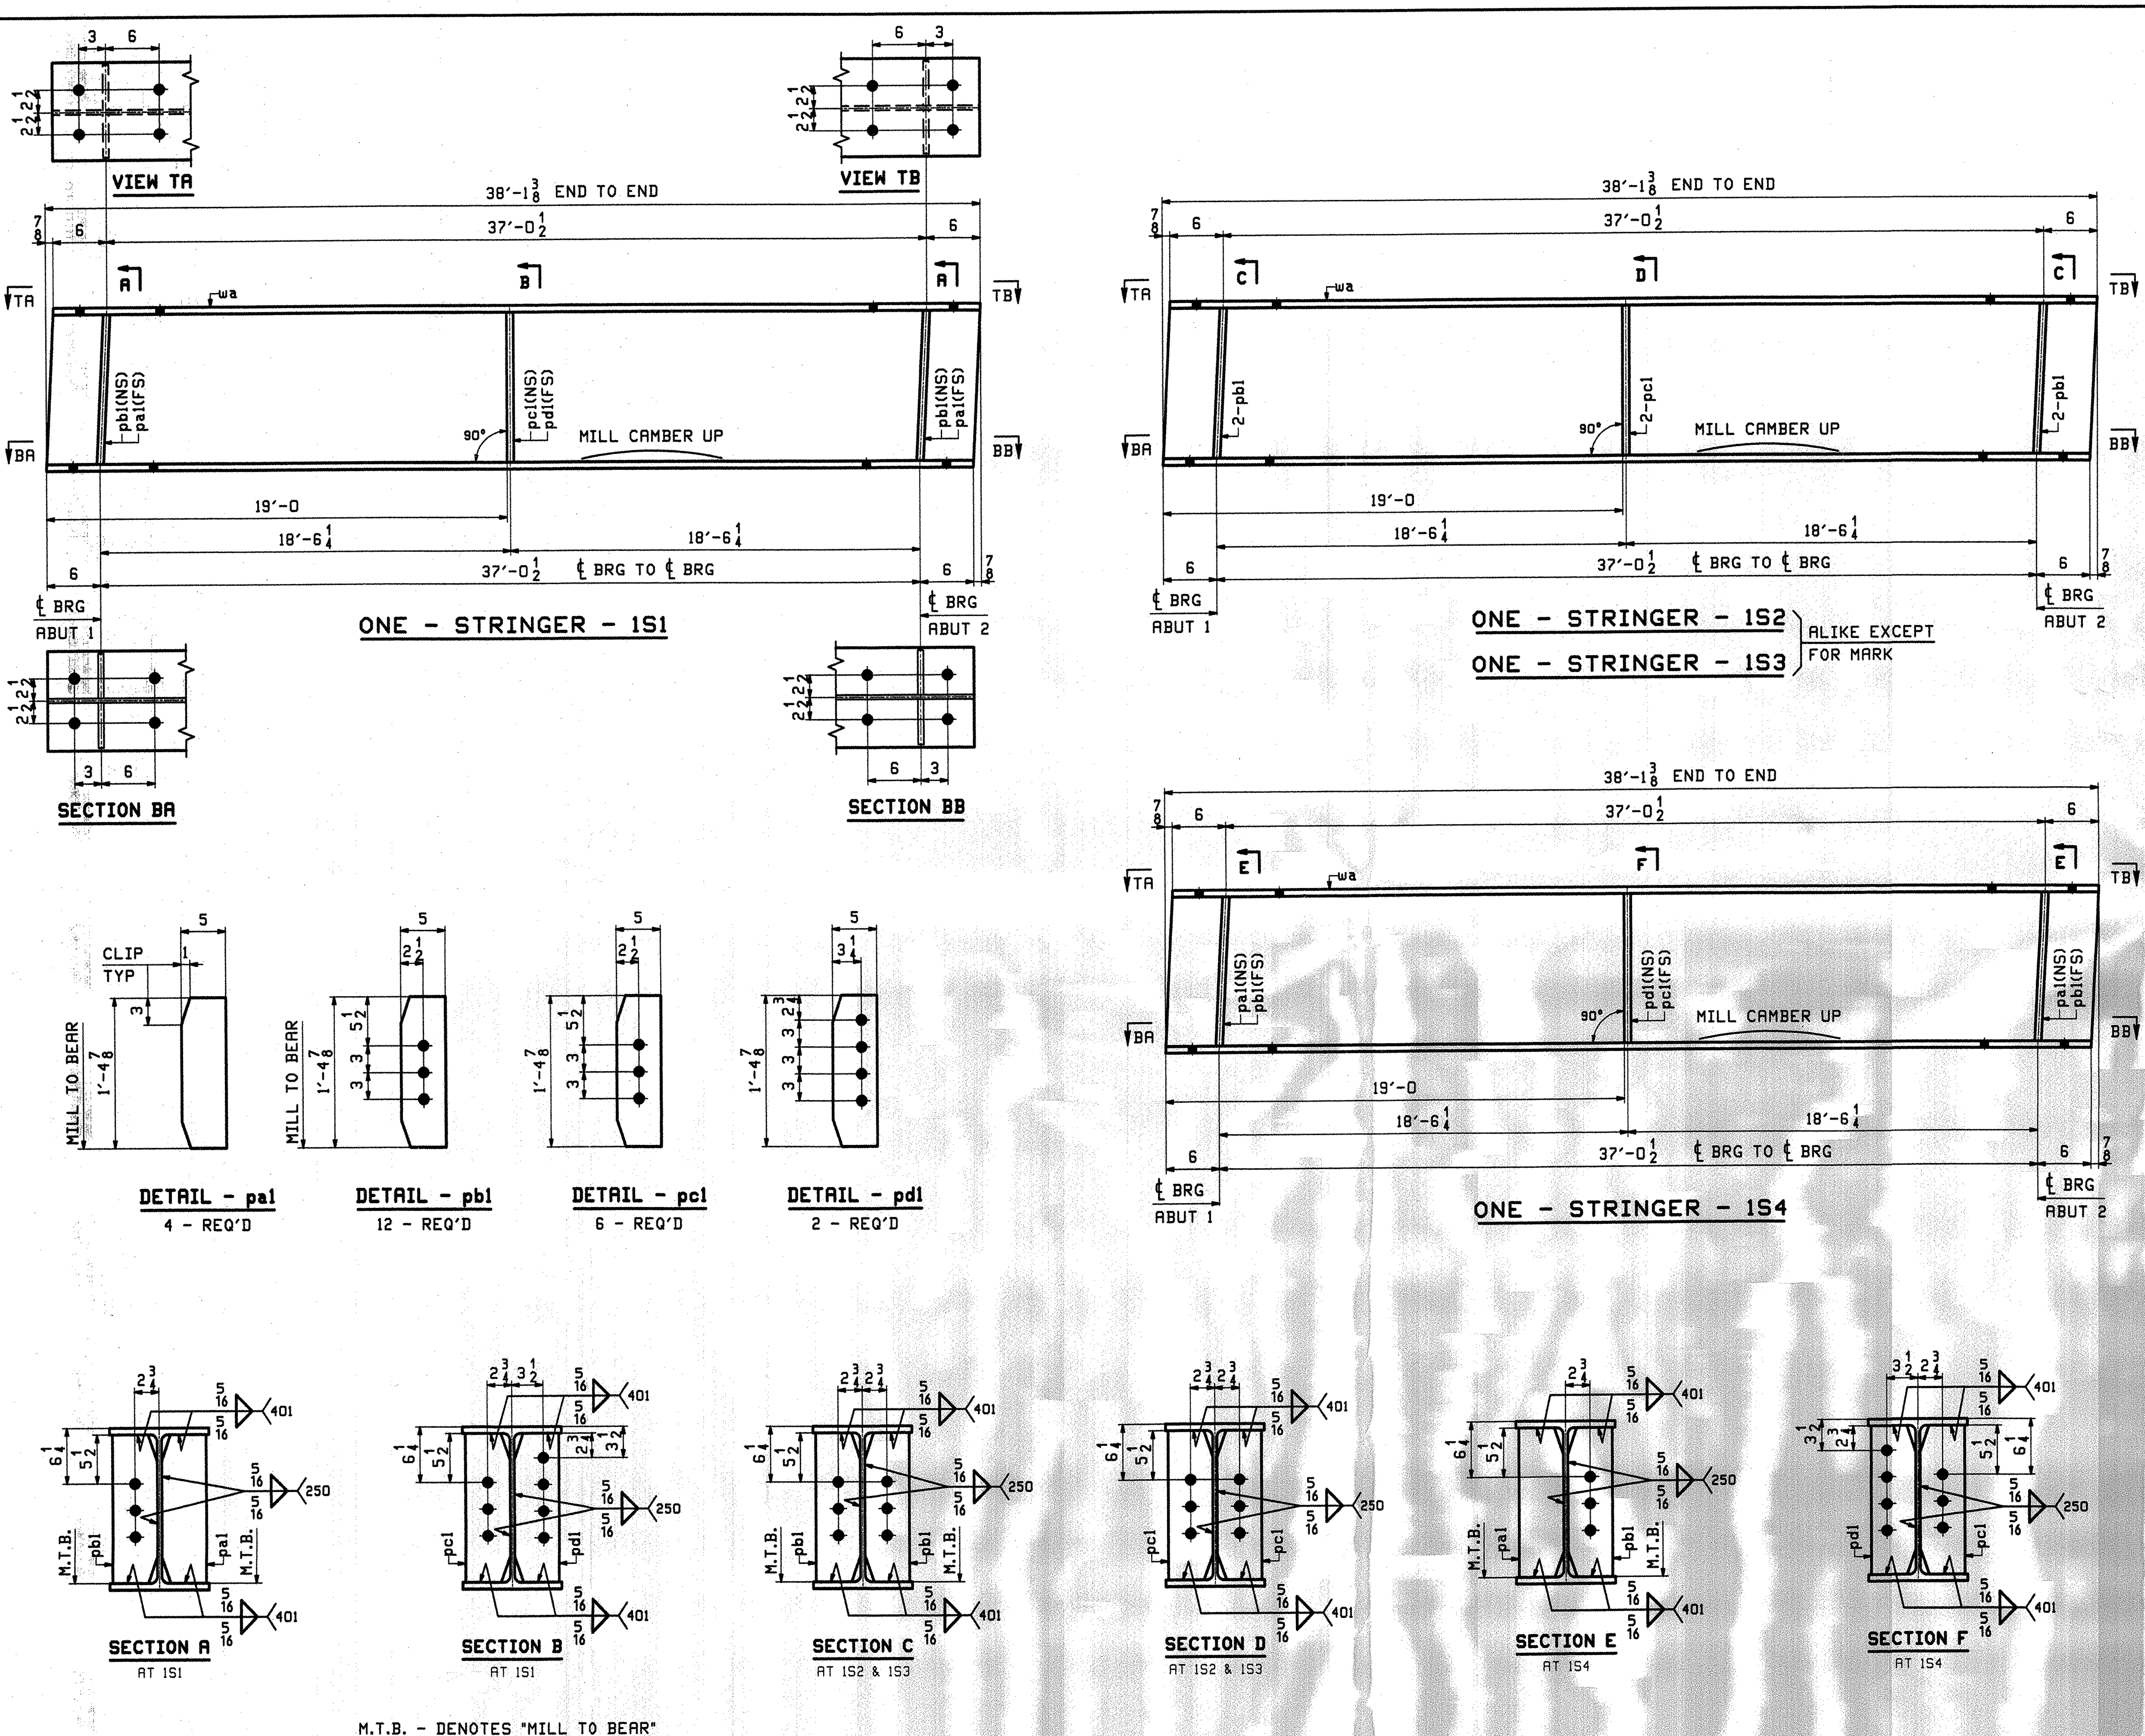

BILL OF MATERIAL

ABM INFO		SHIP								
PAGE	LINE	MARK	QTY	MARK	MATERIAL	LENGTH FT	LENGTH INCHES	REMARKS	WT	PROCUREMENT NOTES
		1S1	1		STRINGER				3350	
1	B		1	wa	W 18x86	38	1 3/8	(A709-50T2) (H2-3)		
1	E		2	pa1	PL 1/2x5	1	4 7/8	M1E		
1	E		2	pb1	PL 1/2x5	1	4 7/8	M1E		
1	E		1	pc1	PL 1/2x5	1	4 7/8			
1	E		1	pd1	PL 1/2x5	1	4 7/8			
		1S2	1		STRINGER				3350	
		1S3	1		STRINGER				3350	
1	B		2	wa	W 18x86	38	1 3/8	(A709-50T2) (H2-3)		
1	E		8	pb1	PL 1/2x5	1	4 7/8	M1E		
1	E		4	pc1	PL 1/2x5	1	4 7/8			
		1S4	1		STRINGER				3350	
1	B		1	wa	W 18x86	38	1 3/8	(A709-50T2) (H2-3)		
1	E		2	pa1	PL 1/2x5	1	4 7/8	M1E		
1	E		2	pb1	PL 1/2x5	1	4 7/8	M1E		
1	E		1	pc1	PL 1/2x5	1	4 7/8			
1	E		1	pd1	PL 1/2x5	1	4 7/8			

JOB NO. 340 — DRAWING NO. 1 — REV. ⚠1

⚠1 MATERIAL LISTED ABOVE INCLUDED IN CONTRACT ITEM 506.50, STRUCTURAL STEEL, ROLLED BEAM.

SHOP DRAWING REVIEW

☑ REVIEWED AS REQUIRED BY THE CONSTRUCTION CONTRACT DOCUMENTS AND APPROVED, BUT ONLY FOR CONFORMANCE TO THE DESIGN CONCEPT OF THE WORK, AND SUBJECT TO FURTHER LIMITATIONS AND REQUIREMENTS CONTAINED IN THE CONSTRUCTION CONTRACT DOCUMENTS.

☐ REJECTED ☐ REVISE AND RESUBMIT ☐ FURNISH AS CORRECTED

CORRECTIONS OR COMMENTS MADE ON THE SHOP DRAWINGS DURING THIS REVIEW DO NOT RELIEVE CONTRACTOR FROM COMPLIANCE WITH REQUIREMENTS OF THE DRAWINGS AND SPECIFICATIONS. THIS CHECK IS ONLY FOR REVIEW OF GENERAL CONFORMANCE WITH THE DESIGN CONCEPT OF THE PROJECT AND GENERAL COMPLIANCE WITH THE INFORMATION GIVEN IN THE CONTRACT DOCUMENTS. THE CONTRACTOR IS RESPONSIBLE FOR: CONFIRMING AND CORRELATING ALL QUANTITIES AND DIMENSIONS; SELECTING FABRICATION PROCESSES AND TECHNIQUES OF CONSTRUCTION; COORDINATING HIS WORK WITH THAT OF ALL OTHER TRADES; AND PERFORMING HIS WORK IN A SAFE AND SATISFACTORY MANNER.

VHB Vanasse Hangen Brustlin, Inc. Engineers, Planners, and Scientists, Six Bedford Farms, Kilton Rd. Bedford, NH 03110 603 644 0888

Job Number: 51752
Reviewed By: S. HODGDON
Date: 12-12-07

NOTES:

1. FOR GENERAL NOTES SEE DRAWING GN1.
2. CVN DENOTES MATERIAL SUBJECT TO CHARPY V-NOTCH TESTING.
3. ALL MATERIAL ON THIS DRAWING SHALL BE GALVANIZED AND PAINTED PER DRAWING GN1.

Approved 10/23/07

REV.	DATE	REMARKS	DWN	CHK	APVL	SHOP
					10/8/07	
⚠1	11/06/07	APPROVAL COMMENTS	JTB	DBH		
0					11/8/07	11/8/07

MATERIAL:	SURFACE PREP. & PAINT:	HOLES:	SHOP BOLTS:
A709-50 (UN)	SEE DWG GN1	15/16"Ø	NONE

DESCRIPTION: STRINGERS

CASCO BAY STEEL STRUCTURES, INC.
75 SPRING HILL ROAD, SACO, MAINE 04072
PHONE (207) 282-7360 FAX. (207) 282-1179
TENSOR 2744

STRUCTURE:	REHAB. OF BRALEY COVERED BRIDGE TH 64 (CLASS 111 - LOCAL ROAD) BRIDGE NO. 38	DRAWN: JTB CHKD: DBH	DATE: 09/24 DATE: 10/04
LOCATION:	TOWN OF RANDOLPH, VERMONT	JOB NO.	DWG NO.
PROJ NO.	BHO 1444(44)	340	1
CUSTOMER:	VERMONT A.O.T.		REV. ⚠1

057-55