STATE OF VERMONT
AGENCY OF TRANSPORTATION

TRAFFIC SIGN SUMMARY SHEET

LOCATION	SIGN LEGEND	SIGN DIMENSIONS EA	WIDTH (in)	HEIGHT (in)	NEW & SALVAGED SIGNS "A"	"B"	SALV SIGN	SALV TIS	EXIST POST RETAIN	SALVAGE	NO. OF POSTS	FLANGED CHANNEL lb/ft 1.12	2.0	3.0	SQUARE STEEL (in) 1.75 lb/ft 1.88	2.0 lb/ft 2.16	2.5 lb/ft 3.35	ANCHOR	SLEEVE	TUBULAR ALUMINUM Ø (in) 3.0 lb/ft 1.3	4.0 lb/ft 1.7	4.0 MOD lb/ft 1.7	FOUND-ATION	TUBULAR STEEL Ø (in) 3.0 lb/ft 7.6	3.5 lb/ft 9.0	4.0 lb/ft 10.8	5.0 lb/ft 14.6	W-SHAPE STEEL FTG. SIZE 24"	30"	WEIGHT	POST SIZE	SIGNS REQUIRED	REMARKS	SIGN DETAIL DETAIL ON SHEET NUMBER	STD. SHEET NUMBER
												OPTION ITEMS																								
1+09 RT STA. ~~1+15.00~~ 10' RIGHT & STA.3+00.00 12.5' LEFT	ONE LANE BRIDGE	2	30	30	6.25						2			x																				W5 - 3	31	SEE BELOW
STA.1+65.00 9.5' RIGHT & STA.2+75.00 15' LEFT	9'-5"	2	30	30	6.25						2			x																				*** W12 2	X	E-155
	LEGAL LOAD LIMIT 16,000 POUNDS	2	24	30	5.00																													*** VR - 017	X	E-141

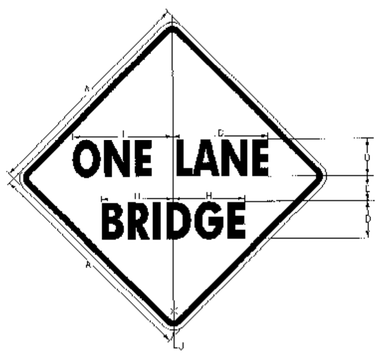

SIGN	A	B	C	D	E	F	G	H	J
	DIMENSIONS (INCHES)								
MIN.	30	1/2	3/4	5C	3 1/4	13 5/16	12 11/16	9 1/8	1 7/8
STD.	36	5/8	7/8	6C	4	16	15 1/4	11 1/2	2 1/4
SPECIAL	48	3/4	1 1/4	8C	5	21 1/4	20 1/4	15 3/8	3

COLORS
LEGEND-BLACK (NON - REFL)
BACKGROUND - YELLOW (REFL)

*** THESE SIGNS SHALL OCCUPY THE SAME POST.

NOTE: SIGNS AND POSTS SHOWN ON THIS SHEET SHALL BE PAID FOR UNDER ITEM 675.20, TRAFFIC SIGNS, TYPE A, AND ITEM 675.301, FLANGED CHANNEL SIGN POST.

FINAL POST LENGTHS ARE TO BE DETERMINED IN THE FIELD. POST SIZES ARE COMPUTED BASED ON INFORMATION FURNISHED ON THE STANDARD SHEETS AND THE ROADWAY TRAFFIC & SAFETY DIVISION'S "SIGN POST DESIGN GUIDELINE."

	SF	SF	EA.	SF	FT	FT	FT	FT	FT	FT	EA	LB	LB	LB	LB	LB	LB	LB	EA.	EA.	LB
TOTALS	35.0				44																

PROJECTS: MONTGOMERY | BHO 1448 (37)

DESIGN FILE NAME: 04J148\Str\s04J148tss.dgn
IPARM FILE NAME: s04J148tss.i
DESIGNED BY: J. WEAVER

TRAFFIC SIGN SUMMARY SHEET

PLOT DATE: 21-MAY-2008
DRAWN BY: C. WEEKER
CHECKED BY: J. WEAVER
SHEET: 31 OF 33