INDEX OF SHEETS

1. TITLE SHEET
2. LOCATION MAPS SHEET
3. GENERAL NOTES SHEET
4. BRIDGE INFORMATION SHEET
5. QUANTITIY SHEET
6-7. DETAIL SHEETS
8. TRAFFIC SIGN SUMMARY SHEET
9. EROSION PREVENTION & SEDIMENT CONTROL DETAILS, SILT FENCE

VAOT STANDARD SHEETS

E - 100A	SIDE ROAD CONSTRUCTION APPROACH SIGNS	- 1/02/04
E - 102	CONSTRUCTION SIGN DETAILS	- 6/30/03
E - 102A	CONSTRUCTION SIGN DETAILS	- 5/01/04
E - 107	DELINEATION, BARRICADES AND DETOURS...	- 6/30/03
E - 107A	BREAKAWAY BARRICADE DETAILS	- 8/08/95
E - 121	STANDARD SIGN PLACEMENT-CONVENTIONAL ROAD	- 8/08/95
E - 146	REGULATORY SIGN DETAILS	- 9/20/95
E - 155	WARNING SIGN DETAILS	- 5/01/04
E - 160	FLANGED CHANNEL SIGN POST	- 5/20/99
G - 1	STEEL BEAM GUARDRAIL WITH STEEL POSTS	- 1/03/00
T - 2	TEMPORARY EROSION CONTROL DETAILS	- 6/01/94

STATE OF VERMONT
AGENCY OF TRANSPORTATION

PROPOSED IMPROVEMENT
BRIDGE PROJECTS

NORTHERN REGION

STOWE BHO	1446 (32)
WATERVILLE BHO	1448 (33)
WATERVILLE BHO	1448 (34)
BELVIDERE BHO	1448 (35)
ENOSBURG BHO	1448 (36)

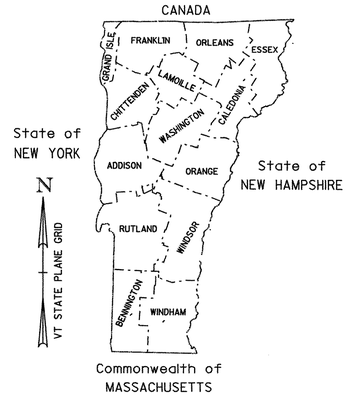

PROJECT DESCRIPTION

REHABILITATING EXISTING STONE ABUTMENTS AND WINGWALLS, CUTTING/TRIMMING, PROVIDING APPROACH RAILINGS, SIGNS, AND FIRE RETARDANT. OTHER MISCELLANEOUS WORK.

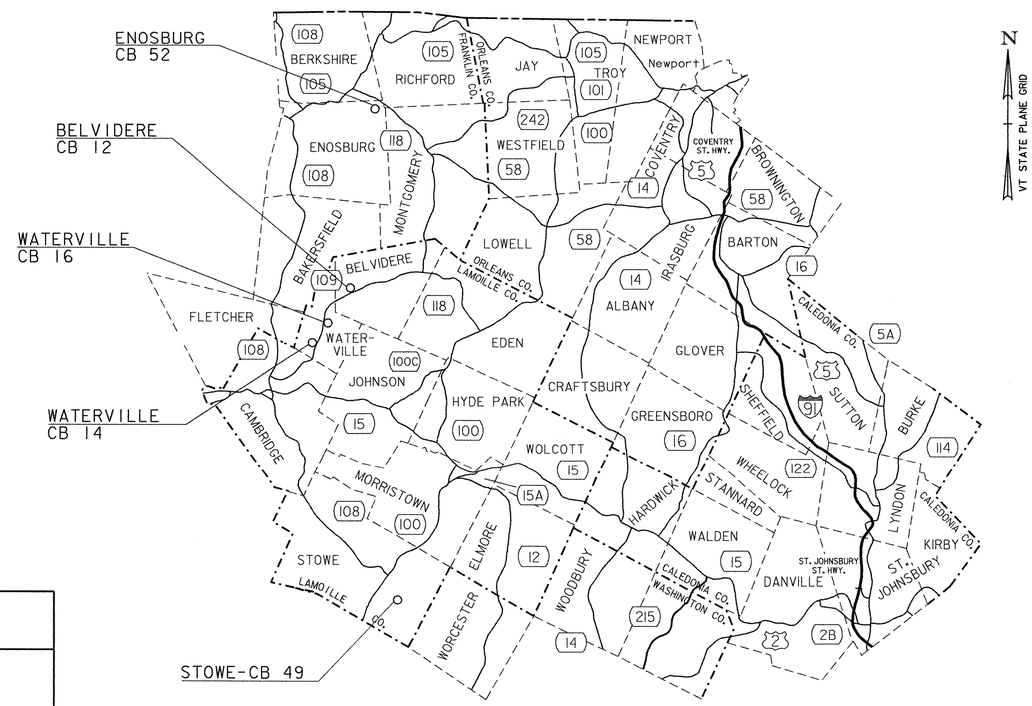

CONVENTIONAL SYMBOLS

COUNTY LINE	COUNTY LINE
TOWN LINE	TOWN LINE
LIMITS OF ACCESS	
POINT OF ACCESS	X
FENCE LINE	
STONE WALL	
TRAVELED WAY	
GUARD RAIL	
RAILROAD	
SURVEY LINE	
CULVERT	
POWER POLE	
TELEPHONE POLE	
TREES	
CONTROL OF ACCESS	
PROPERTY LINE	
R.O.W. TAKING LINE	
SLOPE RIGHTS	SR SR SR
TOP OF CUT	
TOE OF SLOPE	

SURVEYED BY :

SURVEYED DATE :

DATUM

VERTICAL

HORIZONTAL

RECORD PLANS

CONTRACTOR: BLOW & COTE - MORRISVILLE, VT

RESIDENT ENGINEER: JEFF COTA

CONSTRUCTION BEGAN: JUNE 3, 2005

CONSTRUCTION COMPLETE: SEPTEMBER 30, 2005

RECORD PLANS BY: JEFF C OTA

I HEREBY CERTIFY THAT ALL THE CONSTUCTION REQUIRED BY THIS SET OF DRAWINGS HAS BEEN ACCOMPLISHED AS INDICATED HEREIN.

BY _____ RESIDENT ENGINEER

DATE 2/27/08

NOTE: Any further information concerning final quantities, amounts or other details relative to this project may be found at Central Files in the electronic archives.

BUILT AS DESIGNED

THESE PLANS ARE SUBJECT TO SUCH ENGINEERING CHANGES AS MAY BE REQUIRED BY THE FEDERAL HIGHWAY ADMINISTRATION OR THE DIRECTOR OF PROGRAM DEVELOPMENT.

CONSTRUCTION IS TO BE CARRIED ON IN ACCORDANCE WITH THESE PLANS AND THE STANDARD SPECIFICATIONS FOR CONSTRUCTION DATED 2001, AS APPROVED BY THE FEDERAL HIGHWAY ADMINISTRATION ON JANUARY 4, 2001 FOR USE ON THIS PROJECT, INCLUDING ALL SUBSEQUENT REVISIONS AND SUCH REVISED SPECIFICATIONS AND SPECIAL PROVISIONS AS ARE INCORPORATED IN THESE PLANS.

DEPARTMENT OF TRANSPORTATION
FEDERAL HIGHWAY ADMINISTRATOR

APPROVED _____ DATE _____

DIRECTOR OF PROGRAM DEVELOPMENT

APPROVED _____ DATE _____

PROJECT MANAGER : J. WEAVER

PROJECTS : NORTHERN REGION

SHEET 1 OF 9 SHEETS