INDEX OF SHEETS

1. TITLE SHEET
2. LOCATION MAPS SHEET
3. GENERAL NOTES SHEET
4. BRIDGE INFORMATION SHEET
5. QUANTITIY SHEET
6. DETAIL SHEET
7. TRAFFIC SIGN SUMMARY SHEET
8. EROSION PREVENTION & SEDIMENT CONTROL DETAILS, SILT FENCE

VAOT STANDARD SHEETS

E - 100A	SIDE ROAD CONSTRUCTION APPROACH SIGNS	- 1/02/04
E - 102	CONSTRUCTION SIGN DETAILS	- 6/30/03
E - 102A	CONSTRUCTION SIGN DETAILS	- 5/01/04
E - 107	DELINEATION, BARRICADES AND DETOURS...	- 6/30/03
E - 107A	BREAKAWAY BARRICADE DETAILS	- 8/08/95
E - 121	STANDARD SIGN PLACEMENT-CONVENTIONAL ROAD	- 8/08/95
E - 146	REGULATORY SIGN DETAILS	- 9/20/95
E - 155	WARNING SIGN DETAILS	- 5/01/04
E - 160	FLANGED CHANNEL SIGN POST	- 5/20/99
G - 1	STEEL BEAM GUARDRAIL WITH STEEL POSTS	- 1/03/00
T - 2	TEMPORARY EROSION CONTROL DETAILS	- 6/01/94

STATE OF VERMONT

AGENCY OF TRANSPORTATION

PROPOSED IMPROVEMENT

BRIDGE PROJECTS

SOUTHERN REGION

WOODSTOCK BHO 1444(45)
WEST WINDSOR BHO 1444(46)
WEST WINDSOR BHO 1444(47)

PROJECT DESCRIPTION

REHABILITATING EXISTING STONE ABUTMENTS AND WINGWALLS, CUTTING/TRIMMING, PROVIDING APPROACH RAILINGS, SIGNS, AND FIRE RETARDANT. OTHER MISCELLANEOUS WORK.

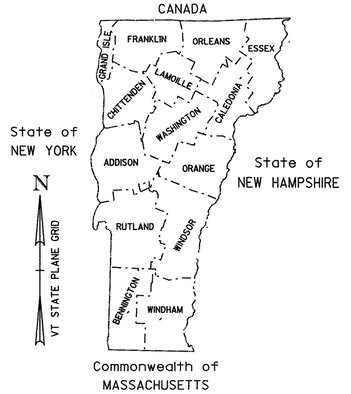

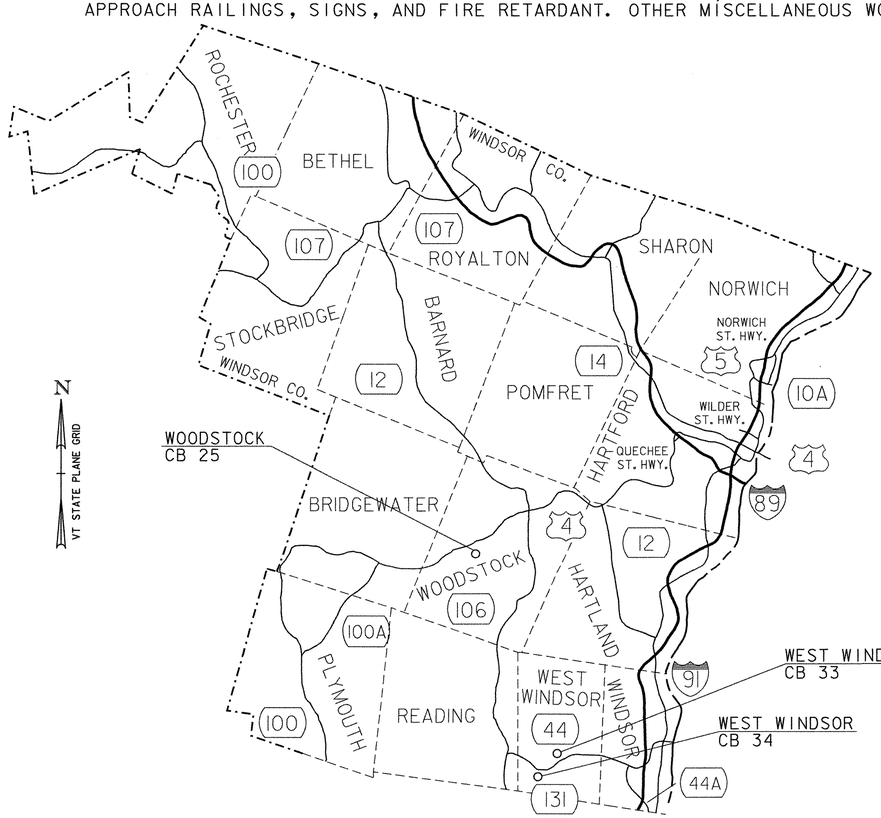

RECORD PLANS

CONTRACTOR: BLOW & COTE INC. – MORRISVILLE, VT
RESIDENT ENGINEER: BUTCH COLBY
CONSTRUCTION BEGAN: JUNE 22, 2005
CONSTRUCTION COMPLETE: SEPTEMBER 28, 2005
RECORD PLANS BY: BUTCH COLBY

I HEREBY CERTIFY THAT ALL THE CONSTUCTION REQUIRED BY THIS SET OF DRAWINGS HAS BEEN ACCOMPLISHED AS INDICATED HEREIN.

BY _____ RESIDENT ENGINEER

DATE 4/19/07

NOTE: Any further information concerning final quantities, amounts or other details relative to this project may be found at Central Files in the electronic archives.

CONVENTIONAL SYMBOLS

COUNTY LINE
TOWN LINE
LIMITS OF ACCESS
POINT OF ACCESS
FENCE LINE
STONE WALL
TRAVELED WAY
GUARD RAIL
RAILROAD
SURVEY LINE
CULVERT
POWER POLE
TELEPHONE POLE
TREES
CONTROL OF ACCESS
PROPERTY LINE
R.O.W. TAKING LINE
SLOPE RIGHTS
TOP OF CUT
TOE OF SLOPE

SURVEYED BY :
SURVEYED DATE :

DATUM
VERTICAL
HORIZONTAL

THESE PLANS ARE SUBJECT TO SUCH ENGINEERING CHANGES AS MAY BE REQUIRED BY THE FEDERAL HIGHWAY ADMINISTRATION OR THE DIRECTOR OF PROGRAM DEVELOPMENT.

CONSTRUCTION IS TO BE CARRIED ON IN ACCORDANCE WITH THESE PLANS AND THE STANDARD SPECIFICATIONS FOR CONSTRUCTION DATED 2001, AS APPROVED BY THE FEDERAL HIGHWAY ADMINISTRATION ON JANUARY 4, 2001 FOR USE ON THIS PROJECT, INCLUDING ALL SUBSEQUENT REVISIONS AND SUCH REVISED SPECIFICATIONS AND SPECIAL PROVISIONS AS ARE INCORPORATED IN THESE PLANS.

BUILT AS DESIGNED

DEPARTMENT OF TRANSPORTATION
FEDERAL HIGHWAY ADMINISTRATOR
APPROVED _____ DATE _____

DIRECTOR OF PROGRAM DEVELOPMENT
APPROVED _____ DATE _____

PROJECT MANAGER : J. WEAVER

PROJECTS : SOUTHERN REGION

SHEET 1 OF 8 SHEETS