STATE OF VERMONT
AGENCY OF TRANSPORTATION

TRAFFIC SIGN SUMMARY SHEET

MILEMARKER, STATION, OR SIGN NUMBER	SIGN LEGEND	SIGN DIMENSIONS			NEW & SALVAGED SIGNS				EXIST POST		NEW SIGN POSTS																				REMARKS	STD. SHEET NUMBER
											NO. OF POSTS	FLANGED CHANNEL			12 GUAGE SQUARE STEEL (in.)			ANCHOR	SLEEVE	TUBULAR ALUMINUM dia. (in.)			FOUNDATION	TUBULAR STEEL dia. (in.)				W-SHAPE STEEL FTG. SIZE		WEIGHT	POST SIZE	SIGN FRAME REQUIRED		
		EA	WIDTH (in.)	HEIGHT (in.)	"A"	"B"	SALV SIGN	SALV TIS	RETAIN	SALVAGE		lb/ft			1.75	2.0	2.5			3.0	4.0	4.0 MOD.		3.0	3.5	4.0	5.0	24"	30"					
												1.12	2.0	3.0	1.88	2.42	3.35			1.3	1.7	1.7		7.6	9.0	10.8	14.6							
											OPTION ITEMS																									
SIGNAL ASSEMBLY G1 STA. 3+63, RT. COMSTOCK ROAD		2	48	9	6																											REQUIRES SHEETING ON BOTH FRONT AND BACK INSTEAD OF JUST RETROREFLECTIVE STRIPE ON BACK. SIGNS SEPARATED FROM LUMP SUM. R15-1	SHS
SIGNAL ASSEMBLY G2 STA.3+93, LT. COMSTOCK ROAD		2	48	9	6																											REQUIRES SHEETING ON BOTH FRONT AND BACK INSTEAD OF JUST RETROREFLECTIVE STRIPE ON BACK. SIGNS SEPARATED FROM LUMP SUM. R15-1	SHS
SIGNAL ASSEMBLY G3 STA. 3+98, RT. COMSTOCK ROAD		2	48	9	6																											REQUIRES SHEETING ON BOTH FRONT AND BACK INSTEAD OF JUST RETROREFLECTIVE STRIPE ON BACK. SIGNS SEPARATED FROM LUMP SUM. R15-1	SHS
SIGNAL ASSEMBLY G1 STA. 3+63, RT. COMSTOCK ROAD		1	12	9	0.75																											TO BE MOUNTED ON THE SIGNAL MAST	ES1024X.0
SIGNAL ASSEMBLY G2 STA.3+93, LT. COMSTOCK ROAD	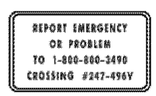	1	12	9	0.75																											TO BE MOUNTED ON THE SIGNAL MAST	ES1024X.0
	TOTALS THIS SHEET				19.5		0								0																		
	TOTALS SHEET 1				58.25		2								101.6																		
	ROUNDING				~~0.25~~							FT	FT	FT	FT	FT ~~0.4~~ ~~101.6~~	FT		EA	LB	LB	LB		LB	LB	LB	LB					
	TOTALS				SF ~~78.00~~ 77.75	SF	EA 2	SF				FT			FT ~~102.0~~ 120.75					LB			EA	LB				EA	EA	LB			

FINAL POST LENGTHS ARE TO BE DETERMINED IN THE FIELD. POST SIZES ARE COMPUTED BASED ON INFORMATION FURNISHED ON THE STANDARD SHEETS AND THE VTRANS "SIGN POST DESIGN GUIDELINE."

Stantec

PROJECT NAME: SWANTON
PROJECT NUMBER: STP 2038(16)

FILE NAME: ...\Plot-Files\17_Sign_Summary.pt# PLOT DATE: 8/29/2011
PROJECT LEADER: G. EDWARDS DRAWN BY: KJR
DESIGNED BY: KJR CHECKED BY: GAE
TRAFFIC SIGN SUMMARY SHEET 2 SHEET 15 OF 25