STATE OF VERMONT
AGENCY OF TRANSPORTATION

TRAFFIC SIGN SUMMARY SHEET

MILEMARKER, STATION, OR SIGN NUMBER	SIGN LEGEND	SIGN DIMENSIONS EA	SIGN DIMENSIONS WIDTH (in)	SIGN DIMENSIONS HEIGHT (in)	NEW & SALVAGED SIGNS "A"	NEW & SALVAGED SIGNS "B"	NEW & SALVAGED SIGNS SALV SIGN	NEW & SALVAGED SIGNS SALV TIS	EXIST POST RETAIN	EXIST POST SALVAGE	NEW SIGN POSTS NO. OF POSTS	FLANGED CHANNEL lb/ft 1.12	FLANGED CHANNEL lb/ft 2.0	FLANGED CHANNEL lb/ft 3.0	SQUARE STEEL (in) lb/ft 1.75	SQUARE STEEL (in) lb/ft 2.0	SQUARE STEEL (in) lb/ft 2.5	ANCHOR	SLEEVE	TUBULAR ALUMINUM Ø (in) lb/ft 3.0	TUBULAR ALUMINUM Ø (in) lb/ft 4.0	TUBULAR ALUMINUM Ø (in) lb/ft 4.0 MOD	FOUND-ATION	TUBULAR STEEL Ø (in) lb/ft 3.0	TUBULAR STEEL Ø (in) lb/ft 3.5	TUBULAR STEEL Ø (in) lb/ft 4.0	TUBULAR STEEL Ø (in) lb/ft 5.0	W-SHAPE STEEL FTG. SIZE 24"	W-SHAPE STEEL FTG. SIZE 30"	W-SHAPE STEEL WEIGHT	W-SHAPE STEEL POST SIZE	SIGNAME REQUIRED	REMARKS	SIGN DETAIL DETAIL ON SHEET NUMBER	SIGN DETAIL STD. SHEET NUMBER
												OPTION ITEMS																							
51+75.25 RT.	PUMPHOUSE RD PVT.	1	36	8 ~~6~~	2.00 ~~1.50~~	-	-	-	-	-	1	-	-	-	-	10	-	X	-	-	-	-	-	-	-	-	-	-	-	-	-	-	-	STREET NAME SIGN	THIS SHEET	-
52+02.00 RT.	STOP	1	30	30	6.25	-	-	-	-	-	1	-	-	-	-	10	-	X	-	-	-	-	-	-	-	-	-	-	-	-	-	-	-	-	R1-1	SHS	-
52+02.00 RT.	SOUTH ST	1	30 ~~31~~	8 ~~9~~	1.67 ~~1.94~~	-	-	-	-	-	1	-	-	-	-	-	-	X	-	-	-	-	-	-	-	-	-	-	-	-	-	-	-	STREET NAME SIGN	THIS SHEET	-
52+02.00 RT.	CAIN HILL RD PVT.	1	36	8 ~~6~~	2.00 ~~1.50~~	-	-	-	-	-	1	-	-	-	-	-	-	X	-	-	-	-	-	-	-	-	-	-	-	-	-	-	-	STREET NAME SIGN	THIS SHEET	-
4+80.00 LT.	DEAD END	1	36	36	9.00	-	-	-	-	-	1	-	-	-	-	10	-	X	-	-	-	-	-	-	-	-	-	-	-	-	-	-	-	-	W14-1	SHS	-
54+06.00 LT.	R	1	24	24	4.00	-	-	-	-	-	1	-	-	-	-	10	-	X	-	-	-	-	-	-	-	-	-	-	-	-	-	-	-	-	R8-3A	SHS	-
												FT -	FT -	FT -	FT -	FT 40	FT -		EA -	LB -	LB -	LB -	-	LB -	LB -	LB -	LB -								
	TOTALS				SF 24.19	SF -	EA. -	SF -				FT -			FT 40					LB -			EA. -	LB -				EA. -	EA. -	LB -					

FINAL POST LENGTHS ARE TO BE DETERMINED IN THE FIELD. POST SIZES ARE COMPUTED BASED ON INFORMATION FURNISHED ON THE STANDARD SHEETS AND THE TRAFFIC & SAFETY DIVISION'S "SIGN POST DESIGN GUIDELINE."

NOTE: STREET SIGNS SHALL BE IN CONFORMANCE WITH TOWN STANDARDS

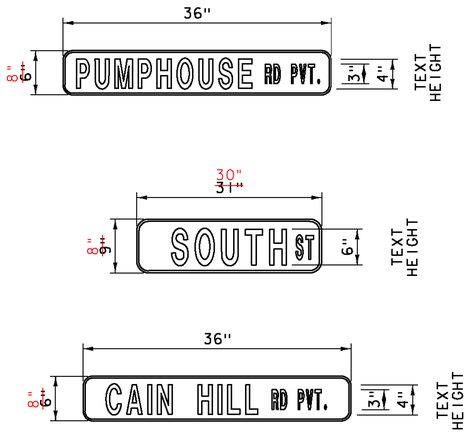

PROJECT NAME: BRISTOL
PROJECT NUMBER: BRO 1445 (32)

FILE NAME: s05j352sign.dgn
PROJECT LEADER: J. LACROIX
DESIGNED BY: G. LAROCHE
TRAFFIC SIGN SUMMARY

PLOT DATE: 04-JUN-2013
DRAWN BY: R.PELLETT
CHECKED BY: T. FILLBACH
SHEET 19 OF 66