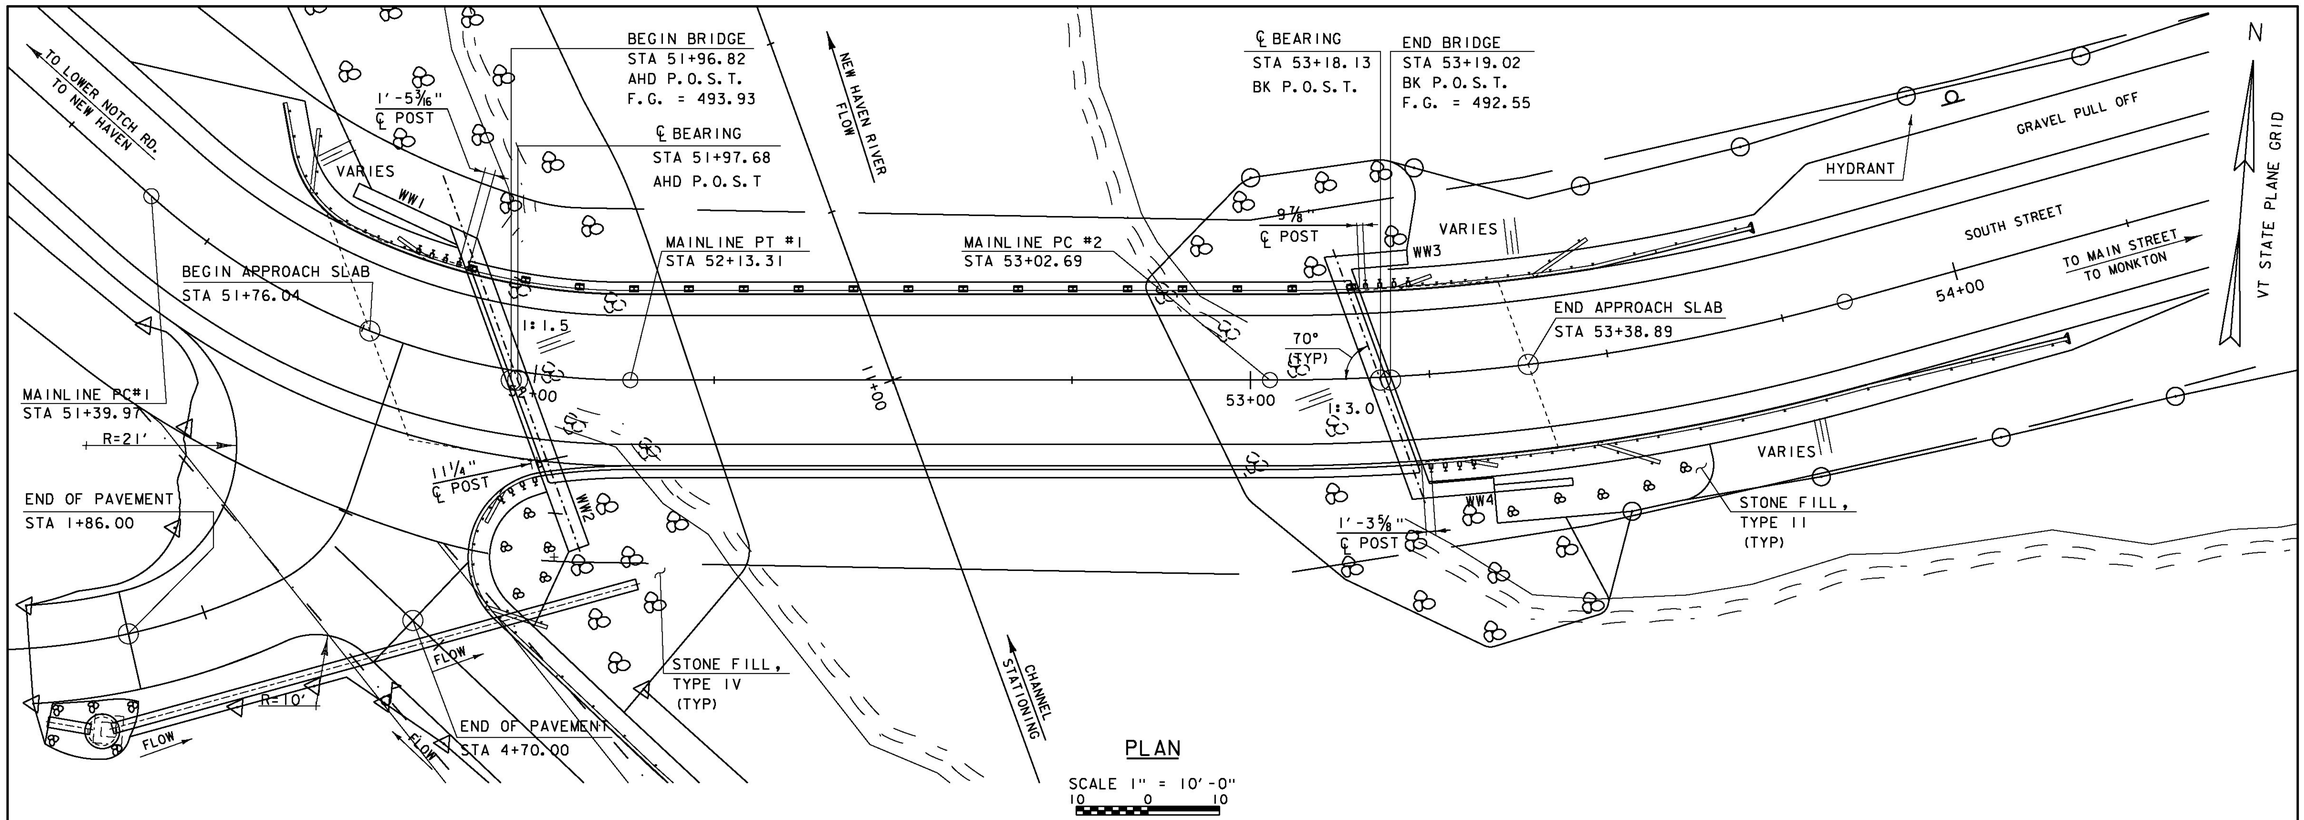

PLAN

SCALE 1" = 10'-0"
10 0 10

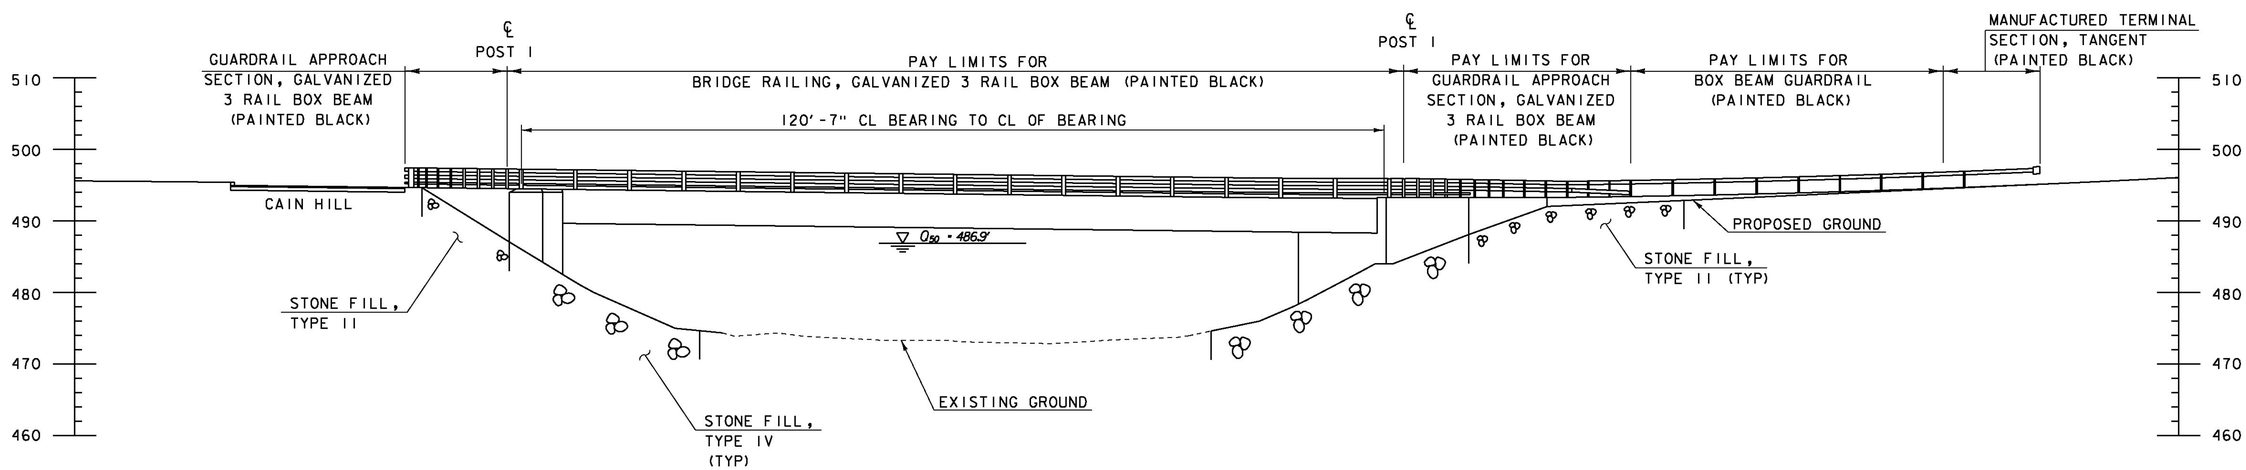

ELEVATION AT UPSTREAM FASCIA

SCALE 1" = 10'-0"
10 0 10

PROJECT NAME: BRISTOL	
PROJECT NUMBER: BRO 1445(32)	
FILE NAME: s051352pe.dgn	PLOT DATE: 04-JUN-2013
PROJECT LEADER: J. LACROIX	DRAWN BY: J. SALVATORI
DESIGNED BY: G. LAROCHE	CHECKED BY: T. FILLBACH
PLAN AND ELEVATION SHEET	SHEET 29 OF 66