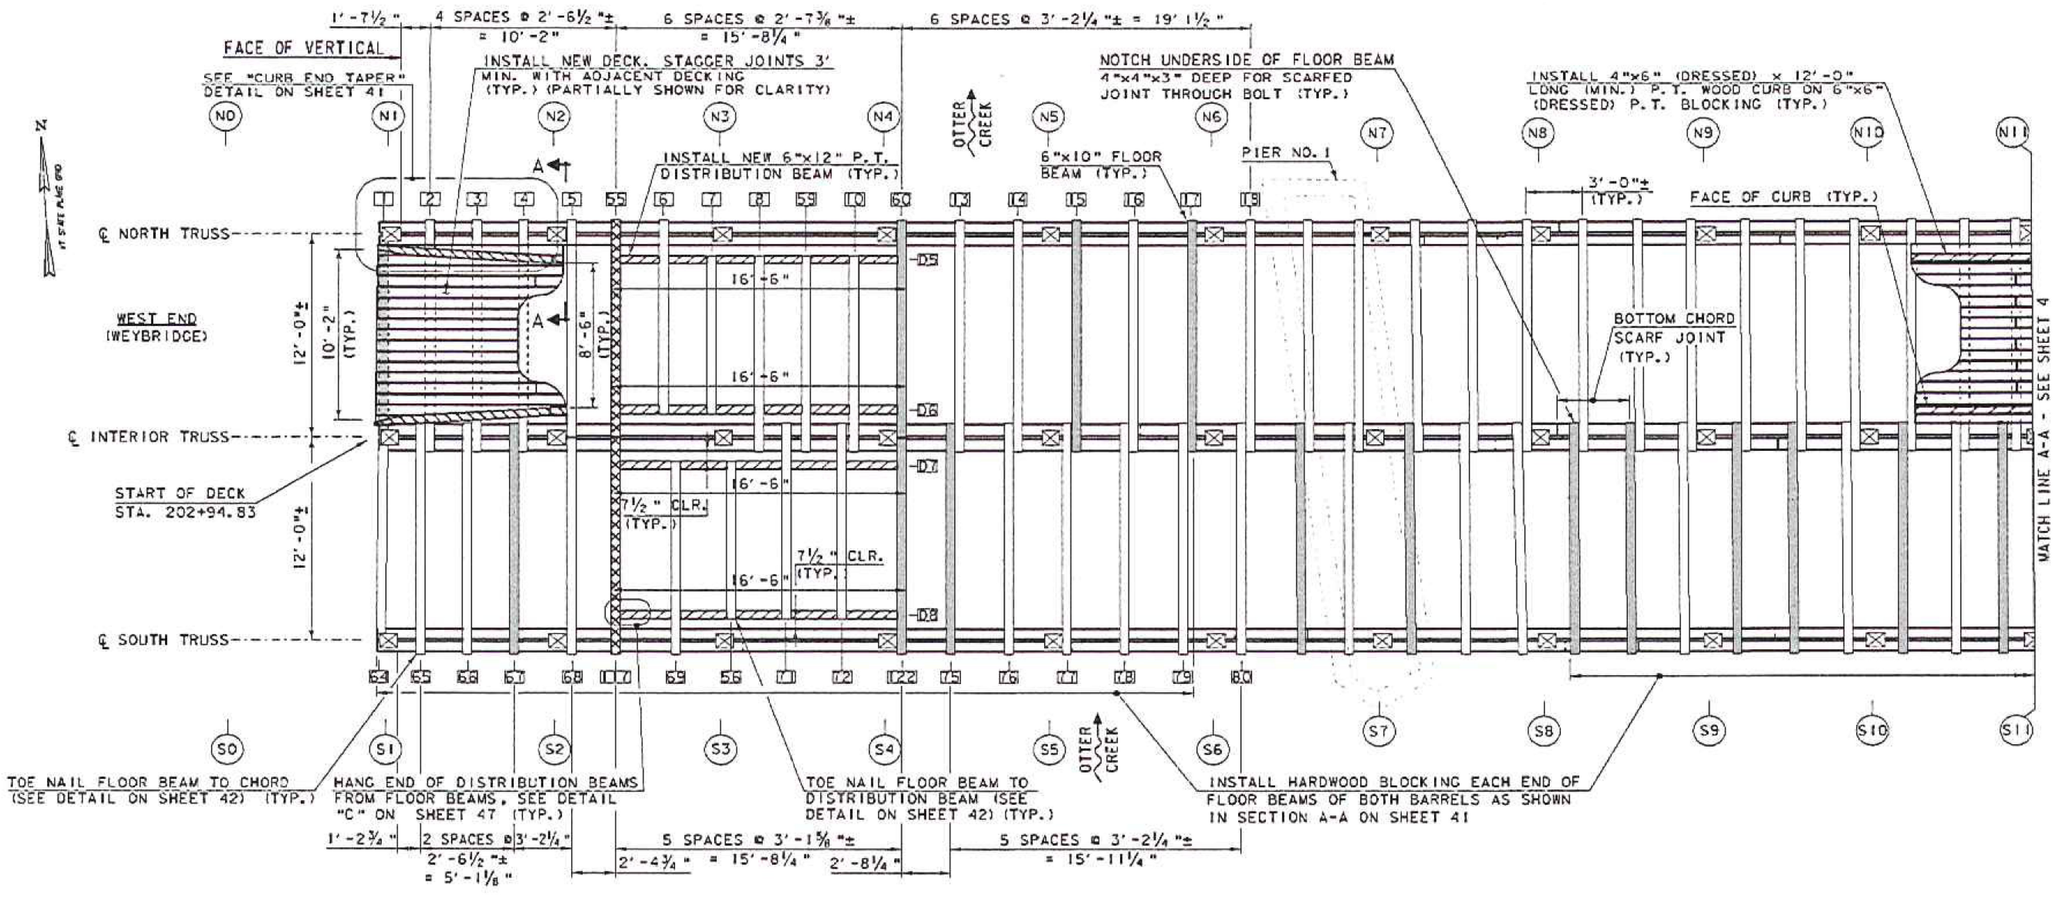

STATIONING

REVISED FLOOR FRAMING PLAN

SCALE: ¼" = 1'-0"

LEGEND:

- DISTRIBUTION BEAM
- FLOOR BEAM NUMBER
- TRUSS NODE LOCATION
- PREDETERMINED MEMBER TO BE REPLACED
- NEW MEMBER
- MEMBER TO BE REPLACED AND SALVAGED FOR REUSE AT OTHER LOCATION

Hoyle, Tanner & Associates, Inc.

MTA PROJECT NO. 90427	MODEL FRAMING 3

PROJECT NAME: MIDDLEBURY-WEYBRIDGE
PROJECT NUMBER: BHO 1445(33)

FILE NAME: z06J086sup10.dgn
PROJECT LEADER: M.D.SARGENT
DESIGNED BY: J.BICJA
REVISED FLOOR FRAMING PLAN (1 OF 2)

PLOT DATE: 7/5/2012
DRAWN BY: J.B.McQUAID
CHECKED BY: S.T.JAMES
SHEET 3 OF 4