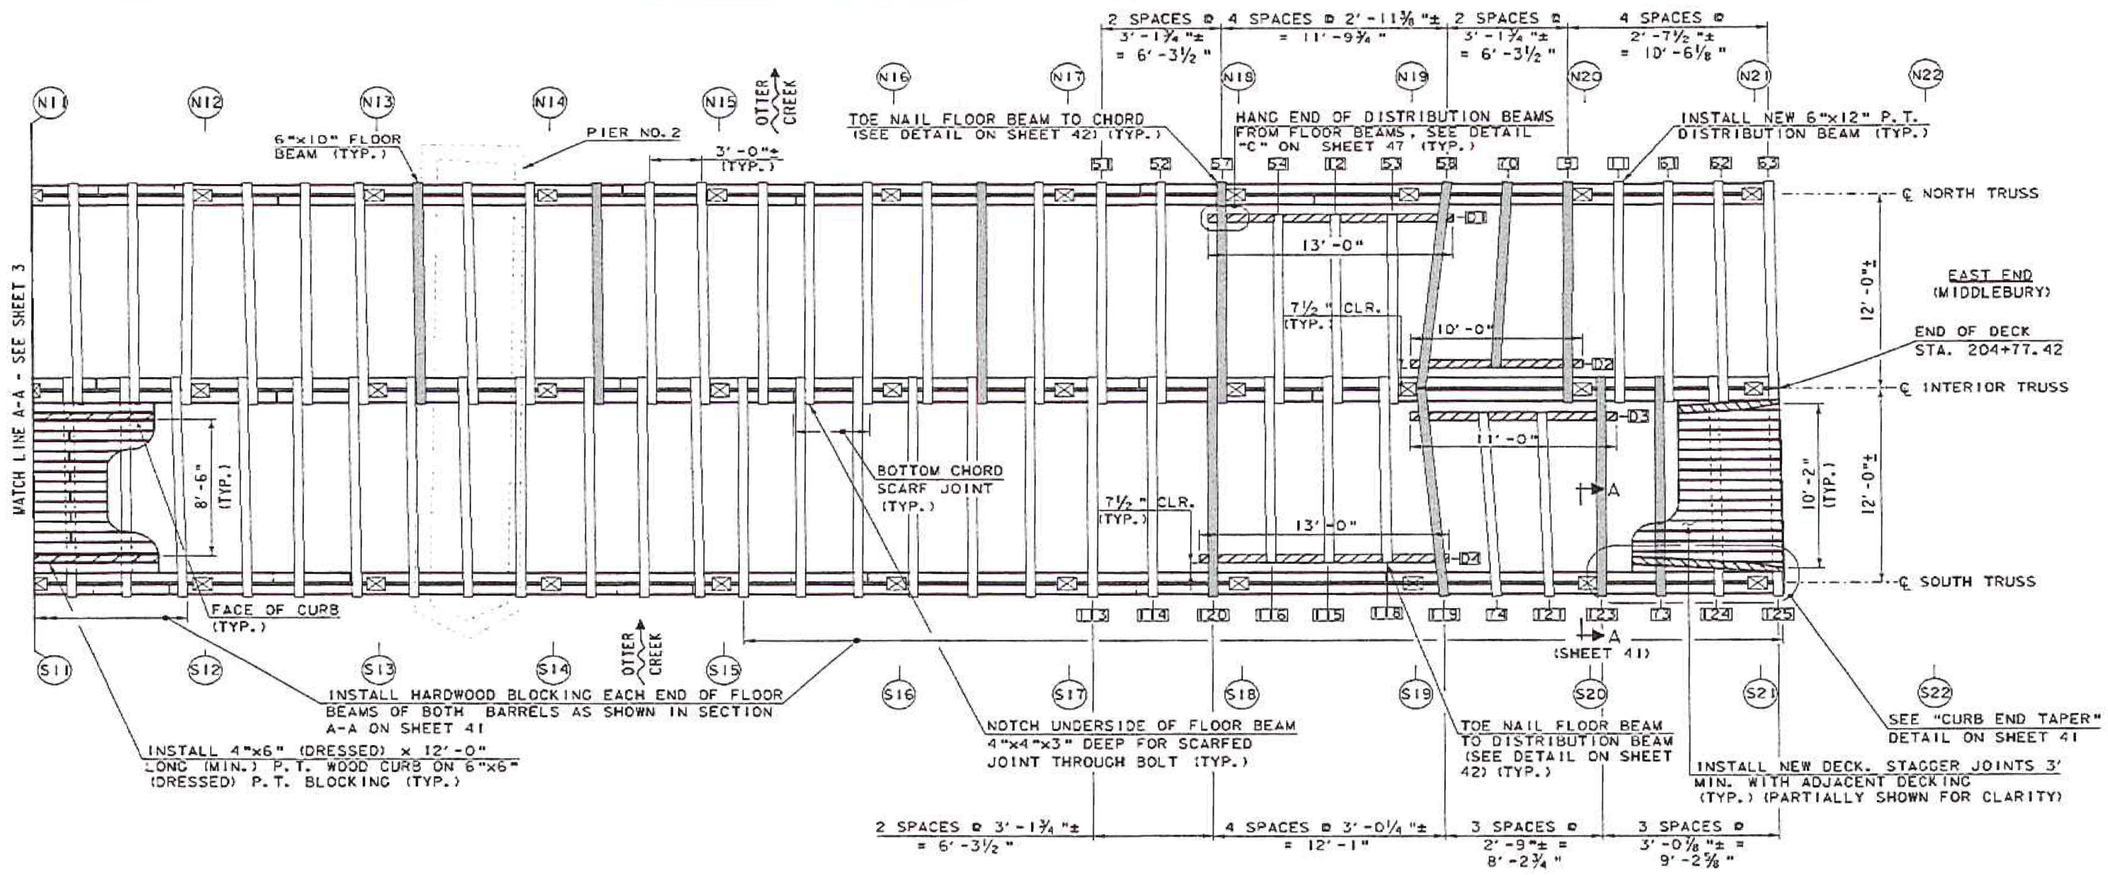

REVISED FLOOR FRAMING PLAN

SCALE: ¼" = 1'-0"

LEGEND:

- DISTRIBUTION BEAM
- FLOOR BEAM NUMBER
- TRUSS NODE LOCATION
- PREDETERMINED MEMBER TO BE REPLACED
- NEW MEMBER

SCALE: ¼" = 1'-0"
1 0 2 4 6

Hoyle, Tanner & Associates, Inc.

HTA PROJECT NO.	MODEL
904217	FRAMING 4

PROJECT NAME: MIDDLEBURY-WEYBRIDGE
PROJECT NUMBER: BHO 1445(33)

FILE NAME: z061086sup10.dgn
PROJECT LEADER: M.D.SARGENT
DESIGNED BY: J.BICJA
REVISED FLOOR FRAMING PLAN (2 OF 2)

PLOT DATE: 7/5/2012
DRAWN BY: J.B.McQUAID
CHECKED BY: S.T.JAMES
SHEET 4 OF 4