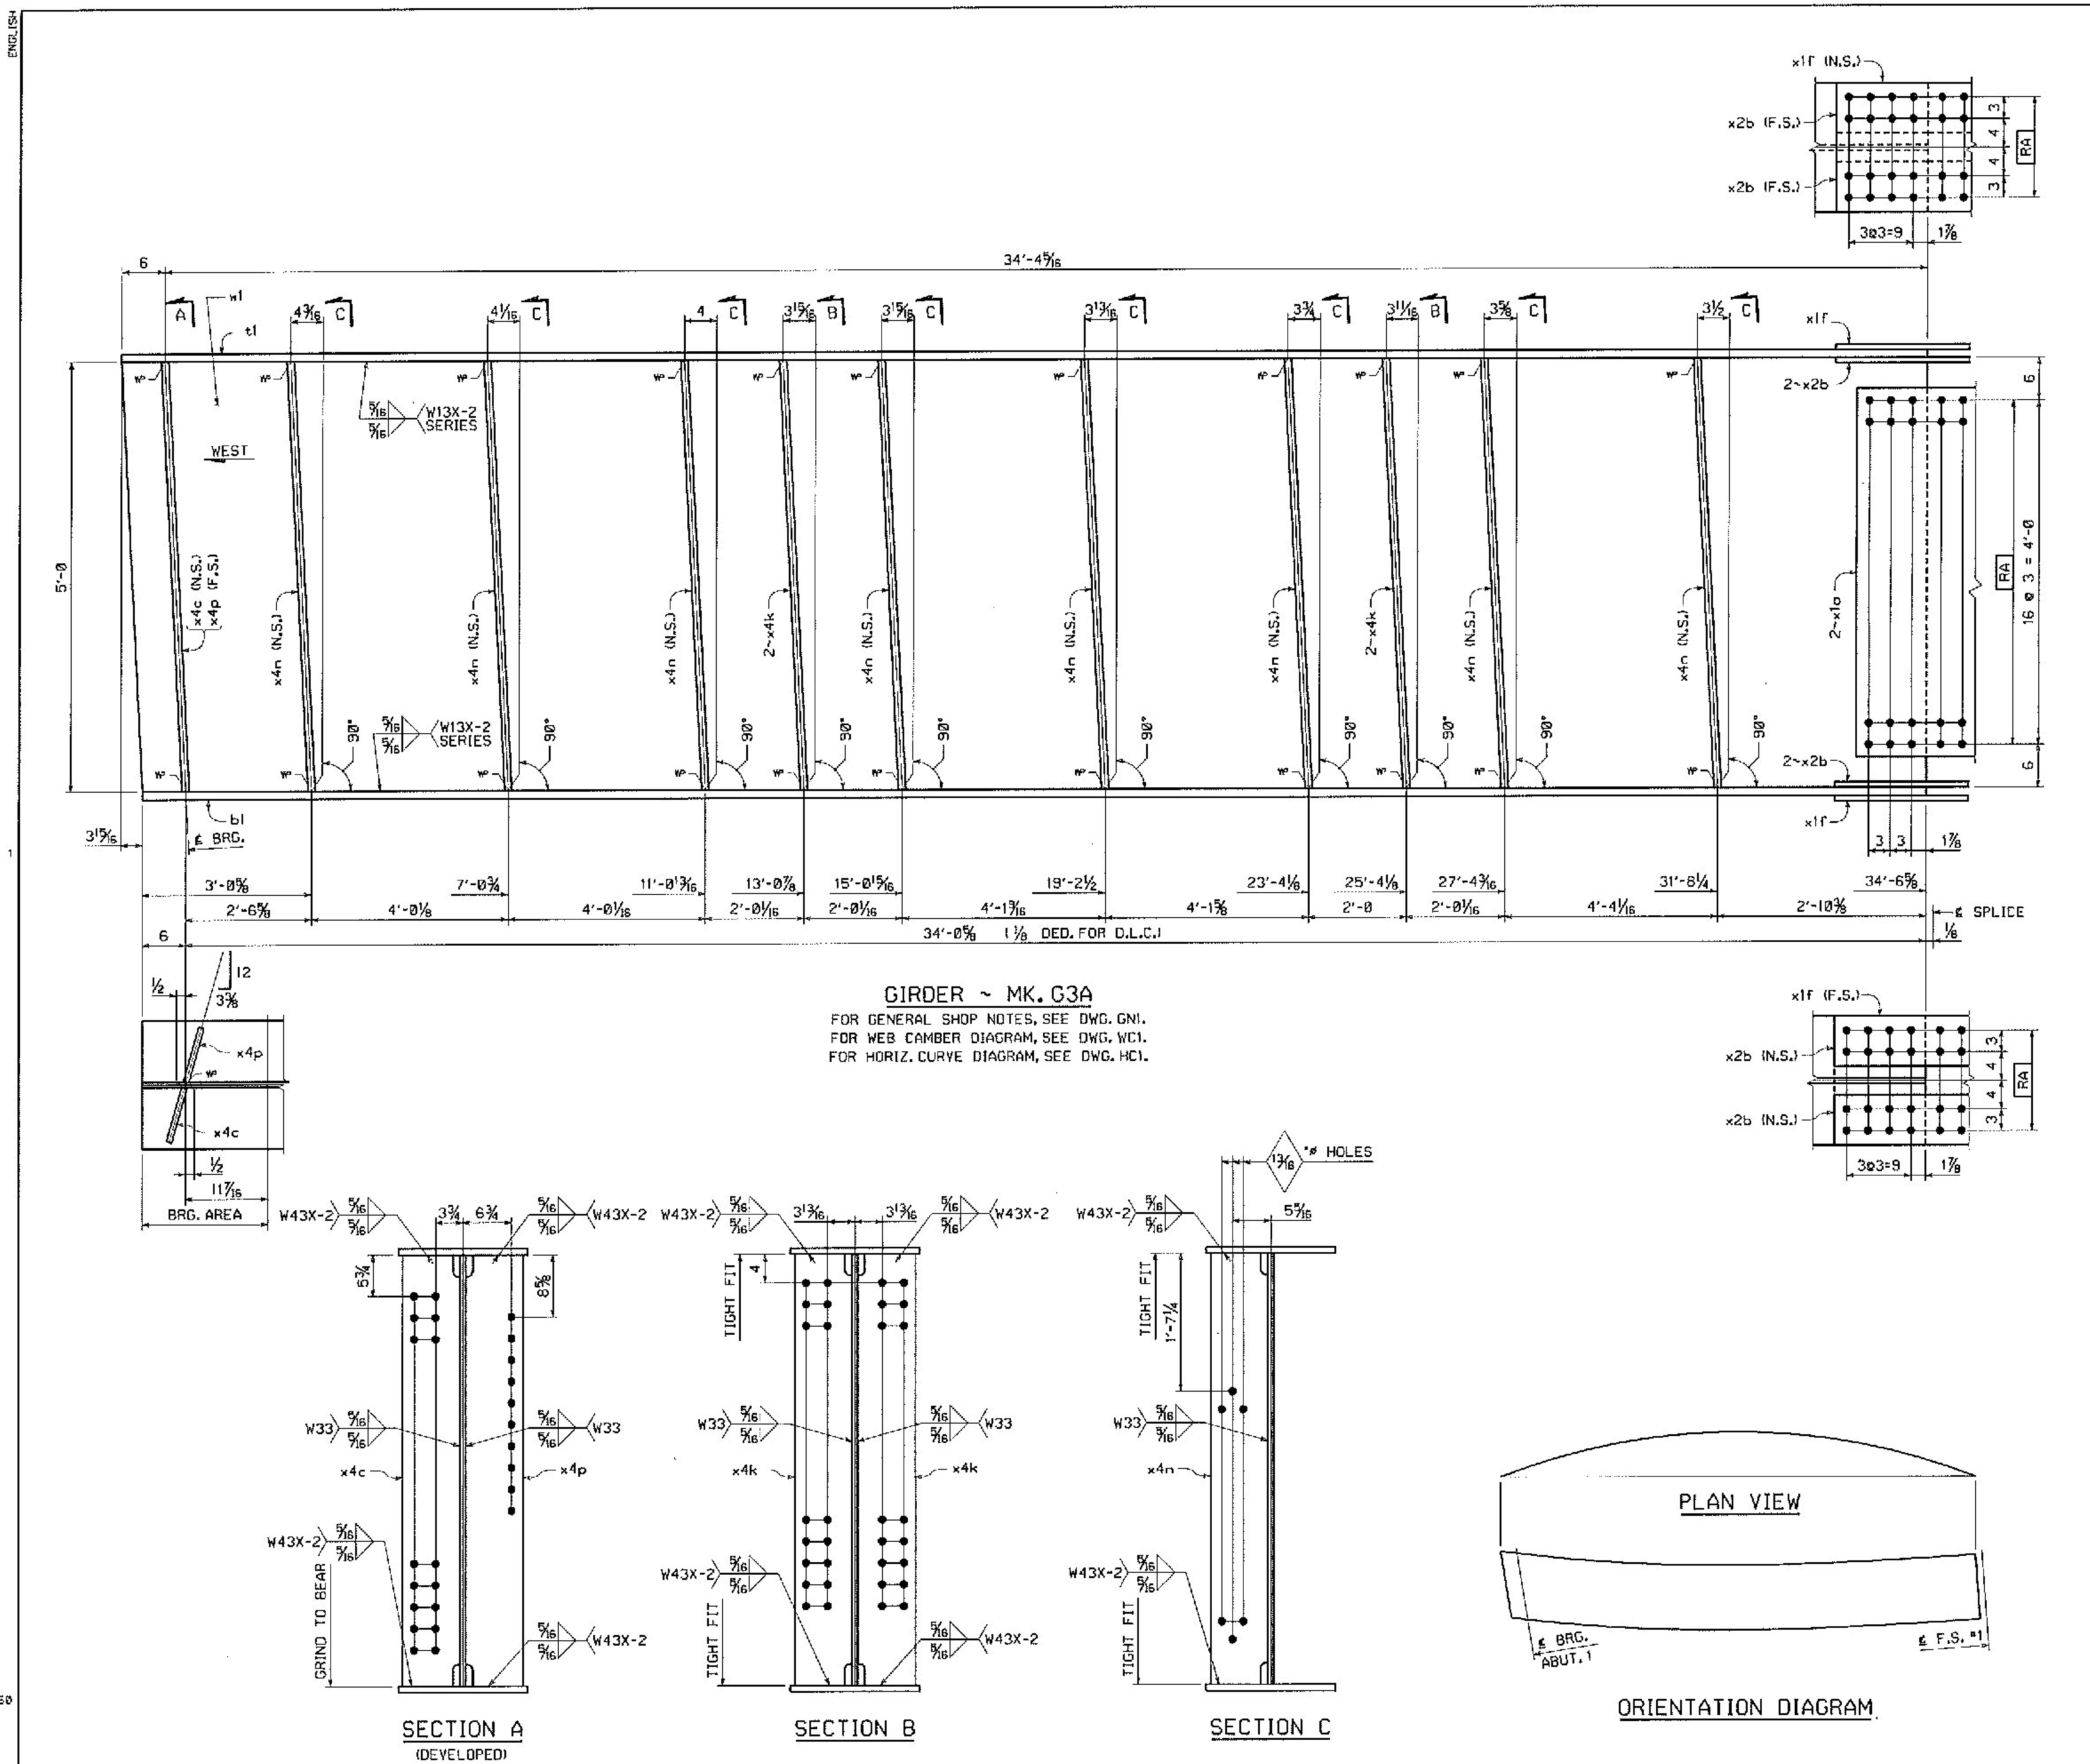


## BILL OF MATERIAL

| QTY EA. | MARK | COMM | DESCRIPTION | | LENGTH | | SPEC | GRADE | TEST | REMARKS | ITEM | SHIP WT. EA. (LBS) |
|---|---|---|---|---|---|---|---|---|---|---|---|---|
| 1 | G3A | | GIRDER | | | | | | | | | 9604 |
| 1 | w1 | PL | 5/8 x | 60 | 34 | 10 9/16 | M270 | 50W | T | | 03006 | |
| 1 | t1 | PL | 7/8 x | 18 | 34 | 10 5/16 | M270 | 50W | T | | 04015 | |
| 1 | b1 | PL | 7/8 x | 18 | 34 | 6 5/8 | M270 | 50W | T | | 04015 | |
| 2 | x1a | PL | 5/16 x | 51 1/2 | 1 | 7 1/2 | M270 | 50W | T | | 06001 | |
| 2 | x1f | PL | 1/2 x | 18 | 2 | 1 1/2 | M270 | 50W | T | | 06005 | |
| 4 | x2b | PL | 1/2 x | 7 | 2 | 1 1/2 | M270 | 50W | T | | 06009 | |
| 1 | x4p | PL | 3/4 x | 8 | 5 | 0 5/16 | M270 | 50W | T | | 07001 | |
| 1 | x4c | PL | 3/4 x | 8 | 5 | 0 5/16 | M270 | 50W | T | | 07001 | |
| 4 | x4k | PL | 1/2 x | 8 | 5 | 0 1/8 | M270 | 50W | T | | 07002 | |
| 8 | x4n | PL | 1/2 x | 8 | 5 | 0 1/8 | M270 | 50W | T | | 07002 | |

Vermont Agency of Transportation
**RECEIVED**
CK'D BY J. CLARK OK'D BY J. GRIFFIN
February 12, 2013
RESUBMIT NO Approved
BY J. LACROIX DATE 02/25/2013

| NO. | REVISION | BY | CHK'D | DATE |
|---|---|---|---|---|
| △ | | | | |
| △ | | | | |
| △ | | | | |

HOLES: 15/16"⌀ (U.N.)
BOLTS: NONE
COATING: NONE
CODE(S): 30
SCALE: N.T.S.

HIGH STEEL STRUCTURES INC. — An ISO 9001:2000 Certified Company — An Affiliate of High Industries Inc.
Lancaster Facility, 1915 Old Philadelphia Pike, Lancaster, PA 17605-0008
Williamsport Facility, Williamsport, PA
www.histeel.com

GIRDER — G3A
ROUTE NO. TH7 (BRIDGE ST.) OVER STEVENS BRANCH
ROUTE NO. TH7 STA. 13+05.00 TO STA. 14+25.00
BRIDGE NO. 11, TOWN OF BARRE, COUNTY OF WASHINGTON
STATE OF VERMONT
AGENCY OF TRANSPORTATION

| | | | |
|---|---|---|---|
| STATE CONT. OR REF. NO. | | FED. AID PROJ. NO. | |
| GENERAL CONTRACTOR | MILLER CONSTRUCTION, INC. | HSSI PROJ. MGR | KEN GLIDDEN |

VT

| | | | | | | | |
|---|---|---|---|---|---|---|---|
| DRAWING MANAGER | JOSH MURRY (IH) | MADE BY | CDS | CHK'D. BY | MGK | DATE | 12/28/12 |
| HSSI PROJECT NUMBER | S-1120266A-1 | DRAWING NUMBER | 3 OF 14 | | | | |