


GIRDER ~ MK. G3B

FOR GENERAL SHOP NOTES, SEE DWG. GN1.
FOR WEB CAMBER DIAGRAM, SEE DWG. WC1.
FOR HORIZ. CURVE DIAGRAM, SEE DWG. HC1.

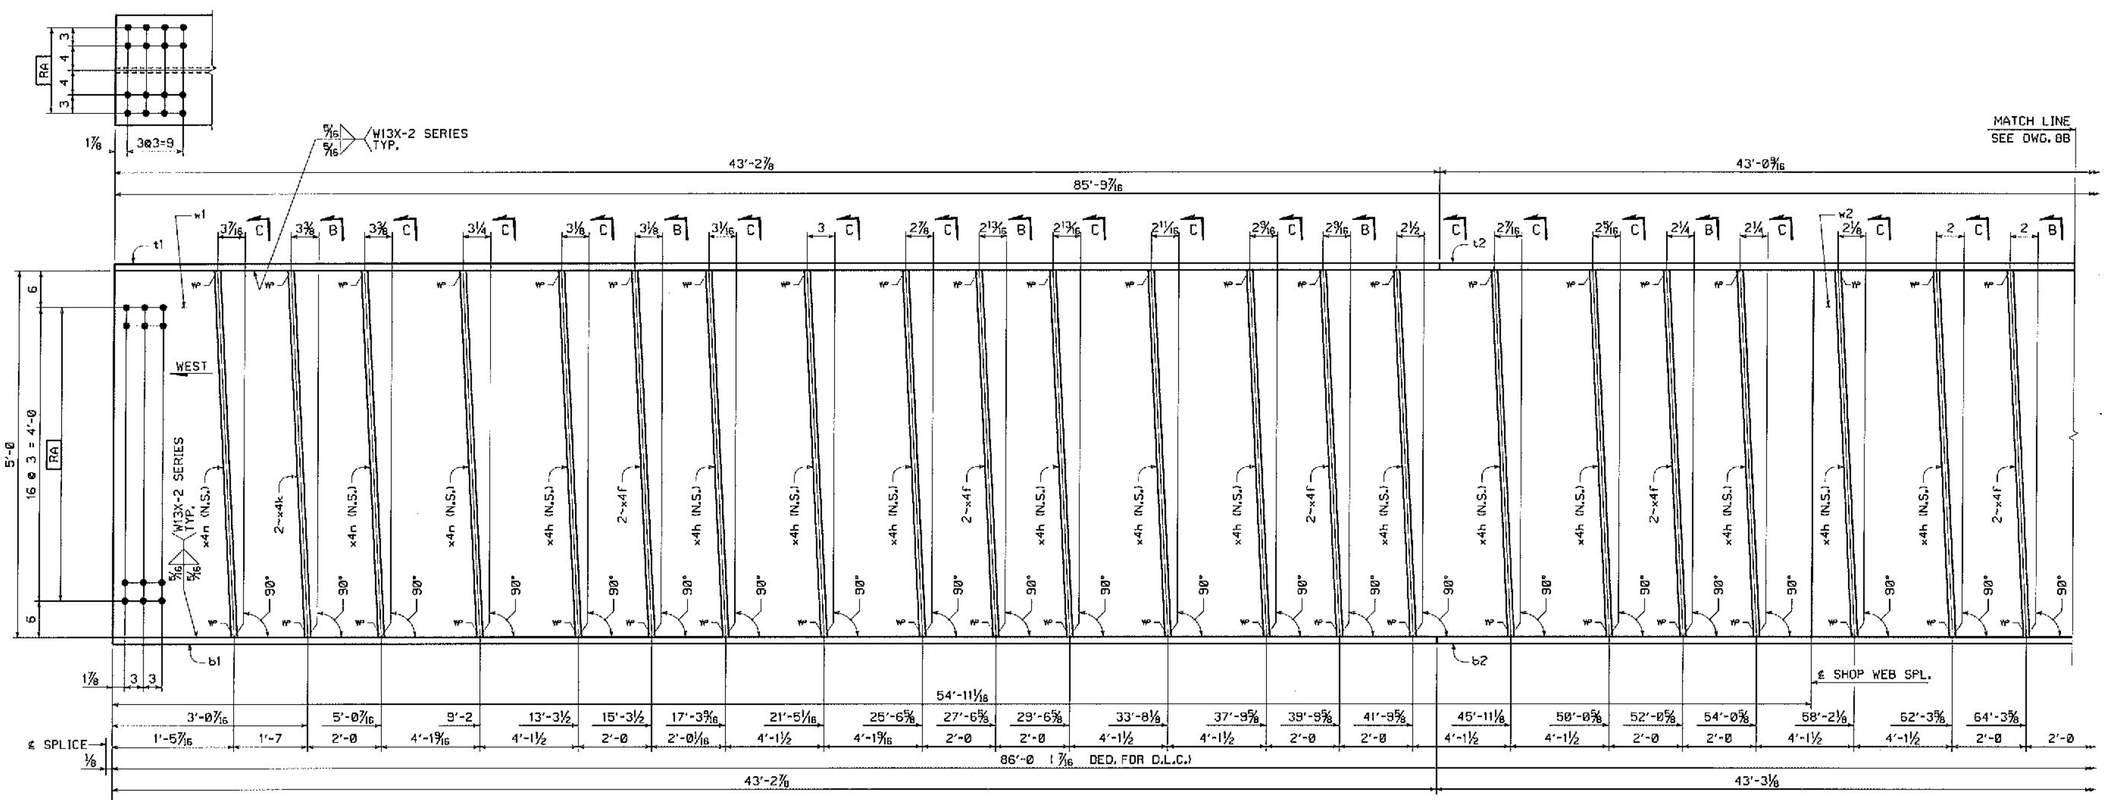


SECTION A (DEVELOPED)

SECTION B

SECTION C

NOTES:
WORK THIS DRAWING WITH DRAWING 8B.

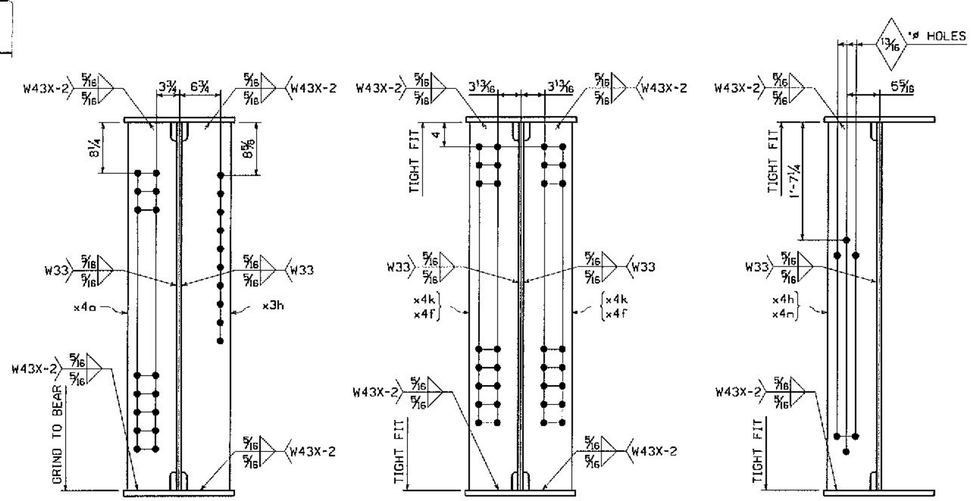


ORIENTATION DIAGRAM

Vermont Agency of Transportation
RECEIVED
CK'D BY J. CLARK OK'D BY J. GRIFFIN
February 12, 2013
RESUBMIT NO Approved
BY J. LACROIX DATE 02/25/2013

| NO. | REVISION | BY | CHK'D | DATE |
|---|---|---|---|---|
| △ | | | | |
| △ | | | | |
| △ | | | | |

HOLES: 15/16"ø (U.N.)
BOLTS: NONE
COATING: NONE
CODE(S): 30
SCALE: N.T.S.

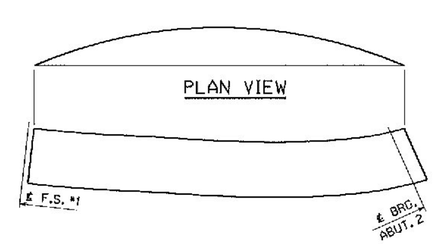HIGH STEEL STRUCTURES INC.
An Affiliate of High Industries Inc.
Lancaster Facility: 775 Old Philadelphia Pike, Lancaster, PA 17602-2808, Phone (717) 299-5211
Williamsport Facility: 3011 N. 6th Street, Williamsport, PA 17701, Phone (570) 326-9051, www.highsteel.com

GIRDER G3B
ROUTE NO. TH7 (BRIDGE ST.) OVER STEVENS BRANCH
ROUTE NO. TH7 STA. 13+05.00 TO STA. 14+25.00
BRIDGE NO. 11, TOWN OF BARRE, COUNTY OF WASHINGTON
STATE OF VERMONT
AGENCY OF TRANSPORTATION

STATE CONT. OR REF. NO.: | FED. AID PROJ. NO.:
GENERAL CONTRACTOR: MILLER CONSTRUCTION, INC. | HSSI PROJ. MGR: KEN GLIDDEN
DRAWING MANAGER: JOSH MURRY (JH) | MADE BY: CDS | CHK'D. BY: MGK | DATE: 12/29/12
HSSI PROJECT NUMBER: S-1120266A-1 | DRAWING NUMBER: 8AB OF 14

VT

ENGLISH
PLOTTED: 1/4/2013 10:26:28 AM
By: JSpicer
SHIPMENT 31 FRAMING: 2025/251 PRDL: 2025/252 SHIP&ERECT.: 2025/253