


## GIRDER ~ MK. G4B

FOR GENERAL SHOP NOTES, SEE DWG. GN1.
FOR WEB CAMBER DIAGRAM, SEE DWG. WC1.
FOR HORIZ. CURVE DIAGRAM, SEE DWG. HC1.

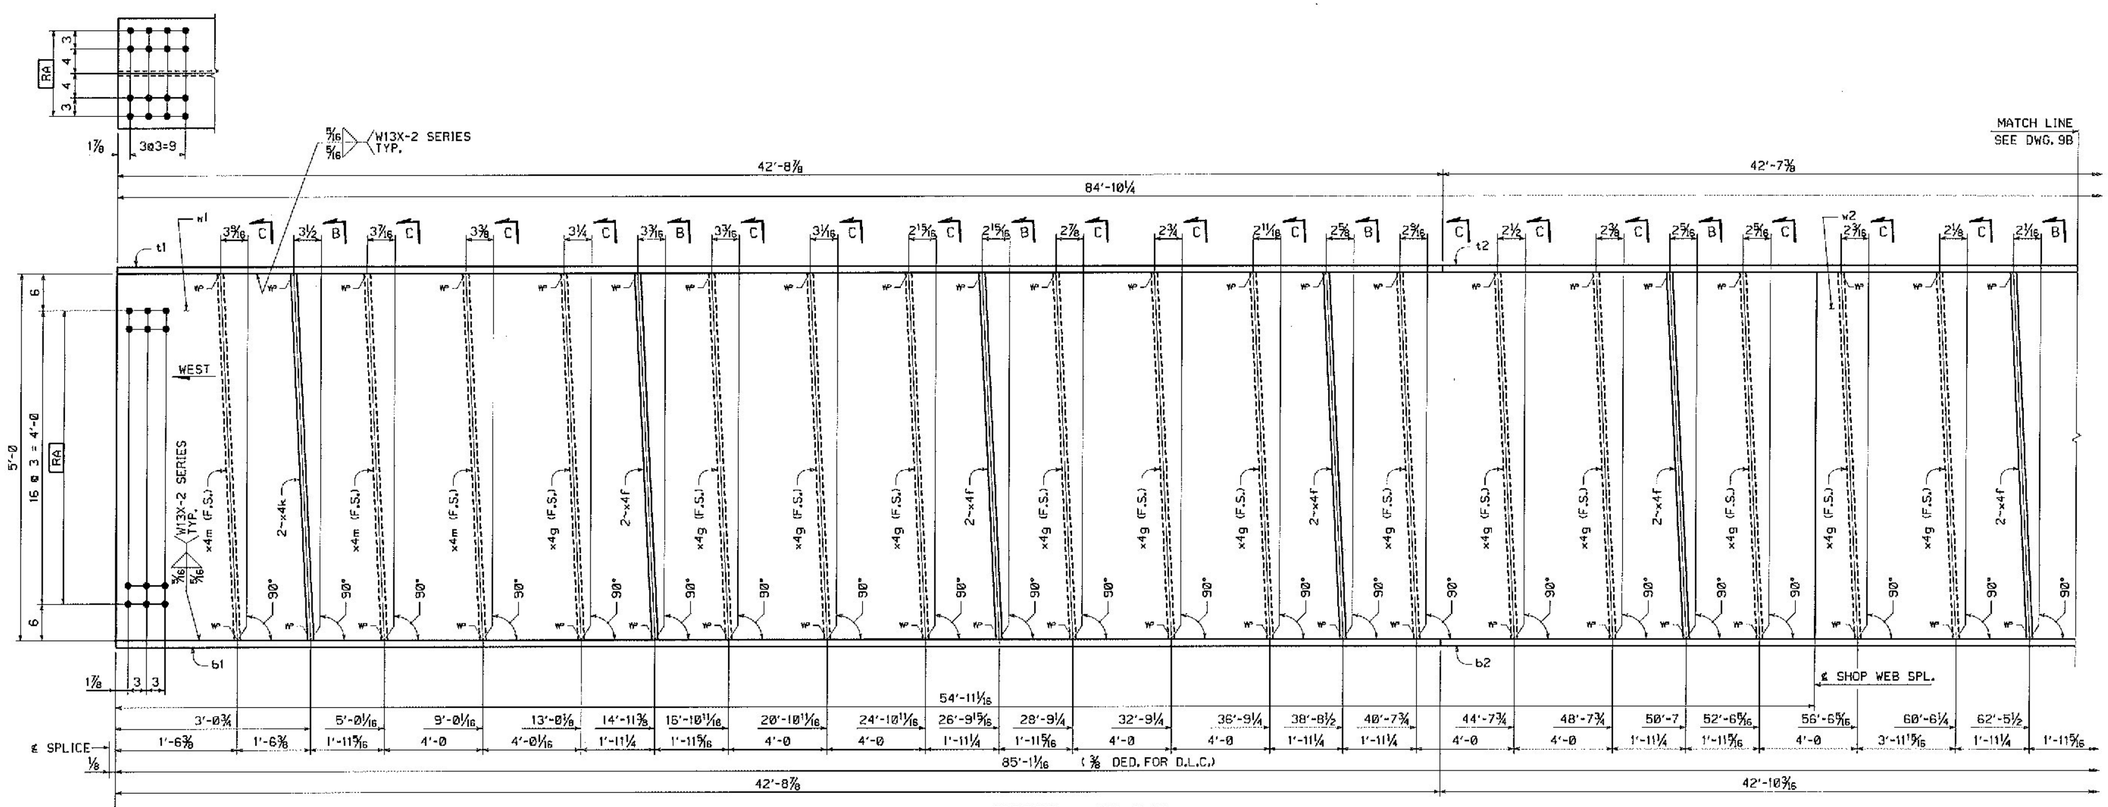


SECTION A (DEVELOPED)

SECTION B

SECTION C

NOTES:
WORK THIS DRAWING WITH DRAWING 9B.

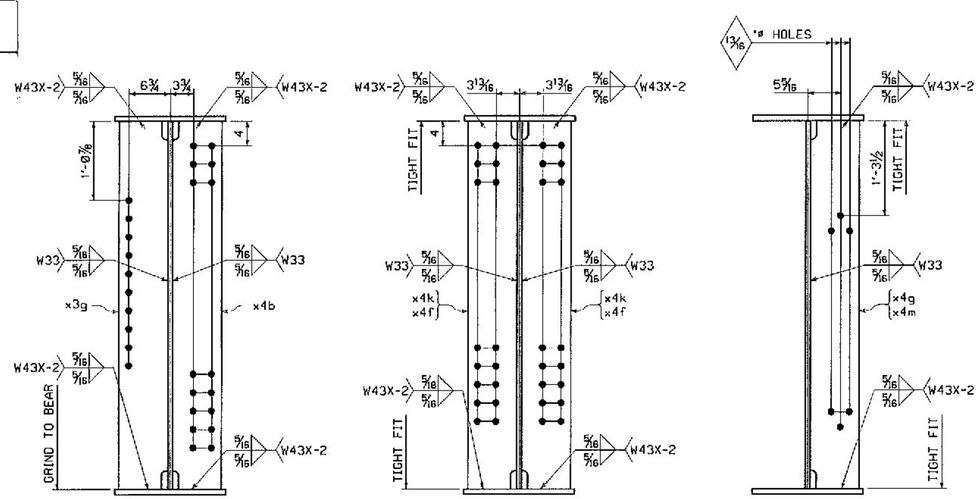


ORIENTATION DIAGRAM

Vermont Agency of Transportation
RECEIVED
CK'D BY J. CLARK OK'D BY J. GRIFFIN
February 12, 2013
RESUBMIT NO Approved
BY J. LACROIX DATE 02/25/2013

| NO. | REVISION | BY | CHK'D | DATE |
|---|---|---|---|---|
| △ | | | | |
| △ | | | | |
| △ | | | | |

HIGH STEEL STRUCTURES INC.
An ISO 9001:2000 Certified Company
An Affiliate of High Industries Inc.
Lancaster Factory: 165 Old Park Road, Lancaster, PA 17601-3009 Phone: (717) 299-7271
Williamsport Factory: 350 E. 4th Street, Williamsport, PA 17701 Phone: (570) 326-3061
www.highsteel.com
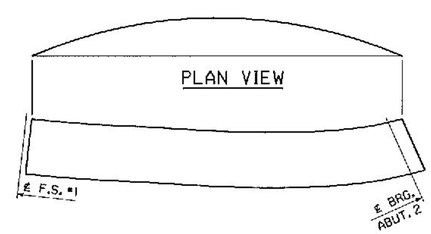
| | |
|---|---|
| HOLES | 13/16" ø (U.N.) |
| BOLTS | NONE |
| COATING | NONE |
| CODE(S) | 30 |
| SCALE | N.T.S. |

GIRDER G4B
ROUTE NO. TH7 (BRIDGE ST.) OVER STEVENS BRANCH
ROUTE NO. TH7 STA. 13+05.00 TO STA. 14+25.00
BRIDGE NO. 11, TOWN OF BARRE, COUNTY OF WASHINGTON
STATE OF VERMONT
AGENCY OF TRANSPORTATION

| | | | |
|---|---|---|---|
| STATE CONT. OR REF. NO. | | FED. AID PROJ. NO. | |
| GENERAL CONTRACTOR | MILLER CONSTRUCTION, INC. | HSSI PROJ. MGR | KEN GLIDDEN |
| DRAWING MANAGER | JOSH MURRY (IH) | MADE BY CDS | CHK'D BY MGK DATE 12/29/12 |
| HSSI PROJECT NUMBER | S-1120266A-1 | DRAWING NUMBER | 9AB OF 14 |

VT

ENGLISH
PROJECT: S0025763 SHIPSERECT: S0025763 PROG: S0025763 PMSENG: S0025763 SHIPMNLN1 01 BY: JSpokor PLOTTED: 1/4/2013 10:26:42 AM