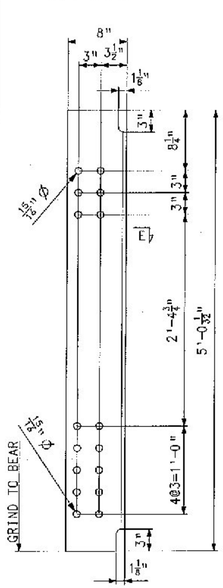

BRG. STIFF.
MK. x4a

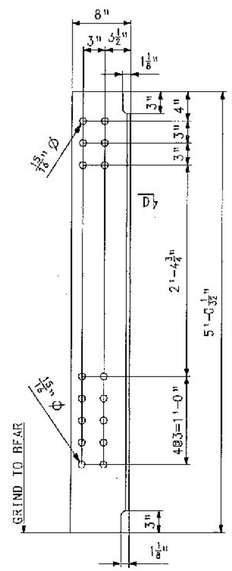

BRG. STIFF.
MK. x4b

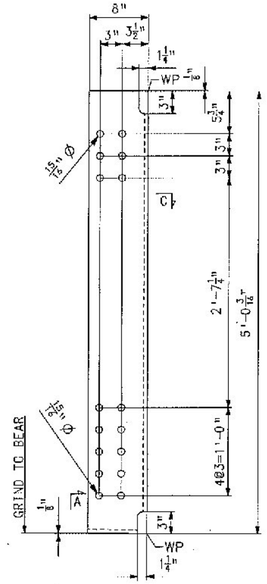

BRG. STIFF.
MK. x4c

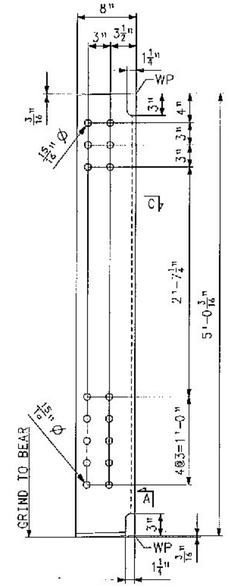

BRG. STIFF.
MK. x4d

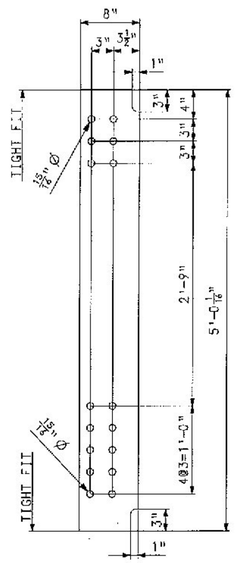

CONN. PLATE
MK. x4f

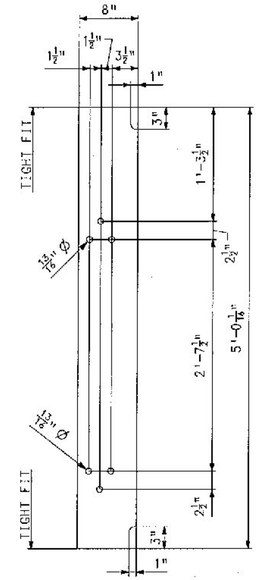

CONN. PLATE
MK. x4g

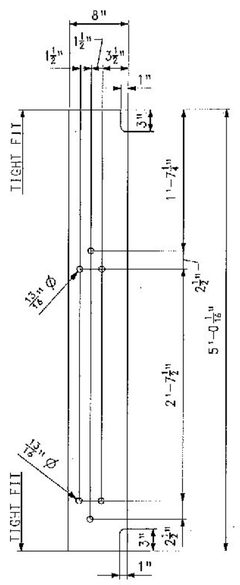

CONN. PLATE
MK. x4h

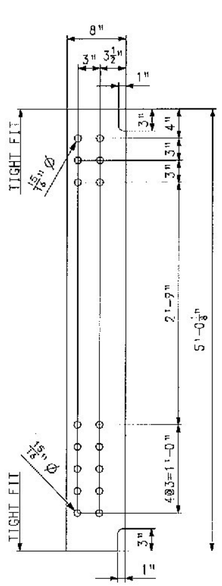

CONN. PLATE
MK. x4k

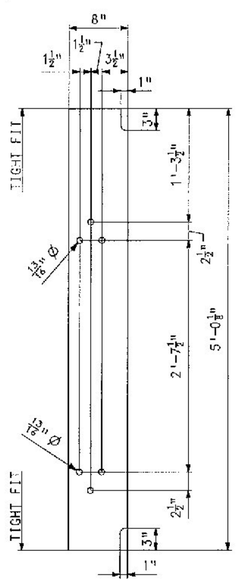

CONN. PLATE
MK. x4m

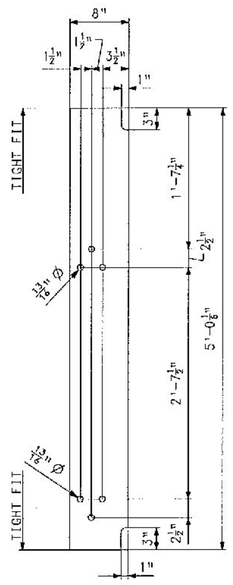

CONN. PLATE
MK. x4n

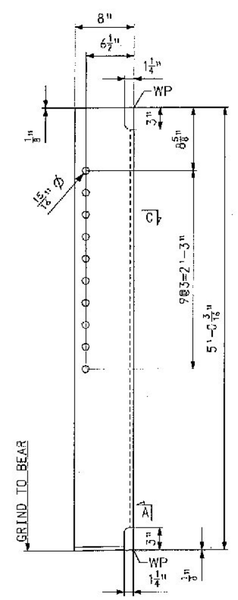

BRG. STIFF.
MK. x4p

BILL OF MATERIAL

QTY	MARK	COMM.	DESCRIPTION					LENGTH		SPEC	GRADE	TEST	REMARKS	ITEM	WEIGHT EA. (LBS)
1	x4a	PL	3/4	x	8			5	0 1/32	M270	50W	T		07001	102
1	x4b	PL	3/4	x	8			5	0 1/32	M270	50W	T		07001	102
1	x4c	PL	3/4	x	8			5	0 5/16	M270	50W	T		07001	103
1	x4d	PL	3/4	x	8			5	0 3/8	M270	50W	T		07001	103
51	x4f	PL	1/2	x	8			5	0 1/16	M270	50W	T		07002	68
19	x4g	PL	1/2	x	8			5	0 1/16	M270	50W	T		07002	68
19	x4h	PL	1/2	x	8			5	0 1/16	M270	50W	T		07002	68
21	x4k	PL	1/2	x	8			5	0 1/8	M270	50W	T		07002	68
11	x4m	PL	1/2	x	8			5	0 1/8	M270	50W	T		07002	68
11	x4n	PL	1/2	x	8			5	0 1/8	M270	50W	T		07002	68
1	x4p	PL	3/4	x	8			5	0 5/16	M270	50W	T		07001	103

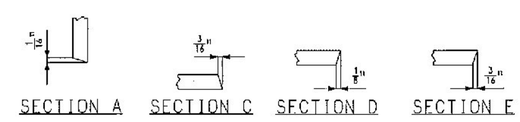

SECTION A SECTION C SECTION D SECTION E

Vermont Agency of Transportation
RECEIVED
CK'D BY J. CLARK OK'D BY J. GRIFFIN
February 12, 2013
RESUBMIT NO Approved
BY J. LACROIX DATE 02/25/2013

FOR GENERAL SHOP NOTES, SEE DRAWING GN1.

NO.	REVISION	BY	CHK'D	DATE
△				
△				
△				

HOLES: 15/16" Ø (U.N.)
BOLTS: NONE
COATING: NONE
CODE(S): 30
SCALE: N.T.S.

HIGH STEEL STRUCTURES INC.
1515 Old Philadelphia Pike
Lancaster, PA 17602-6039
Phone (717) 299-5211
www.highsteel.com
An ISO 9001:2000 Certified Company
An Affiliate of High Industries Inc.

GIRDER JOB STANDARDS
ROUTE NO. TH7 (BRIDGE ST.) OVER STEVENS BRANCH
ROUTE NO. TH7 STA. 13405.00 TO STA. 14425.00
BRIDGE NO. 11, TOWN OF BARRE, COUNTY OF WASHINGTON
STATE OF VERMONT
AGENCY OF TRANSPORTATION

STATE CONT. OR REF. NO.: | FED. AID PROJ. NO.:
GENERAL CONTRACTOR: MILLER CONSTRUCTION, INC. | HSSI PROJ. MGR: KEN OLIDOEN
DRAWING MANAGER: JOSH MURRY (IH) | MASF MV: | CDS | CHK'D BY: SSL | DATE: 12/27/12
HSSI PROJECT NUMBER: S-1120266A-1 | DRAWING NUMBER: X4 OF X5

VT

SHIPMENT 1 PAGENO: 5025752 PROJ: 5025752 S:1PAGERECT: 5025752
PLOTTED: MM/DD/YY hh:mm:ss BY: XXXXXXXX