INDEX OF SHEETS
SEE SHEET 2

STATE OF VERMONT
AGENCY OF TRANSPORTATION

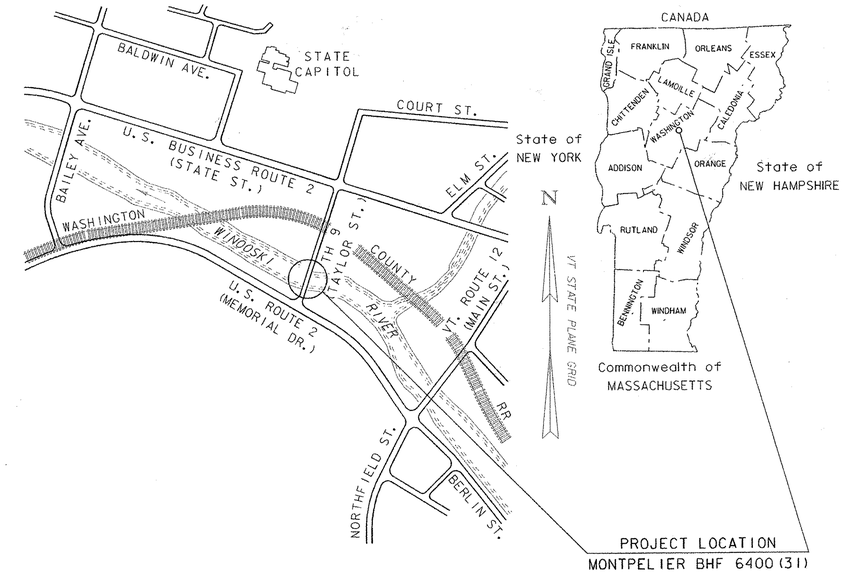

PROPOSED IMPROVEMENT
BRIDGE PROJECT
CITY OF MONTPELIER
COUNTY OF WASHINGTON

ROUTE NO : TH 9 (TAYLOR STREET) BRIDGE NO : 5 (MONTPELIER)

PROJECT LOCATION: LOCATED IN THE COUNTY OF WASHINGTON, CITY OF MONTPELIER, TH 9 (TAYLOR STREET) OVER THE WINOOSKI RIVER, APPROXIMATELY 400+/- FEET SOUTH OF THE JUNCTION OF STATE STREET AND TAYLOR STREET.

PROJECT DESCRIPTION: REHABILITATION OF THE SUPERSTRUCTURE, SUBSTRUCTURE REPAIRS AND RECONSTRUCTION OF THE APPROACHES.

LENGTH OF STRUCTURE : 170.50 FEET
LENGTH OF ROADWAY : 62.25 FEET
LENGTH OF PROJECT : 232.75 FEET

RECORD PLANS

CONTRACTOR: WINTERSET, INC.– LYNDONVILLE, VT
RESIDENT ENGINEER: BOB SUCKERT
CONSTRUCTION BEGAN: DECEMBER 21, 2009
CONSTRUCTION COMPLETE: JUNE 27, 2011
RECORD PLANS BY: BOB SUCKERT & JENNA HYDE

I HEREBY CERTIFY THAT ALL THE CONSTUCTION REQUIRED BY THIS SET OF DRAWINGS HAS BEEN ACCOMPLISHED AS INDICATED HEREIN.

BY _____ RESIDENT ENGINEER
DATE 1-10-13

NOTE: Any further information concerning final quantities, amounts or other details relative to this project may be found at Central Files in the electronic archives.

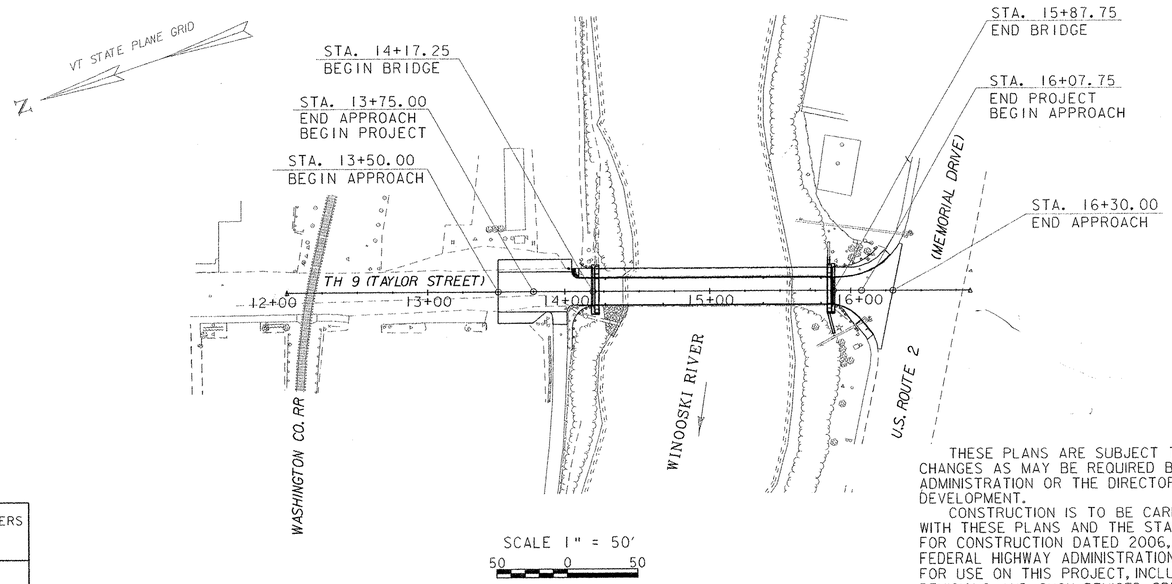

THESE PLANS ARE SUBJECT TO SUCH ENGINEERING CHANGES AS MAY BE REQUIRED BY THE FEDERAL HIGHWAY ADMINISTRATION OR THE DIRECTOR OF PROGRAM DEVELOPMENT.

CONSTRUCTION IS TO BE CARRIED ON IN ACCORDANCE WITH THESE PLANS AND THE STANDARD SPECIFICATIONS FOR CONSTRUCTION DATED 2006, AS APPROVED BY THE FEDERAL HIGHWAY ADMINISTRATION ON JUNE 15, 2006 FOR USE ON THIS PROJECT, INCLUDING ALL SUBSEQUENT REVISIONS AND SUCH REVISED SPECIFICATIONS AND SPECIAL PROVISIONS AS ARE INCORPORATED IN THESE PLANS.

STATE OF VERMONT
VINCENT N. CAMPISI
No. 9303
PROFESSIONAL ENGINEER

PLANS PREPARED BY
Vincent N. Campisi

CHA
CLOUGH HARBOUR & ASSOCIATES LLP

SURVEYED BY : R. GILMAN & P. WINTERS
SURVEYED DATE : JANUARY 20, 2005

DATUM
VERTICAL NAVD 88
HORIZONTAL NAD 83 (96)

DIRECTOR OF PROGRAM DEVELOPMENT
APPROVED Richard Tetreault DATE 10/2/09
PROJECT MANAGER : SUSAN SCRIBNER

PROJECT NAME : MONTPELIER
PROJECT NUMBER : BHF 6400(31)

SHEET 1 OF 63 SHEETS

CONVENTIONAL SYMBOLS

COUNTY LINE
TOWN LINE
LIMITS OF ACCESS
POINT OF ACCESS
FENCE LINE
STONE WALL
TRAVELED WAY
GUARD RAIL
RAILROAD
SURVEY LINE
CULVERT
POWER POLE
TELEPHONE POLE
TREES
CONTROL OF ACCESS
PROPERTY LINE
R.O.W. TAKING LINE
SLOPE RIGHTS
TOP OF CUT
TOE OF SLOPE

FILE NAME =K:\14506\Vest\plans\val4506_title.dgn
DATE/TIME = 9/28/2009
USER = 2952