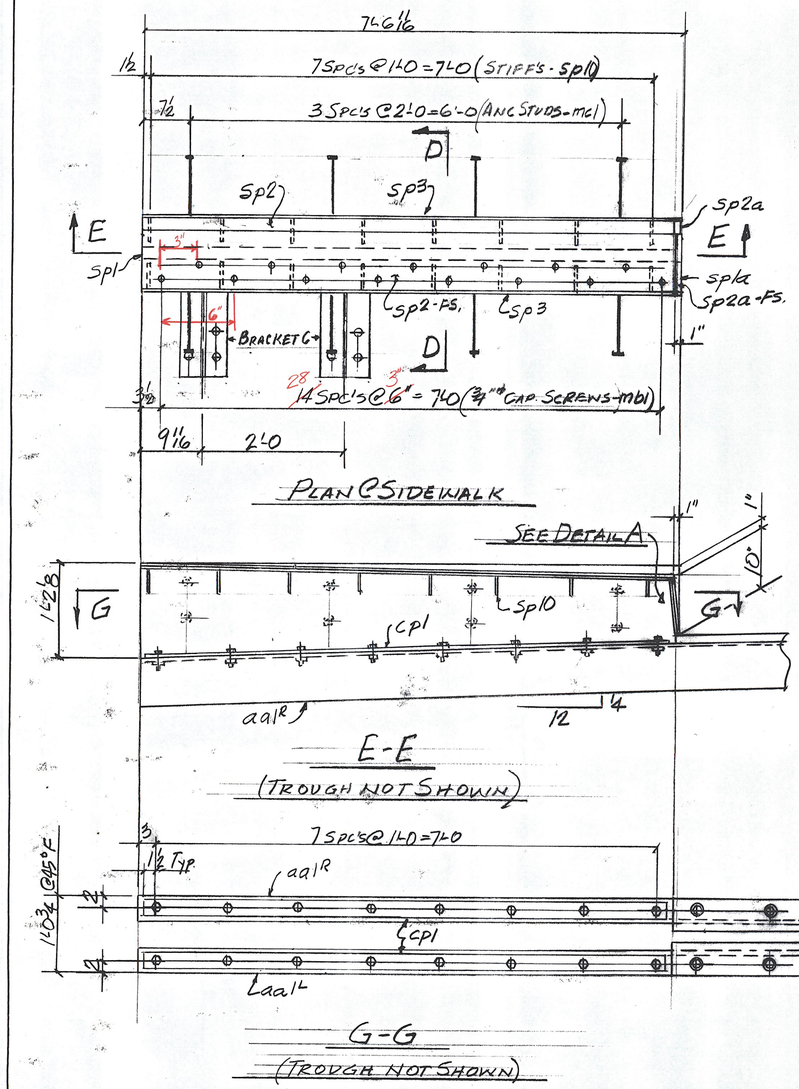

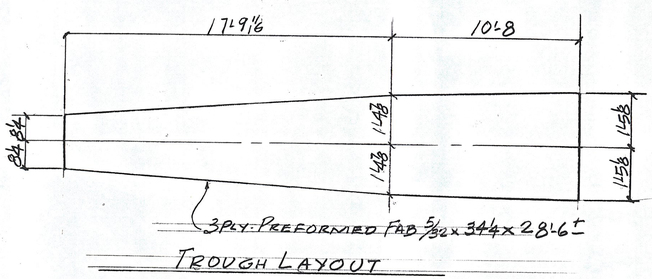

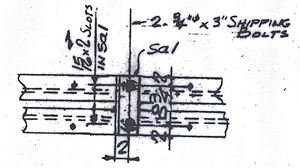

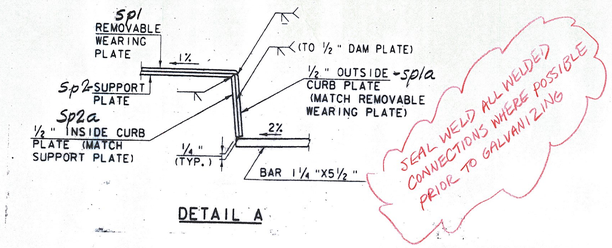

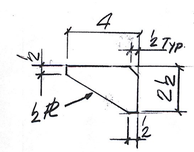

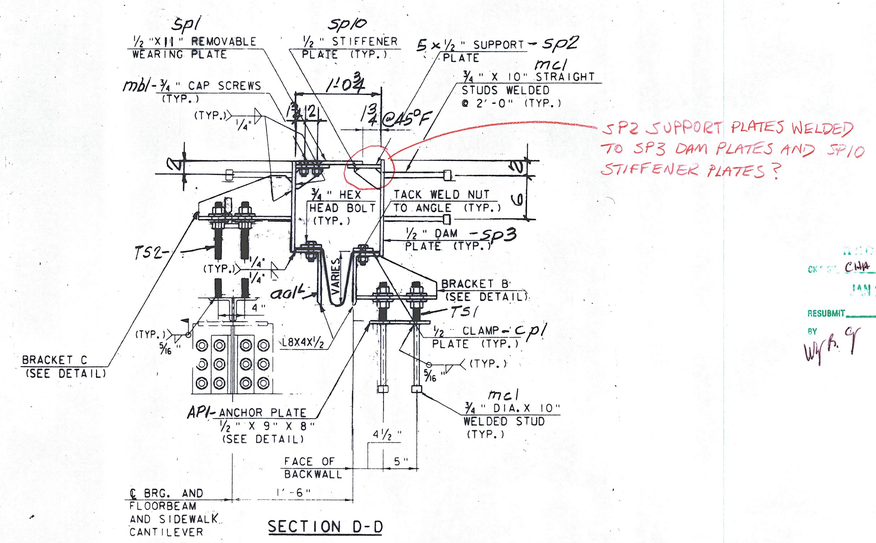

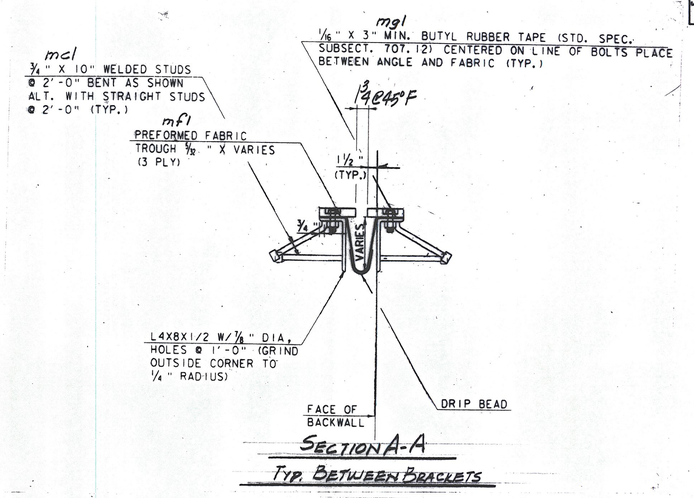

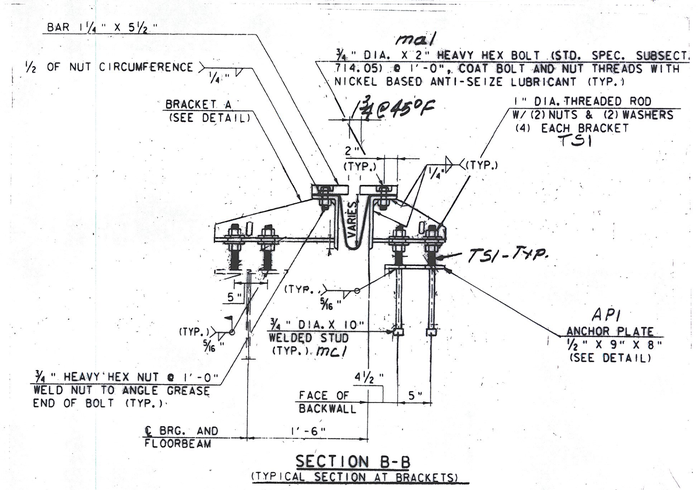

WORK THIS DWG. WITH DWG. J1

REV.	REMARKS	DATE	DWN	CHK	APP	Q.A.	NO.	DIA.	LGT	TYPE	WASHER
	OUT FOR APPROVAL	1/14/10									
	OUT FOR APPROVAL										
	ISSUED TO SHOP										
	FIELD & OFFICE										

PROJECT NO. BHF 6400 (31) STATE PROJECT NO. BRIDGE No.5

MATERIAL: A270 A270A-GRB2 ELECTRODES: SEE PROC HOLES: AS NOTED SHOP BOLTS: 3/4"ϕ

SURFACE PREP. & PAINT: A325-GALV.

GALVANIZE AFTER FAB.

RECEIVED CHK JAN 27 2010 RESUBMIT APPROVED As Noted BY DATE 2/23/10

DESCRIPTION: EXP. JOINT ABUT. 2 - SECTS & DET'S.

JOB: TH9 - TAYLOR ST. BRIDGE No.5 MONTPELIER, VERMONT

CUSTOMER: WINTERSET

	DRAWN BY	DATE
	JPF	1-10
	CHKD BY	
	CR	
	APPROV BY	
	Q.A.	

CASCO BAY STEEL STRUCTURES, INC.
75 SPRING HILL ROAD SACO, MAINE 04072
PHONE (207) 282-7360 FAX. (207) 282-1179

JOB NO. 434 DRG. NO. J2 REV. △