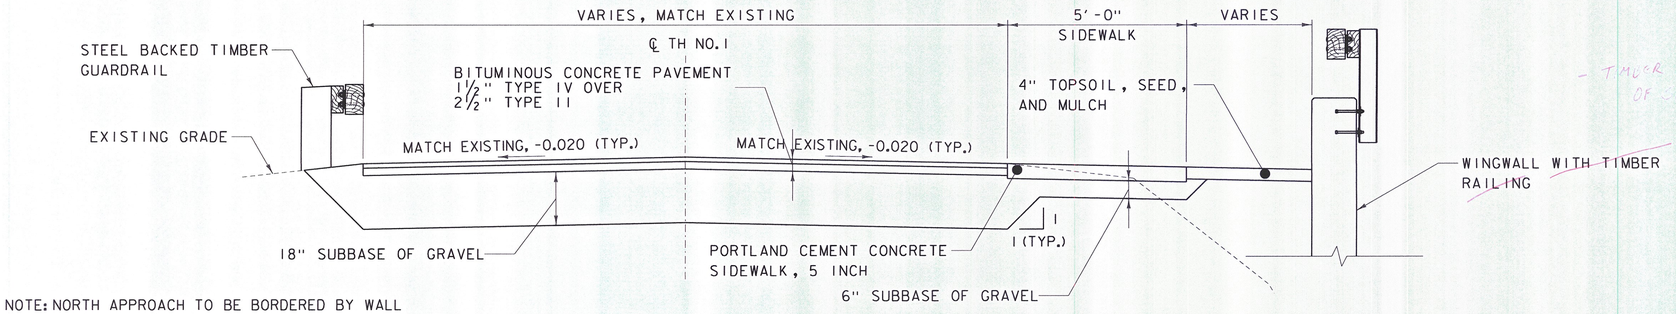

NOTE: NORTH APPROACH TO BE BORDERED BY WALL ON LEFT SIDE. SIDEWALK AND WINGWALL ON RIGHT SIDE AT NORTH APPROACH ONLY.

TYPICAL APPROACH SECTION

SCALE: ½" = 1'-0"

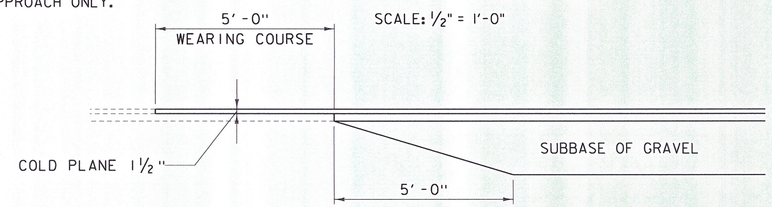

MATERIAL TRANSITION (SOUTH APPROACH)

NOT TO SCALE

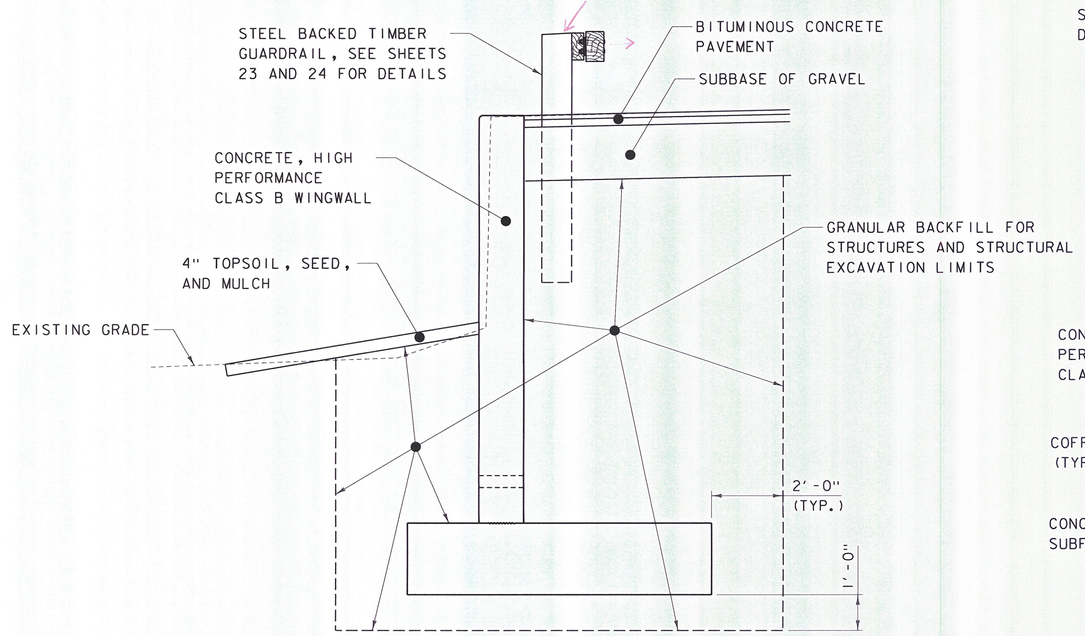

TYPICAL SOUTHEAST WINGWALL SECTION

SCALE: ½" = 1'-0"

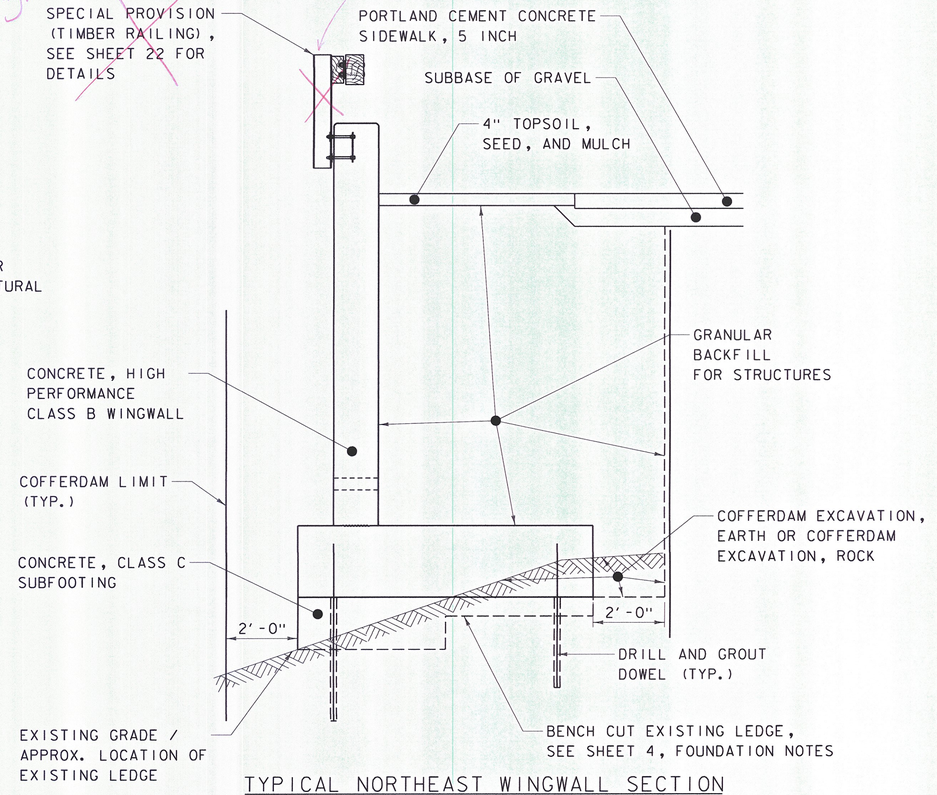

TYPICAL NORTHEAST WINGWALL SECTION

SCALE: ½" = 1'-0"

DATUM
VERTICAL NAVD 88
HORIZONTAL NAD 83 (GPS)

PLOTTED 12/30/2014

I:\620922 - Waitsfield\DESIGN\CADD FILES\620922_TYP.dgn

DuBois & King inc.
ENGINEERING • PLANNING • MANAGEMENT • DEVELOPMENT
6 GREEN TREE DRIVE
SOUTH BURLINGTON, VT 05403
TEL: (802) 878-7661
FAX: (866) 783-7101
www.dubois-king.com
RANDOLPH, VT
SPRINGFIELD, VT
BEDFORD, NH
LACONIA, NH
© Copyright 2014 Dubois & King Inc.

PROFESSIONAL SEAL

FINAL PLANS

TOWN OF WAITSFIELD
9 BRIDGE STREET
WAITSFIELD, VT

VILLAGE COVERED BRIDGE REHAB. & BRIDGE STREET STORMWATER IMPROVEMENTS

SHEET TITLE

TYPICAL SECTIONS

DRAWN BY	DATE
RHB/JDG	DEC. 2014
CHECKED BY	D&K PROJECT #
EPD	620922
PROJ. ENG.	D&K ARCHIVE #
RHB	620922

SHEET NUMBER

8