



**FINAL PLANS**

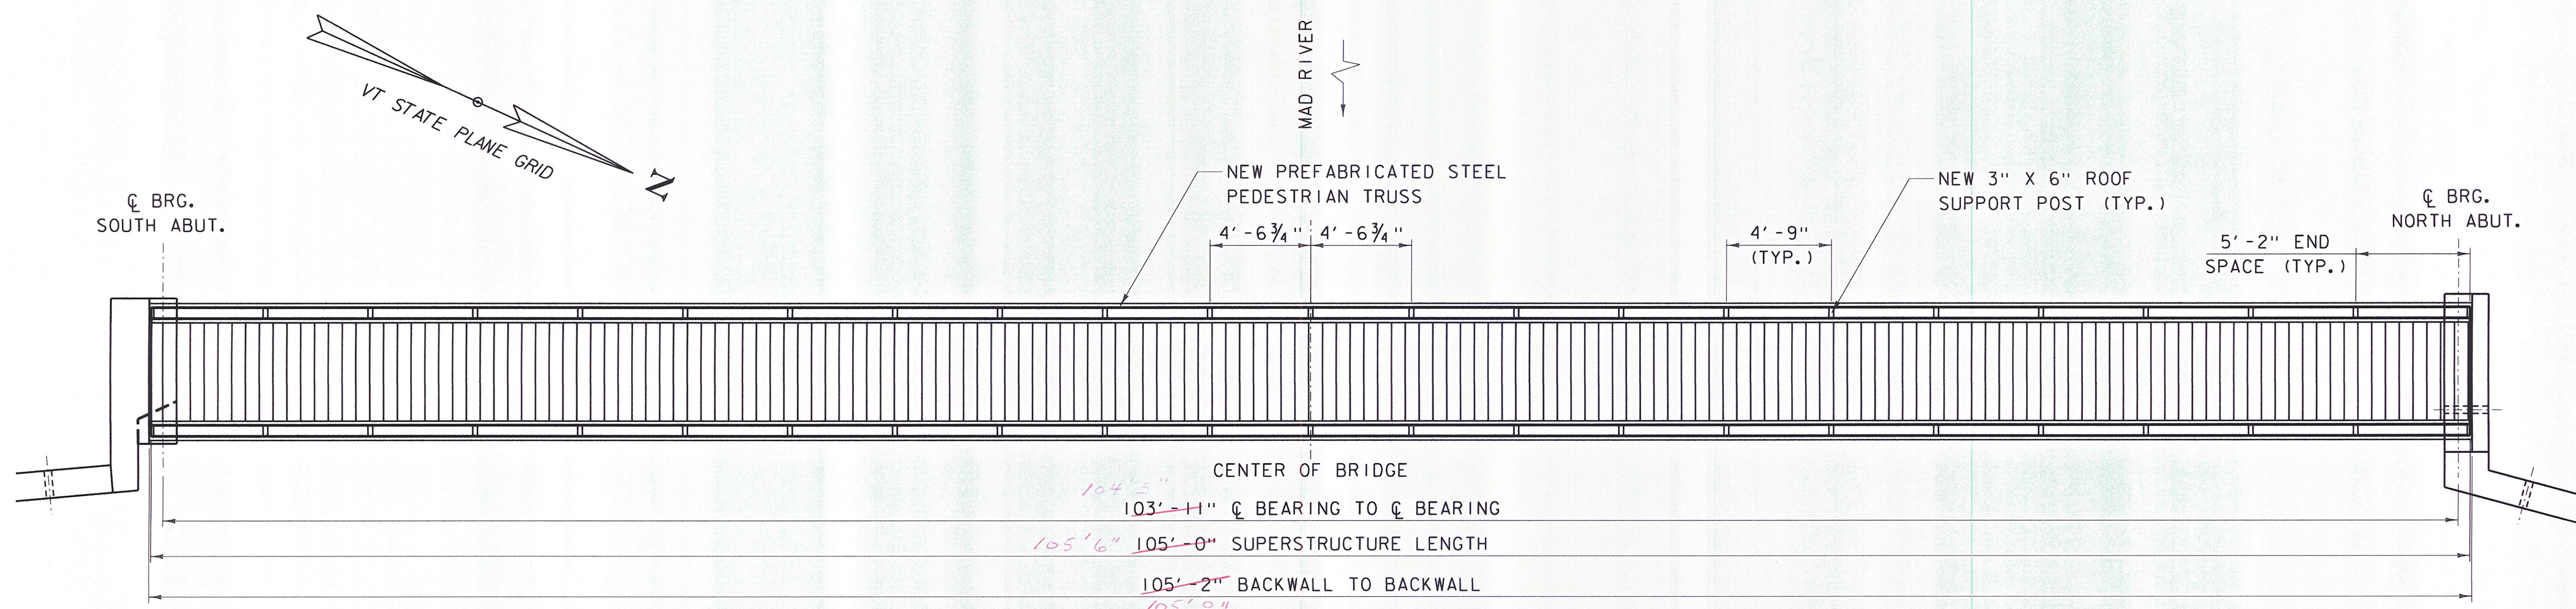

**PEDESTRIAN TRUSS PLAN**

SCALE: 1/4" = 1' - 0"

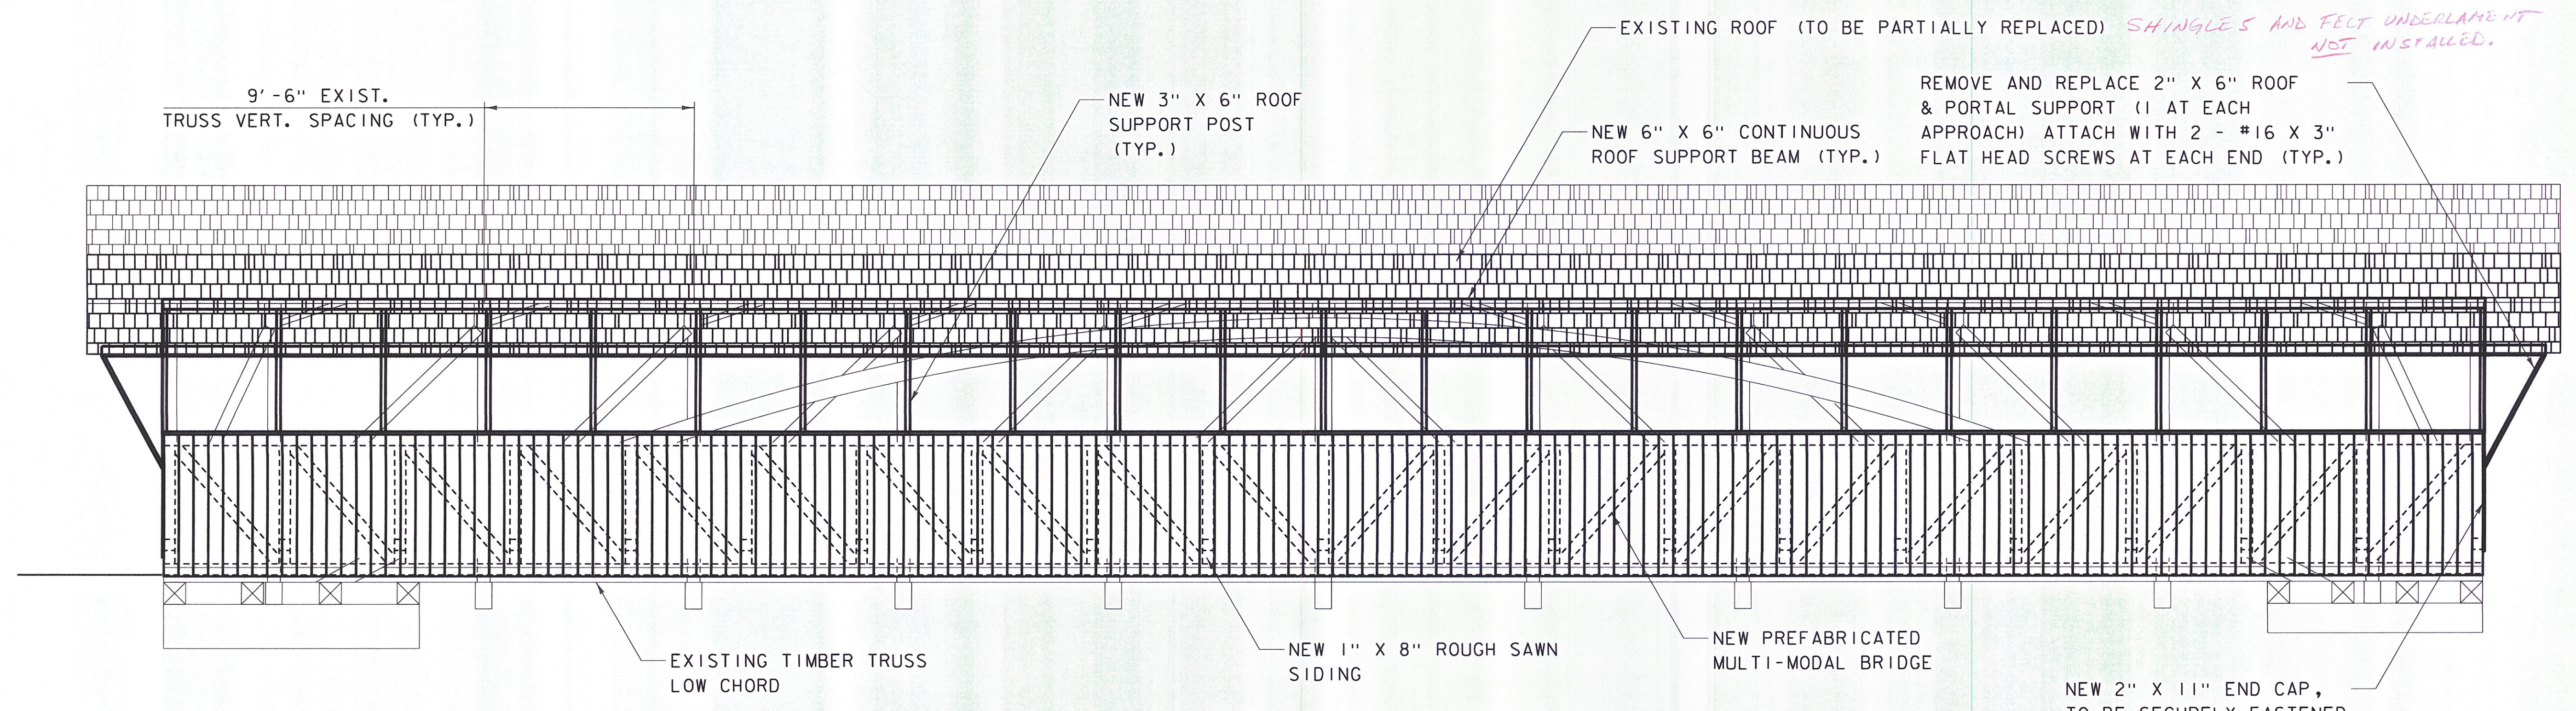

**PEDESTRIAN TRUSS ELEVATION**

SCALE: 1/4" = 1' - 0"

TOWN OF  
WAITSFIELD  
9 BRIDGE STREET  
WAITSFIELD, VT

VILLAGE COVERED  
BRIDGE REHAB. &  
BRIDGE STREET  
STORMWATER  
IMPROVEMENTS

SHEET TITLE  
**SUPERSTRUCTURE  
DETAILS**

DRAWN BY	DATE
RHB/JDG	DEC. 2014
CHECKED BY	D&K PROJECT #
RHD	620922
PROJ. ENG.	D&K ARCHIVE #
RHB	620922

SHEET NUMBER  
**12**  
SHEET 12 OF 30

I:\620922 - Waitsfield\DESIGN\CADD FILES\620922\_SUP.dgn

DATUM  
VERTICAL NAVD 88  
HORIZONTAL NAD 83 (GPS)

PLOTTED 12/30/2014

*Clarke 12/30/15*