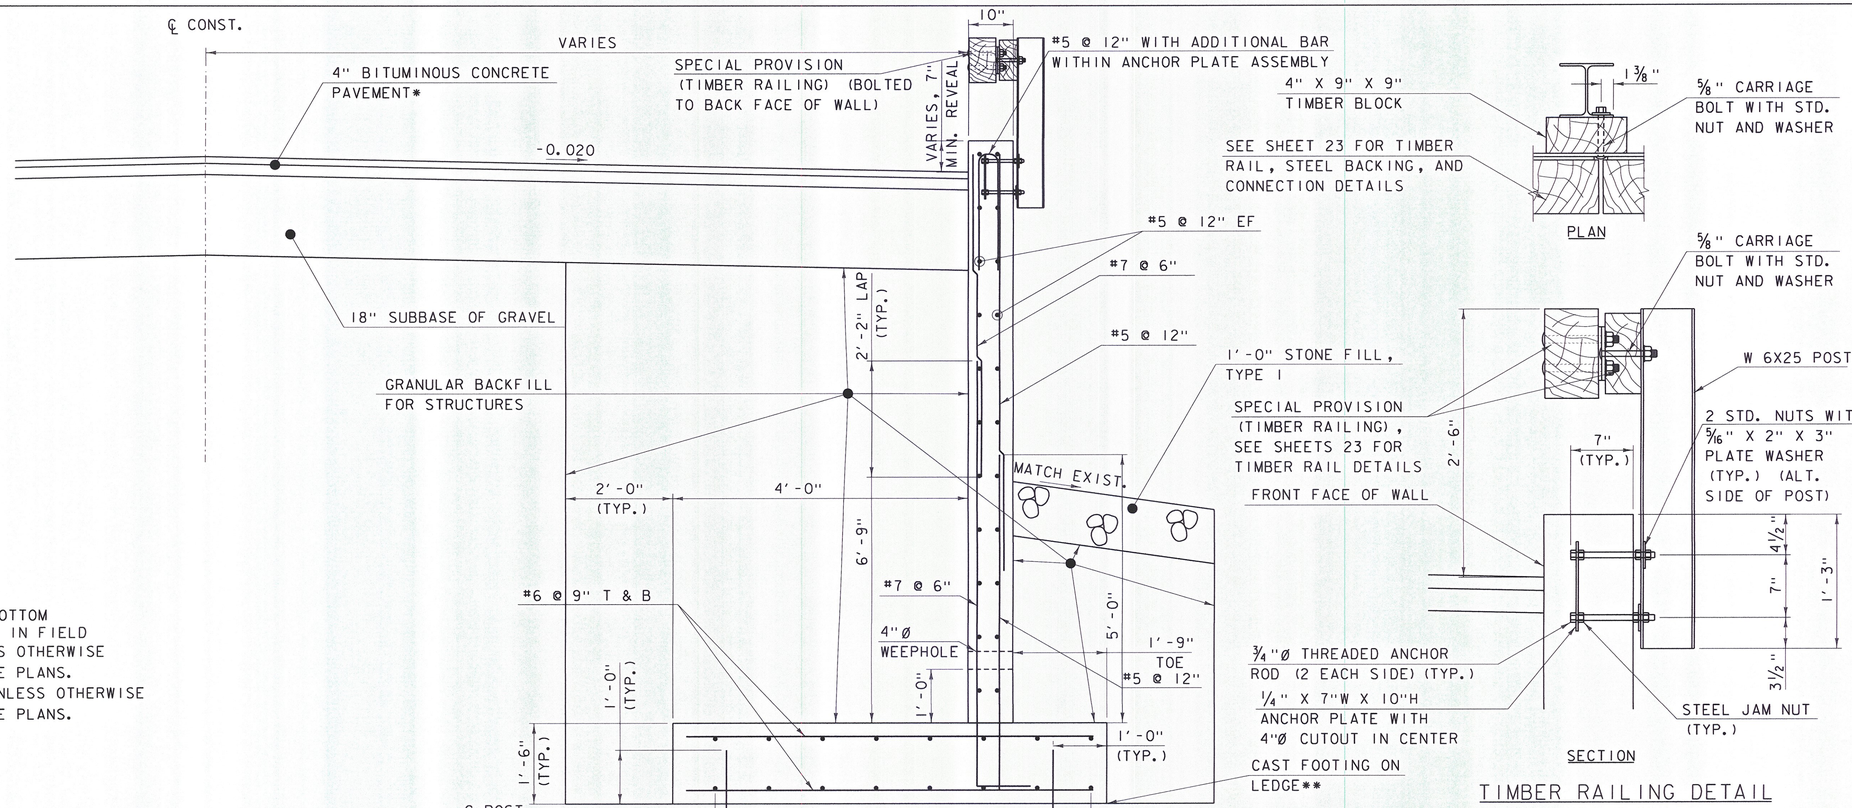

NOTE:

NF = NEAR FACE
FF = FAR FACE
EF = EACH FACE
T & B = TOP & BOTTOM
▲ = CUT TO FIT IN FIELD
3" CLEAR, UNLESS OTHERWISE SPECIFIED ON THE PLANS.
2'-2" BAR LAP UNLESS OTHERWISE SPECIFIED ON THE PLANS.

SECTION A-A

SCALE ¾" = 1'-0"

SECTION

TIMBER RAILING DETAIL

NOT TO SCALE

NOTES: GALVANIZED POSTS & PRESSURE TREATED RAILS.

1. ~~TIMBER RAILING AND POSTS SHALL BE PAINTED TO MATCH ADJOINING EXISTING TIMBER RAIL.~~ PAYMENT SHALL BE MADE INCIDENTAL TO ITEM 900.640, "SPECIAL PROVISION (TIMBER RAILING)".
2. POSTS SHALL BE VERTICAL.

EXIST. WALL JOINT DETAIL

NOT TO SCALE

WALL ELEVATION

SCALE ½" = 1'-0"

** FOOTING TO BE FOUNDED ON COMPETENT BEDROCK OR 6'-0" BELOW GRADE. THE TOP AND BOTTOM OF FOOTING ELEVATIONS PROVIDED ARE BASED ON 6'-0" BELOW GRADE. SEE SHEET 4, FOUNDATION NOTES IF LEDGE IS ENCOUNTERED PRIOR TO 6'-0" BELOW GRADE AND AS TO WHETHER A SUBFOOTING IS REQUIRED. IF LEDGE IS NOT ENCOUNTERED, THE BOTTOM OF FOOTING ELEVATIONS PROVIDED SHALL BE USED AND THE FOOTING SHALL BE CONSTRUCTED ON 1'-0" DEPTH OF GRANULAR BACKFILL FOR STRUCTURES AND DOWELS OMITTED. ALL EXCAVATION FOR THE BRIDGE ST. RETAINING WALL SHALL BE PAID FOR UNDER ITEM 204.25, "STRUCTURE EXCAVATION".

NOTE: REINFORCING STEEL AND RAILING NOT SHOWN IN ELEVATION VIEW FOR CLARITY.

DATUM	
VERTICAL	NAVD 88
HORIZONTAL	NAD 83 (GPS)

PLOTTED 7/31/2015

DuBois & King inc.
ENGINEERING • PLANNING • MANAGEMENT • DEVELOPMENT
6 GREEN TREE DRIVE
SOUTH BURLINGTON, VT 05403
TEL: (802) 878-7661
FAX: (866) 783-7101
www.dubois-king.com
RANDOLPH, VT
SPRINGFIELD, VT
BEDFORD, NH
LACONIA, NH

© Copyright 2014 Dubois & King Inc.

PROFESSIONAL SEAL

FINAL PLANS

NO.	DATE	DESCRIPTION	BY	CKD
1	7/31/15	WALL UPDATES	PCB	EPD

TOWN OF WAITSFIELD
9 BRIDGE STREET
WAITSFIELD, VT

VILLAGE COVERED BRIDGE REHAB. & BRIDGE STREET STORMWATER IMPROVEMENTS

SHEET TITLE
BRIDGE STREET NORTHWEST RETAINING WALL - TYPICAL SECTION & ELEVATION

DRAWN BY	DATE
RHB/JDG	DEC. 2014
CHECKED BY	D&K PROJECT #
EPD	620922
PROJ. ENG.	D&K ARCHIVE #
RHB	620922

SHEET NUMBER
22

h:\620922 - Waitsfield\DESIGN\CADD FILES\620922_WALLBDR_NEW.dgn