CONSTRUCT DRIVE
CLEMENT ROAD STA 22+19.5 RT PAVED, 20.7' WIDE

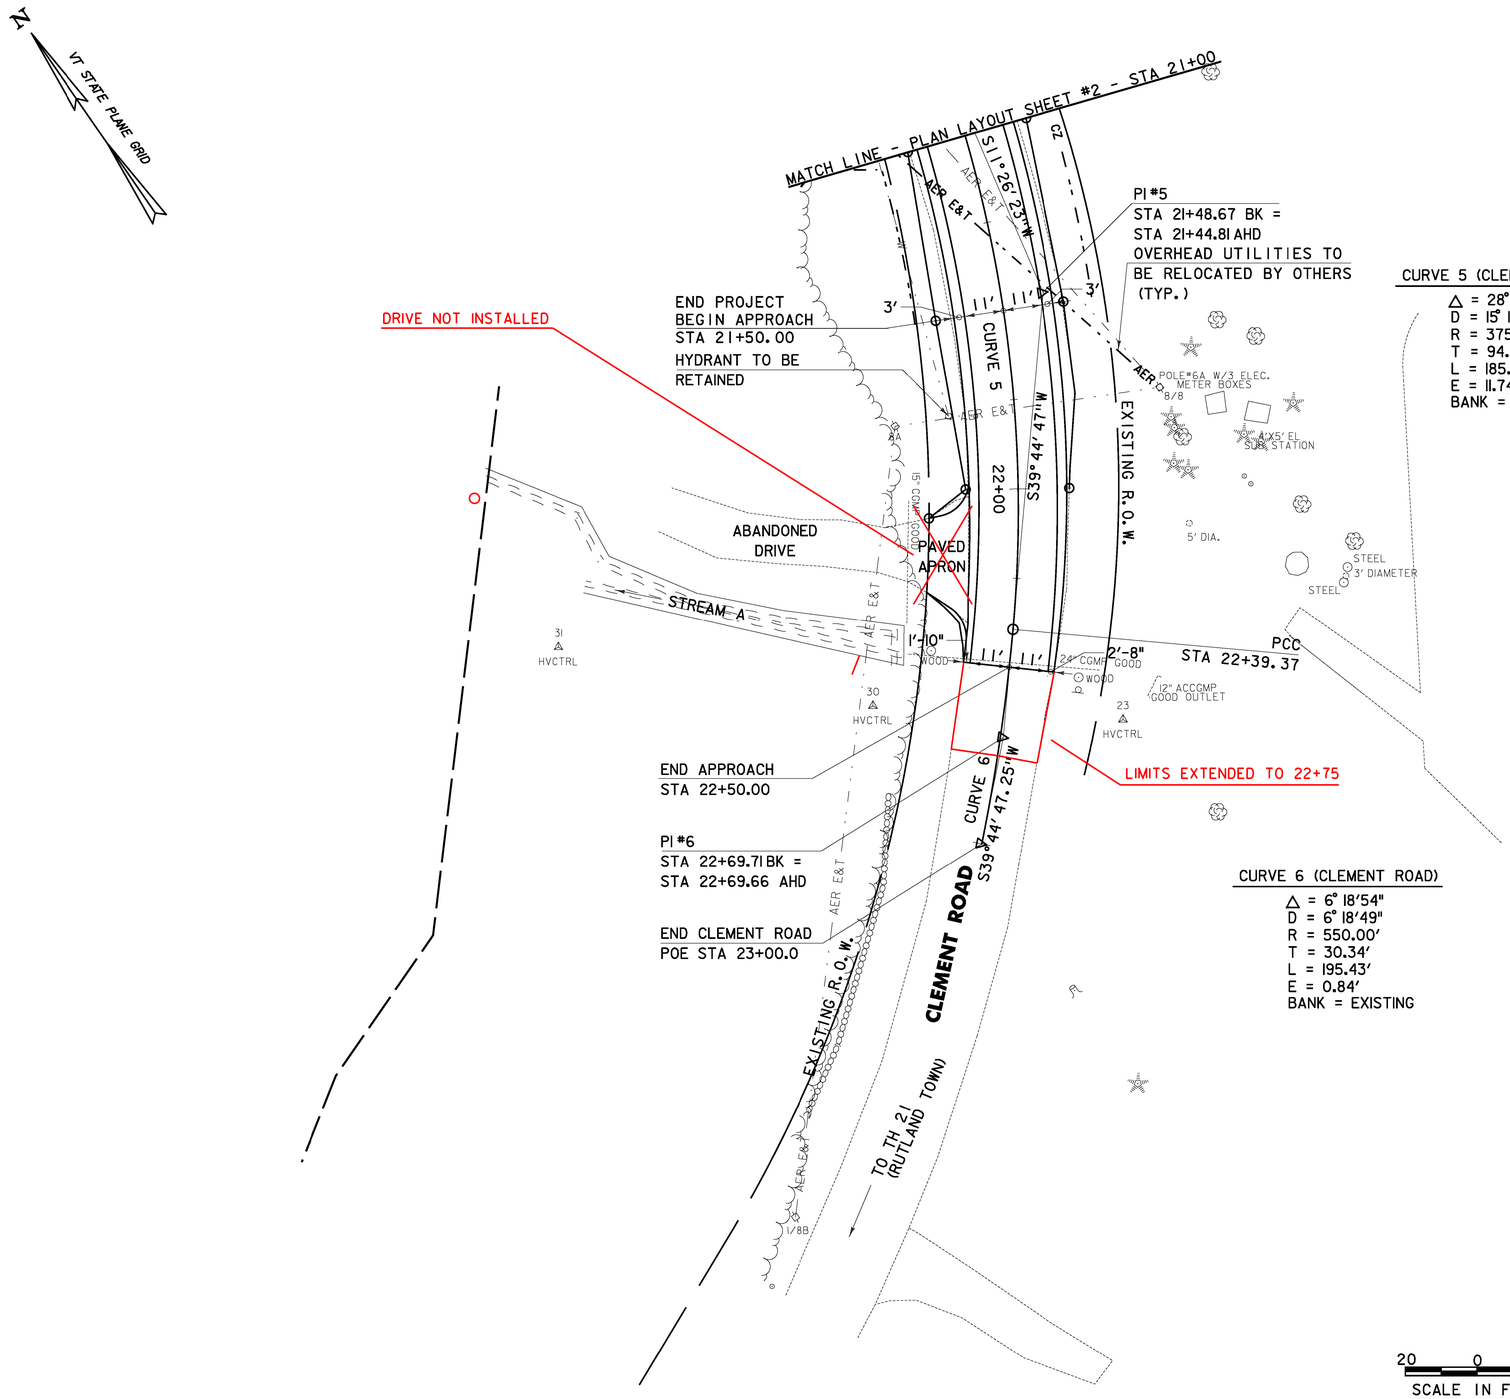

CURVE 5 (CLEMENT ROAD)

Δ = 28° 18'24"
D = 15° 16'44"
R = 375.00'
T = 94.56'
L = 185.27'
E = 11.74'
BANK = TRANSITION

CURVE 6 (CLEMENT ROAD)

Δ = 6° 18'54"
D = 6° 18'49"
R = 550.00'
T = 30.34'
L = 195.43'
E = 0.84'
BANK = EXISTING

20 0 20
SCALE IN FEET

CHA

PLAN LAYOUT SHEET #4

PROJECT NAME: RUTLAND CITY
PROJECT NUMBER: BRF 3000 (19)

PROJECT LEADER: M.D.S.
DESIGNED BY: C.R.H.
DWG. NO.: L-4

PLOT DATE: 6/30/2014
DRAWN BY: C.R.H.
CHECKED BY: D.E.G.
SHEET 36 OF 245

FILE NAME = V:\Projects\ANY\K2\20615\CADD\MSTN\08_0916\consultants\z08_0916bdrnudgn
DATE/TIME = 6/30/2014
USER = 4916