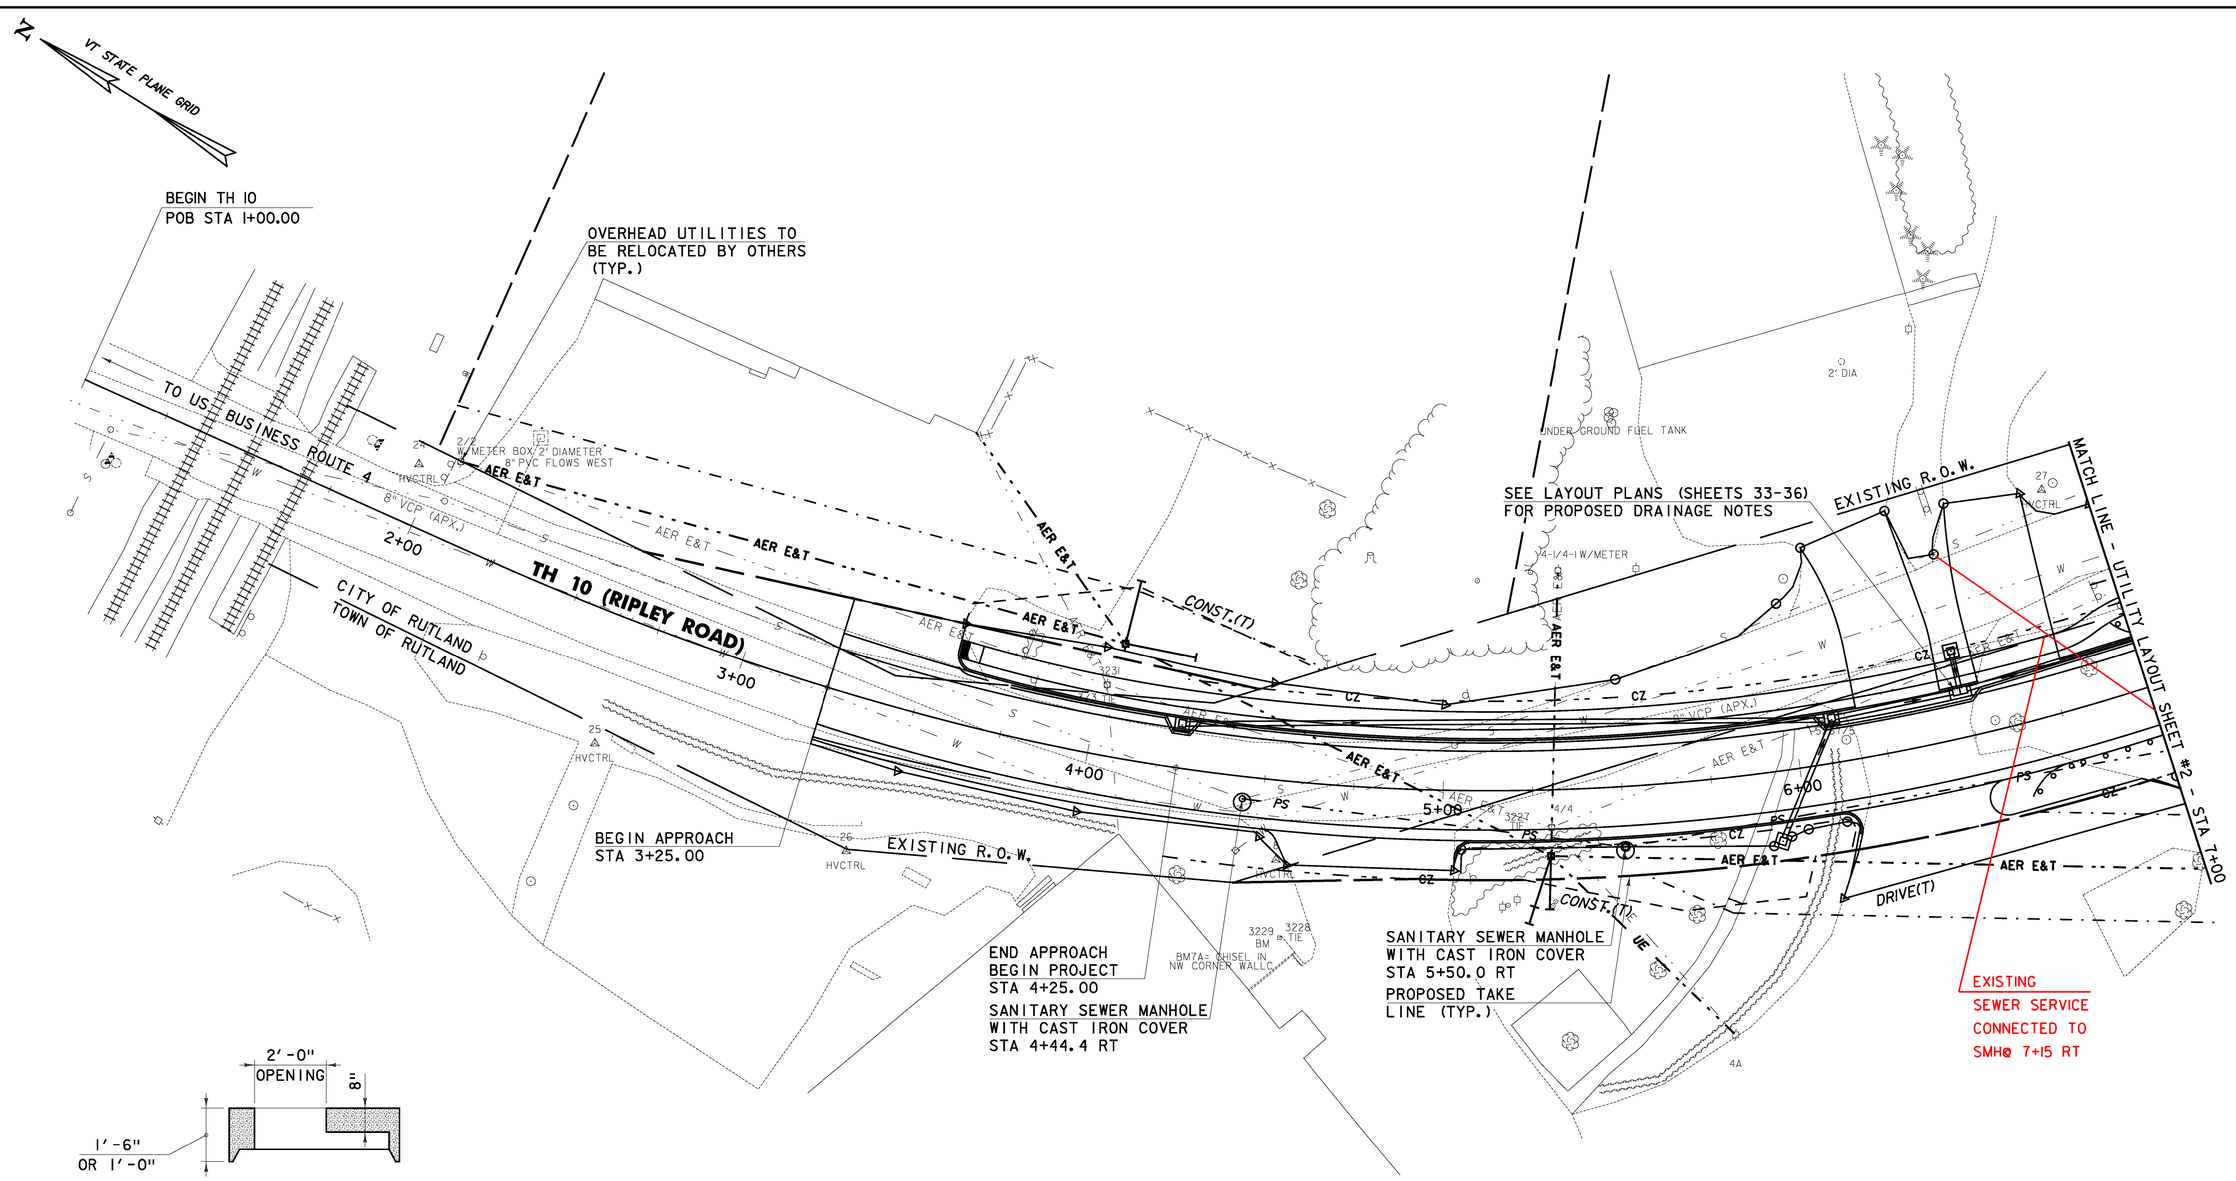

PRECAST REINFORCED CONCRETE
FLAT TOP
NOT TO SCALE

SEE SHEET 33 FOR CHANGES TO DRAINAGE WORK

NOTES:

1. SANITARY SEWER CONSTRUCTION SHALL BE IN CONFORMANCE WITH VTRANS STD. D-22 AND SECTIONS 604 AND 628.
2. THE PROPOSED SANITARY SEWER MANHOLE AT STA 5+50.0 RT SHALL REQUIRE A PRECAST REINFORCED CONCRETE FLAT TOP TO BE SUBSTITUTED FOR THE PRECAST CONCRETE MANHOLE CONE SHOWN ON VTRANS STD. D-22. ALL OTHER MANHOLE ELEMENTS SHALL CONFORM TO VTRANS STD. D-22. SEE PRECAST REINFORCED CONCRETE FLAT TOP DETAIL, THIS SHEET.

604.22 SANITARY SEWER MANHOLE
TH 10 STA 4+44.4 RT (1 EACH)
TH 10 STA 5+50.0 RT (1 EACH)

604.56 CAST IRON COVER WITH FRAME, SEWER
TH 10 STA 4+44.4 RT (1 EACH)
TH 10 STA 5+50.0 RT (1 EACH)

628.28 DUCTILE IRON PIPE, CEMENT-LINED (8")
TH 10 STA 4+44.4 LT - STA 7+00.0 RT (262.1 LF)

20 0 20
SCALE IN FEET

CHA

UTILITY LAYOUT SHEET #1

PROJECT NAME: RUTLAND CITY
PROJECT NUMBER: BRF 3000 (19)

PROJECT LEADER: M.D.S.
DESIGNED BY: C.R.H.
DWG. NO.: UP-1

PLOT DATE: 6/30/2014
DRAWN BY: C.R.H.
CHECKED BY: D.E.G.
SHEET 43 OF 245

FILE NAME = V:\Projects\ANY\K2\28615\CADD\MSTN\08_@96\consultants\x08_@96bdr-up.dgn
DATE/TIME = 6/30/2014
USER = 4916