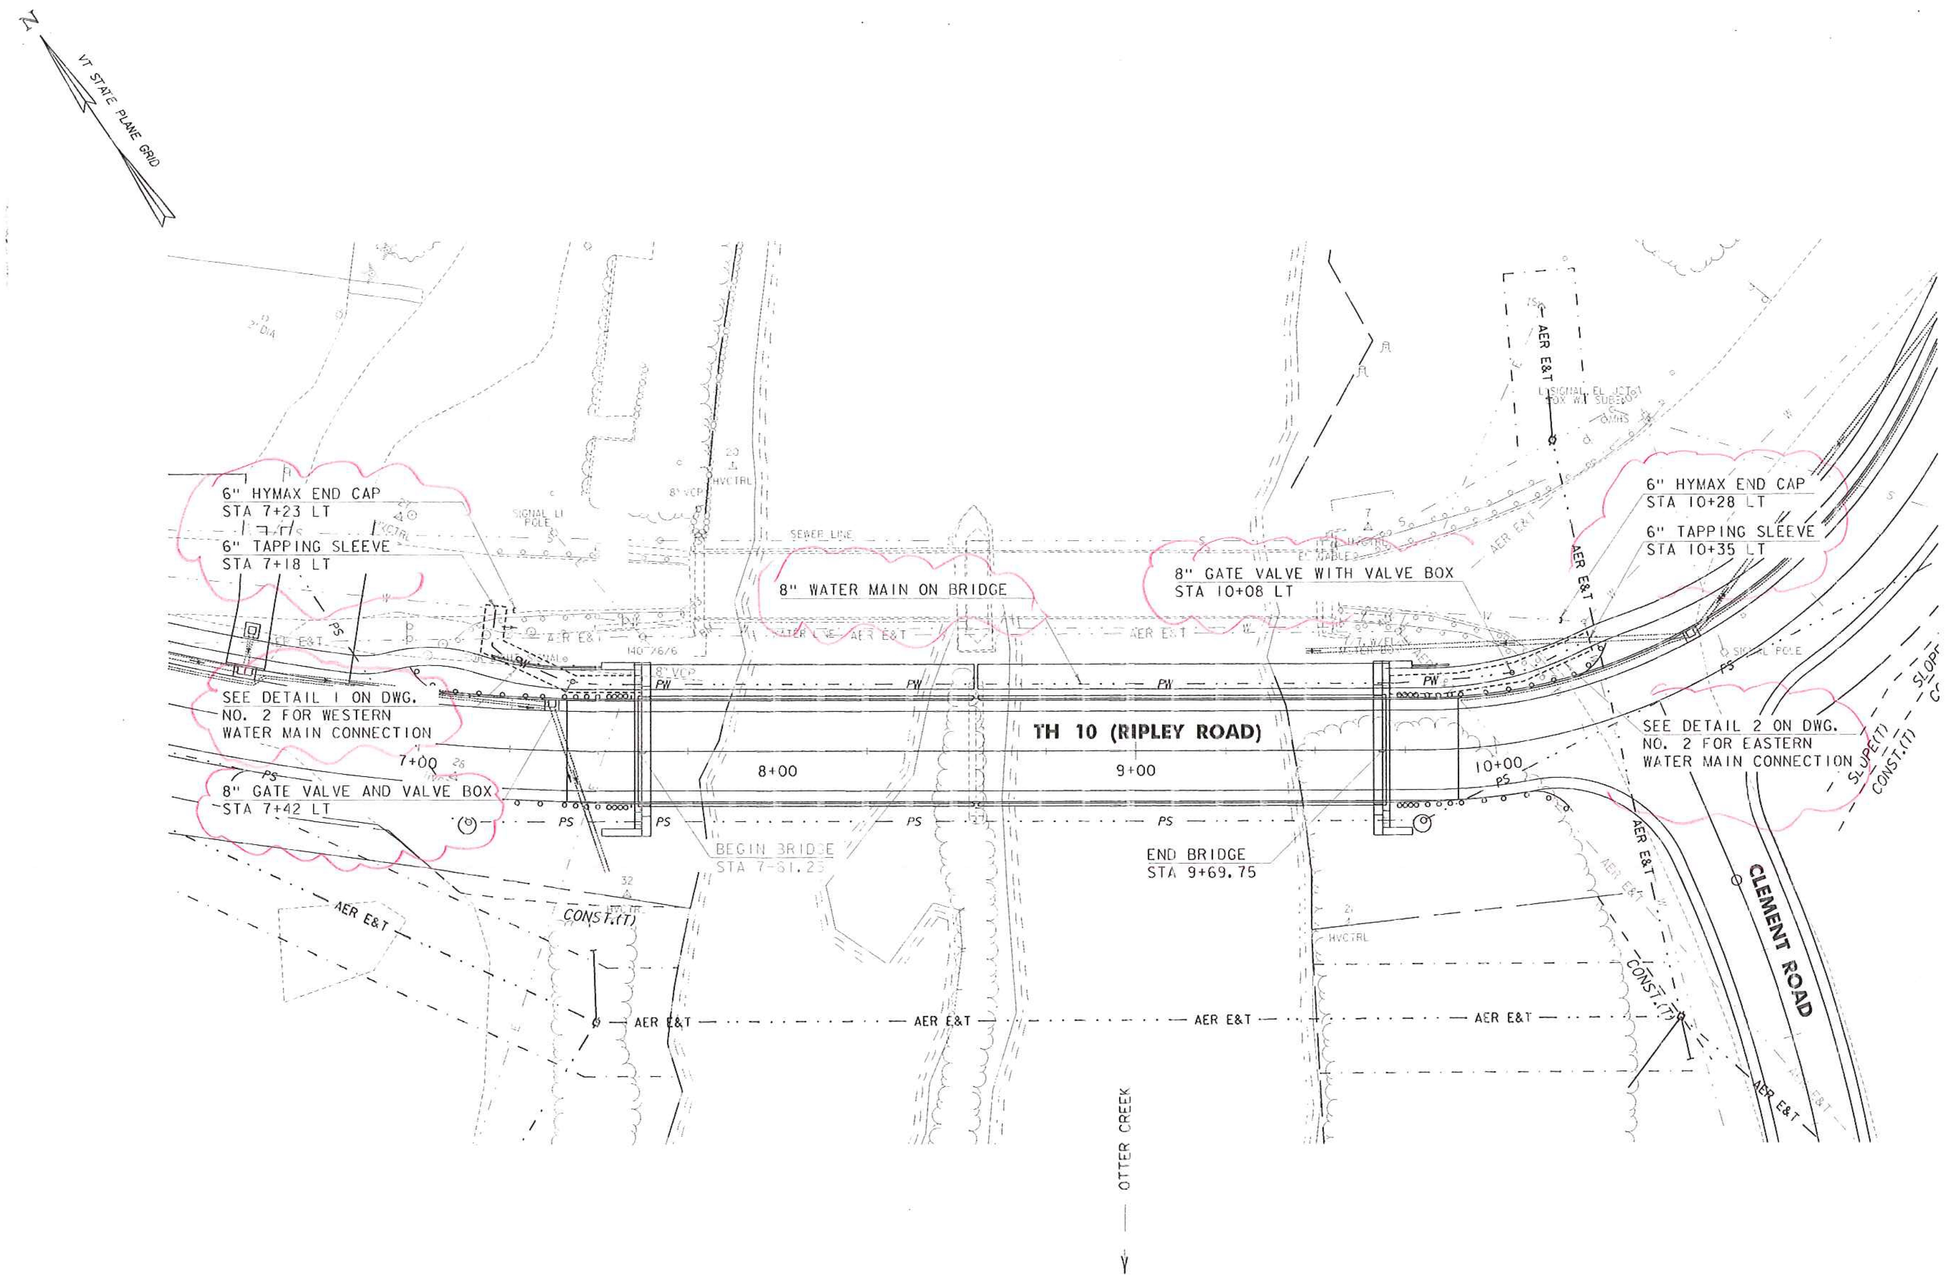

20 0 20
SCALE IN FEET

CHA

WATER MAIN AS-BUILT

PROJECT NAME: RUTLAND CITY	
PROJECT NUMBER: BRF 3000 (19)	
PROJECT LEADER: M.D.S.	PLOT DATE: 4/19/2017
DESIGNED BY: C.R.H.	DRAWN BY: D.B.T.
DWG. NO.: 1	CHECKED BY: D.E.G.
	SHEET 44A OF 2

FILE NAME = V:\Projects\ANY\K2\20615\CADD\MSTN\08_896\consultants\As-Builts\c08_896b-wpdgn
DATE/TIME = 4/19/2017
USER = 9401