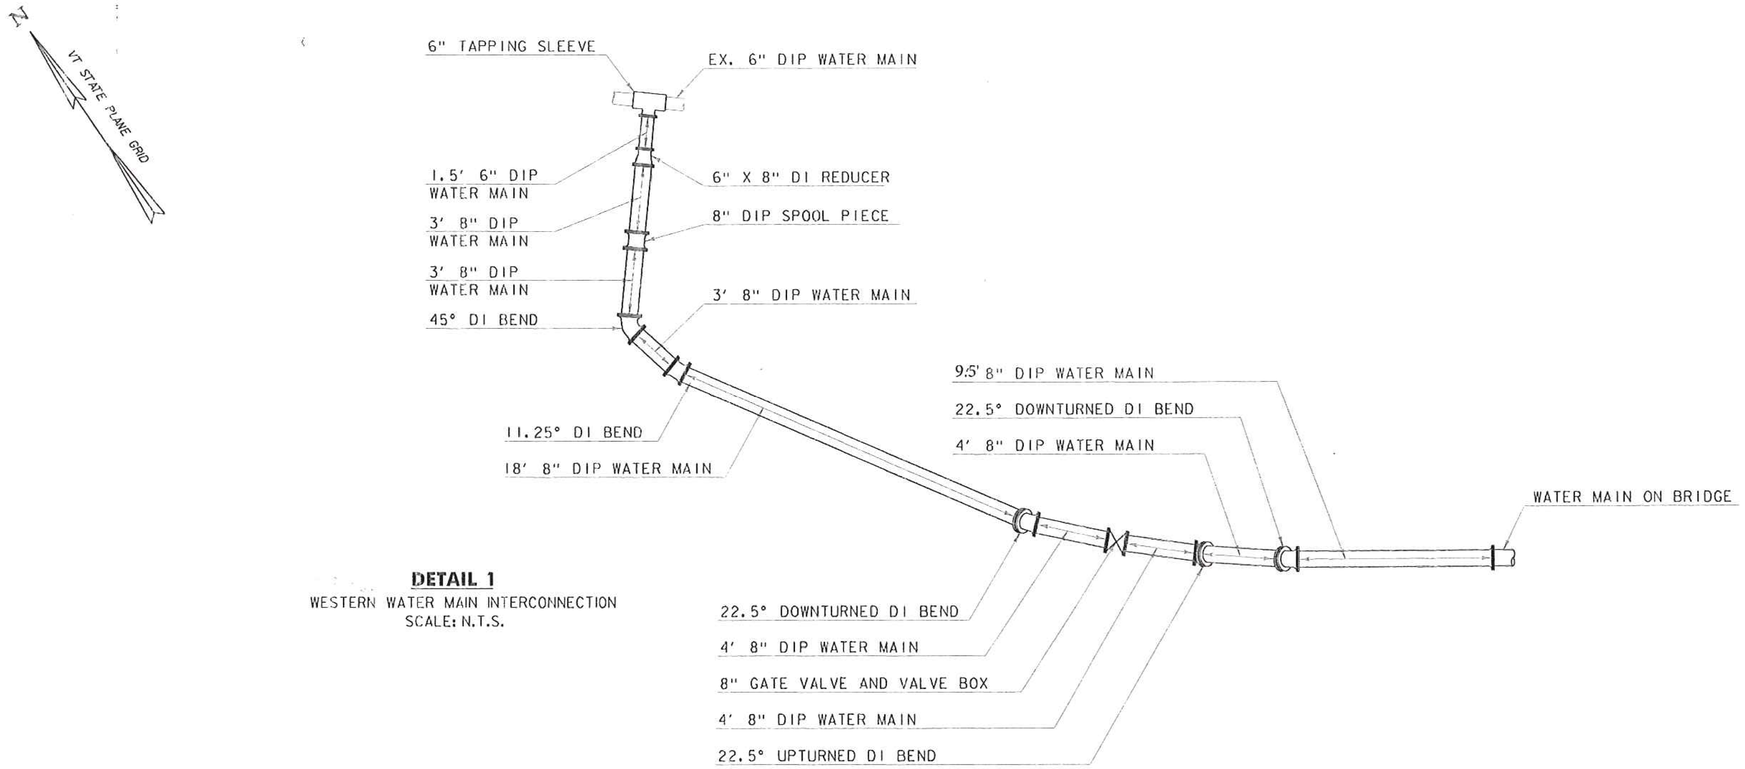

DETAIL 1
WESTERN WATER MAIN INTERCONNECTION
SCALE: N.T.S.

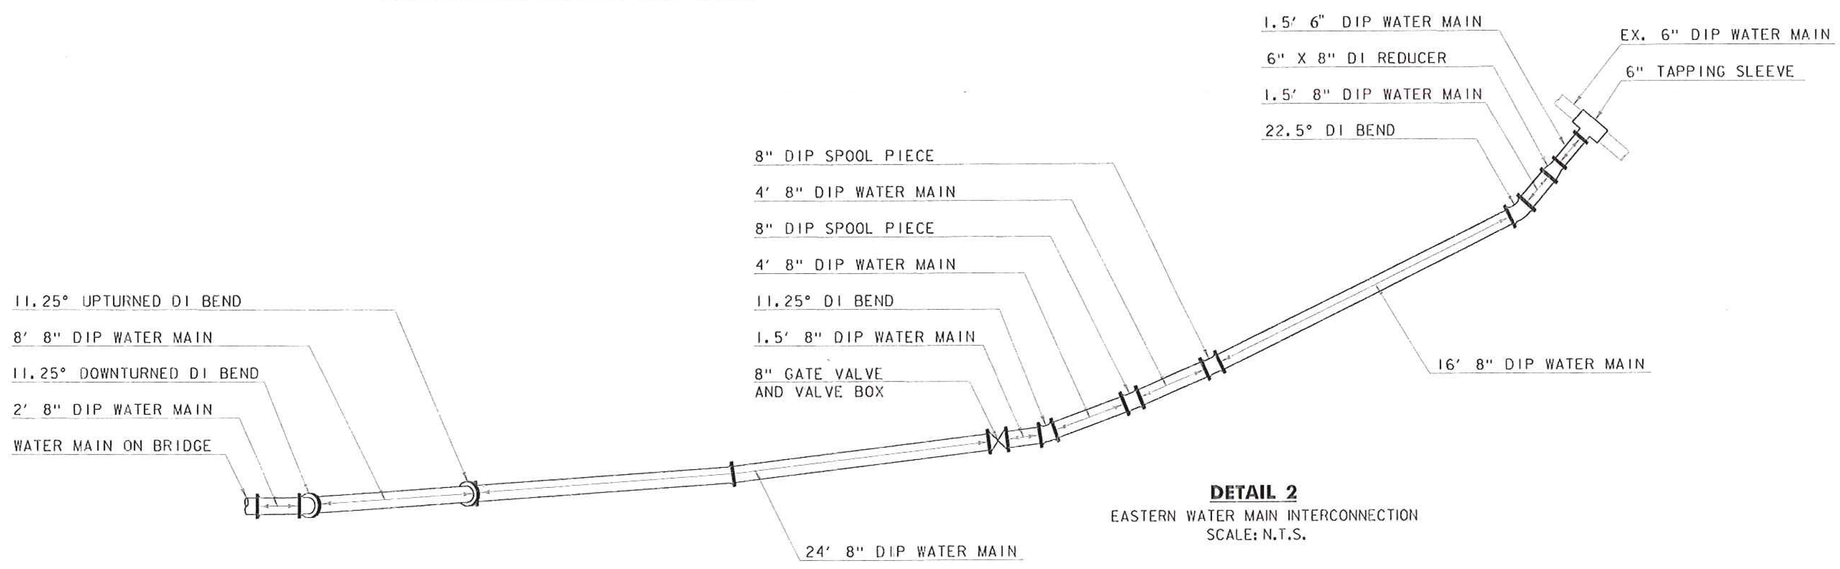

DETAIL 2
EASTERN WATER MAIN INTERCONNECTION
SCALE: N.T.S.

FILE NAME = V:\Projects\ANY\K2\20615\CADD\MSTN\08_896\consultants\As-Built\s08_896sdnsdesign
DATE/TIME = 4/20/2017
USER = 5480

CHA

WATER MAIN AS-BUILT DETAILS	PROJECT NAME: RUTLAND CITY PROJECT NUMBER: BRF 3000 (19)	
	PROJECT LEADER: M.D.S. DESIGNED BY: C.R.H. DWG. NO.: 2	PLOT DATE: 4/20/2017 DRAWN BY: D.B.T. CHECKED BY: D.E.G. SHEET 9/8 OF 2