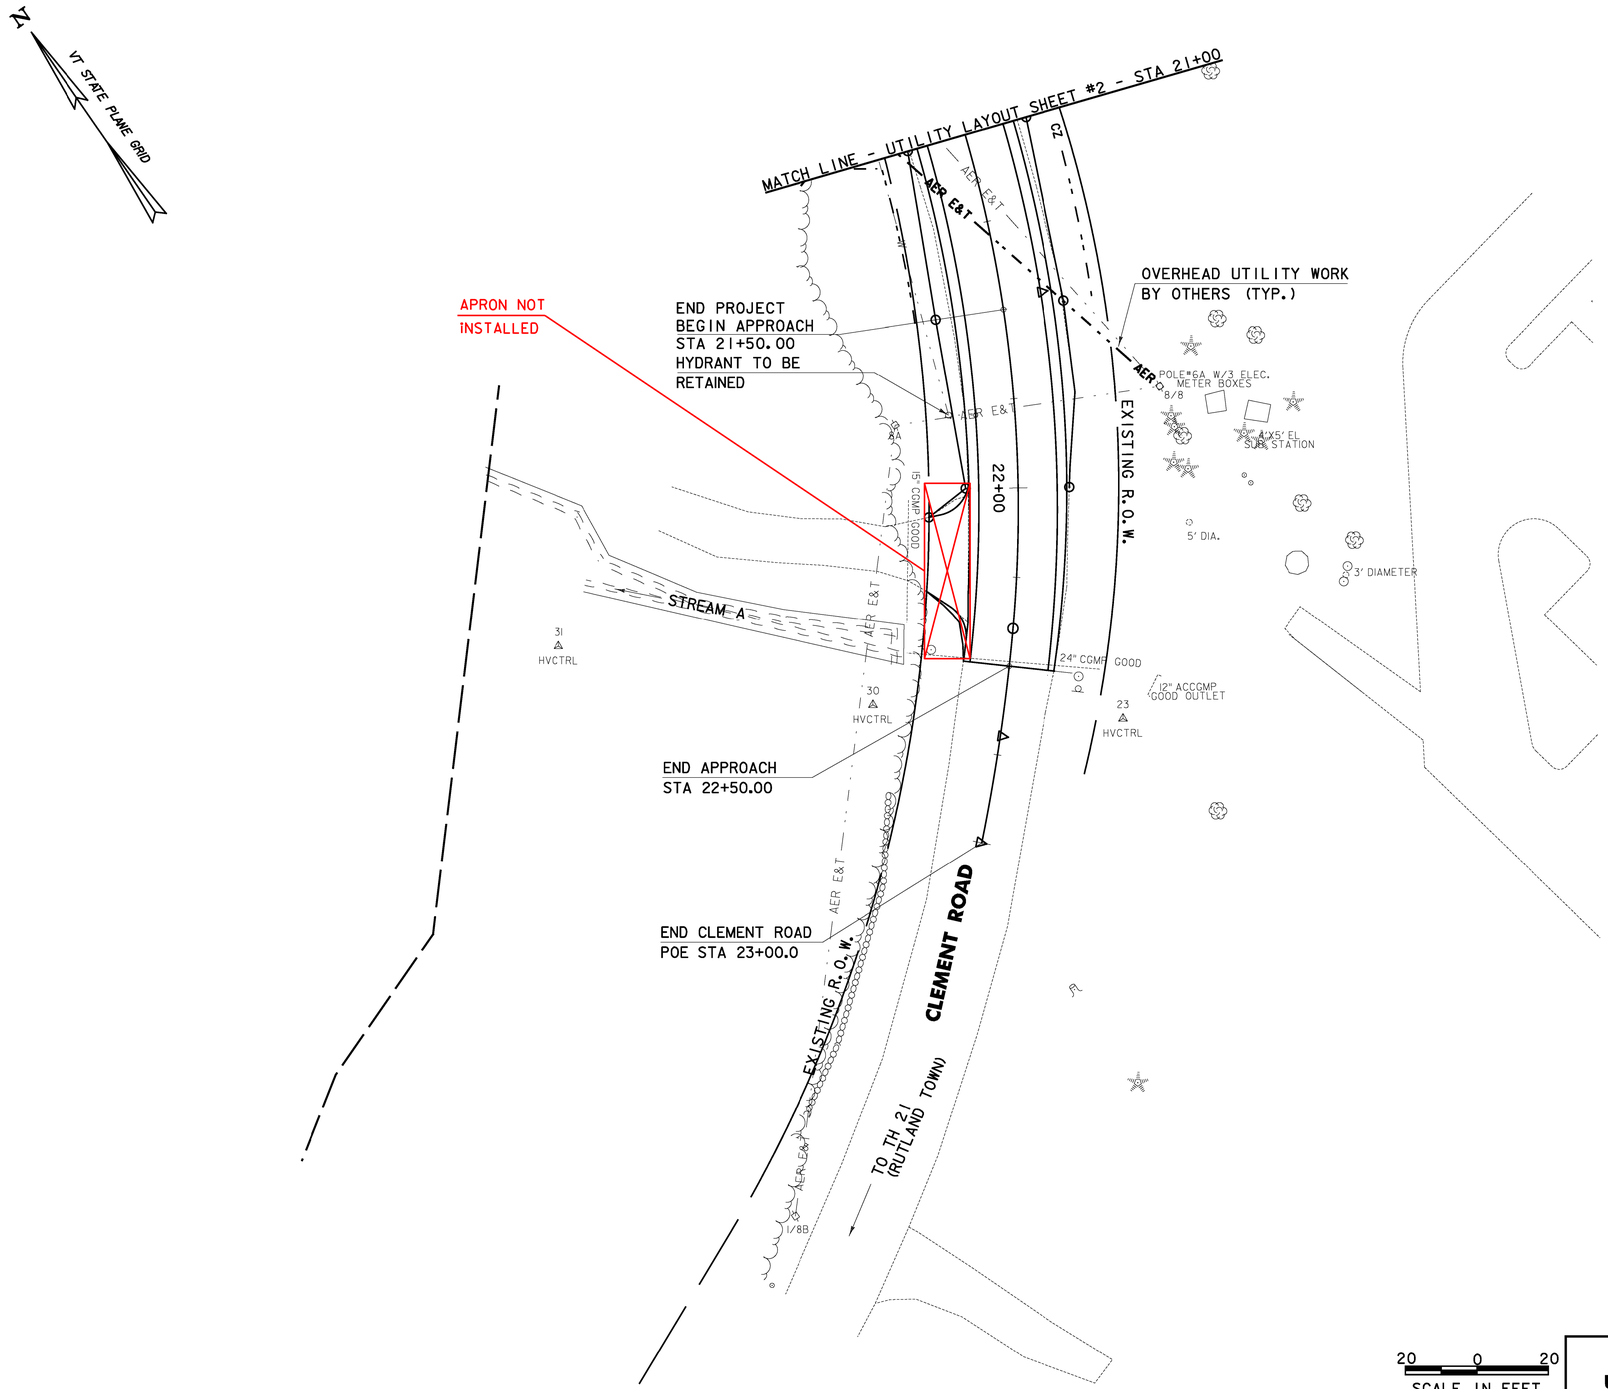

20 0 20
SCALE IN FEET

CHA

UTILITY LAYOUT SHEET #4

PROJECT NAME: RUTLAND CITY
PROJECT NUMBER: BRF 3000 (19)

PROJECT LEADER: M.D.S.
DESIGNED BY: C.R.H.
DWG. NO.: UP-4

PLOT DATE: 6/30/2014
DRAWN BY: C.R.H.
CHECKED BY: D.E.G.
SHEET 46 OF 245

FILE NAME = V:\Projects\ANY\K2\20615\CADD\MSTN\09_0916\consultants\k09_0916bdr-up.dgn
DATE/TIME = 6/30/2014
USER = 4918