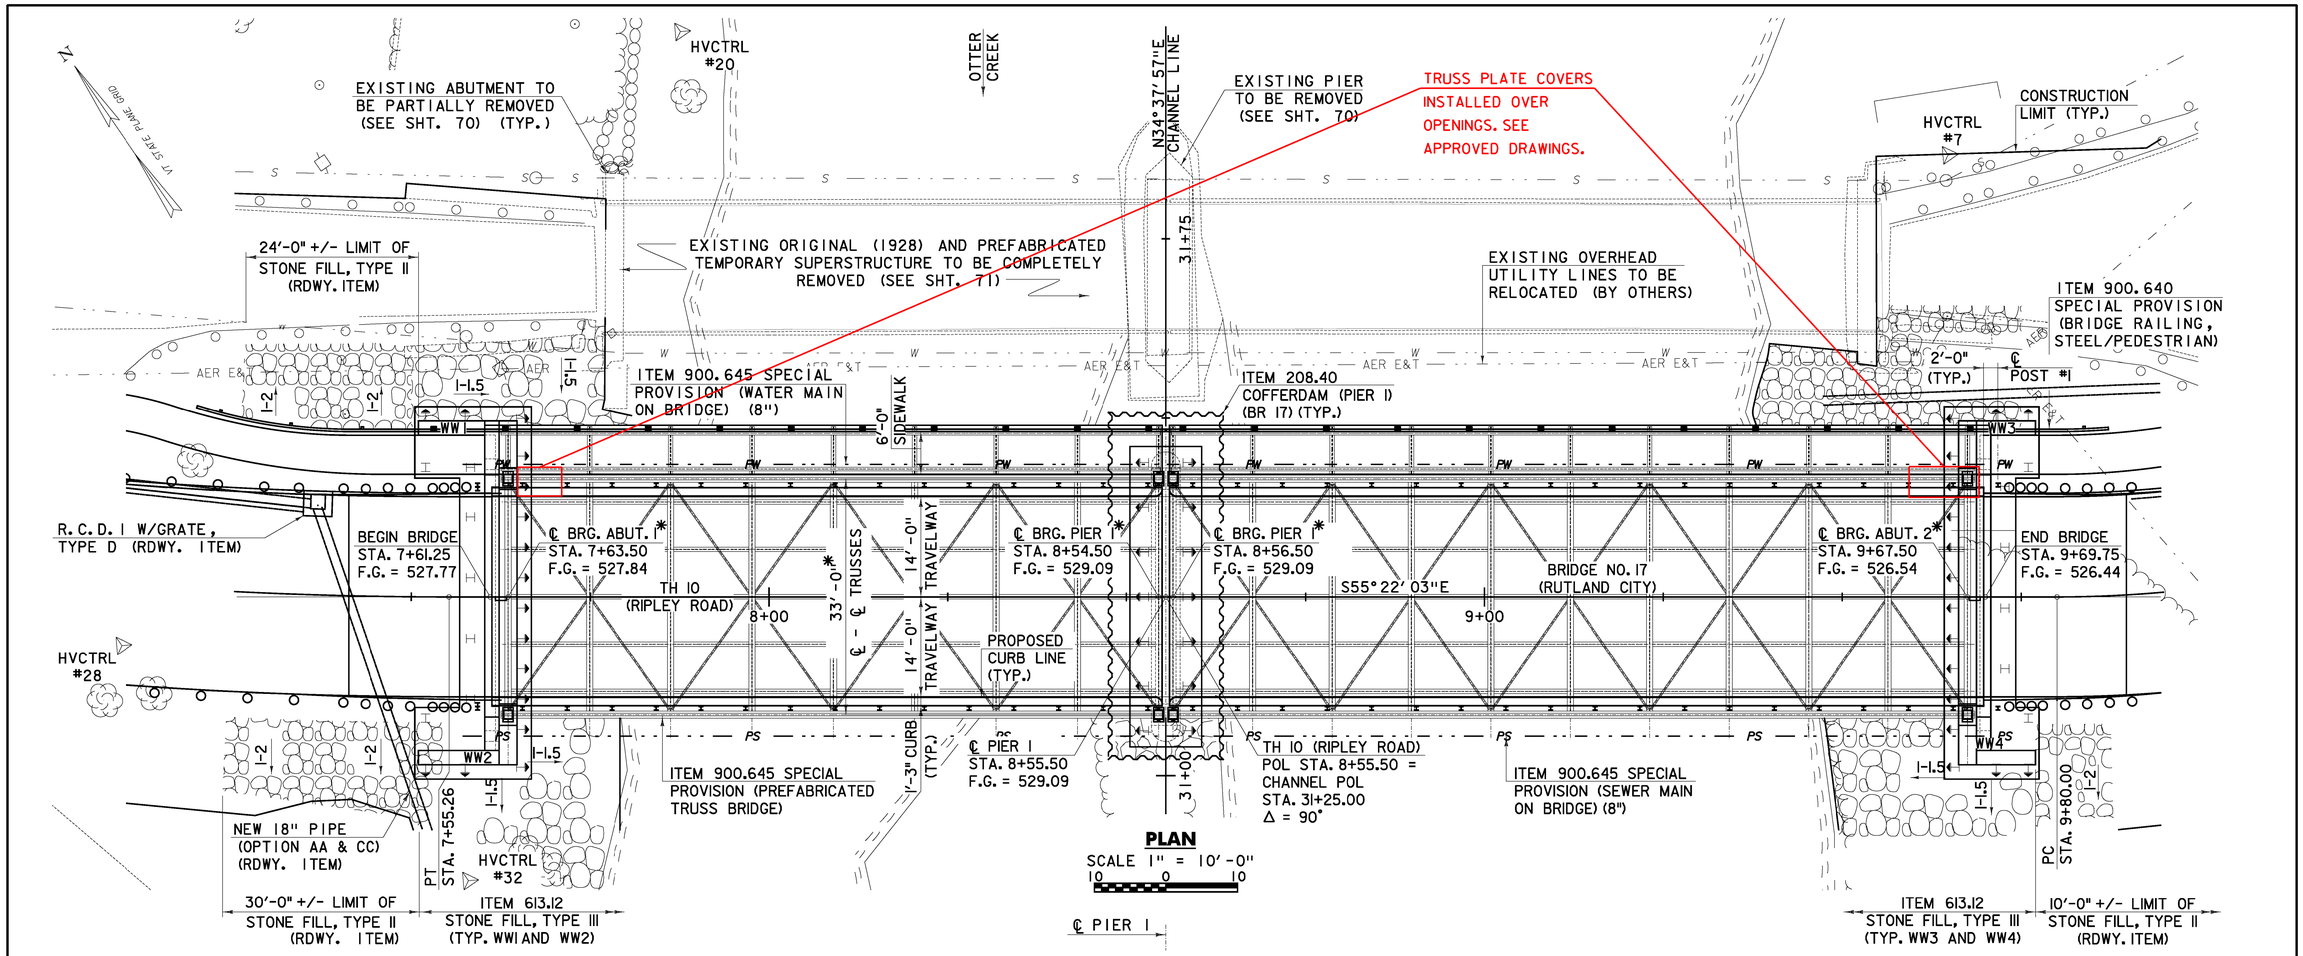

PLAN

SCALE 1" = 10'-0"

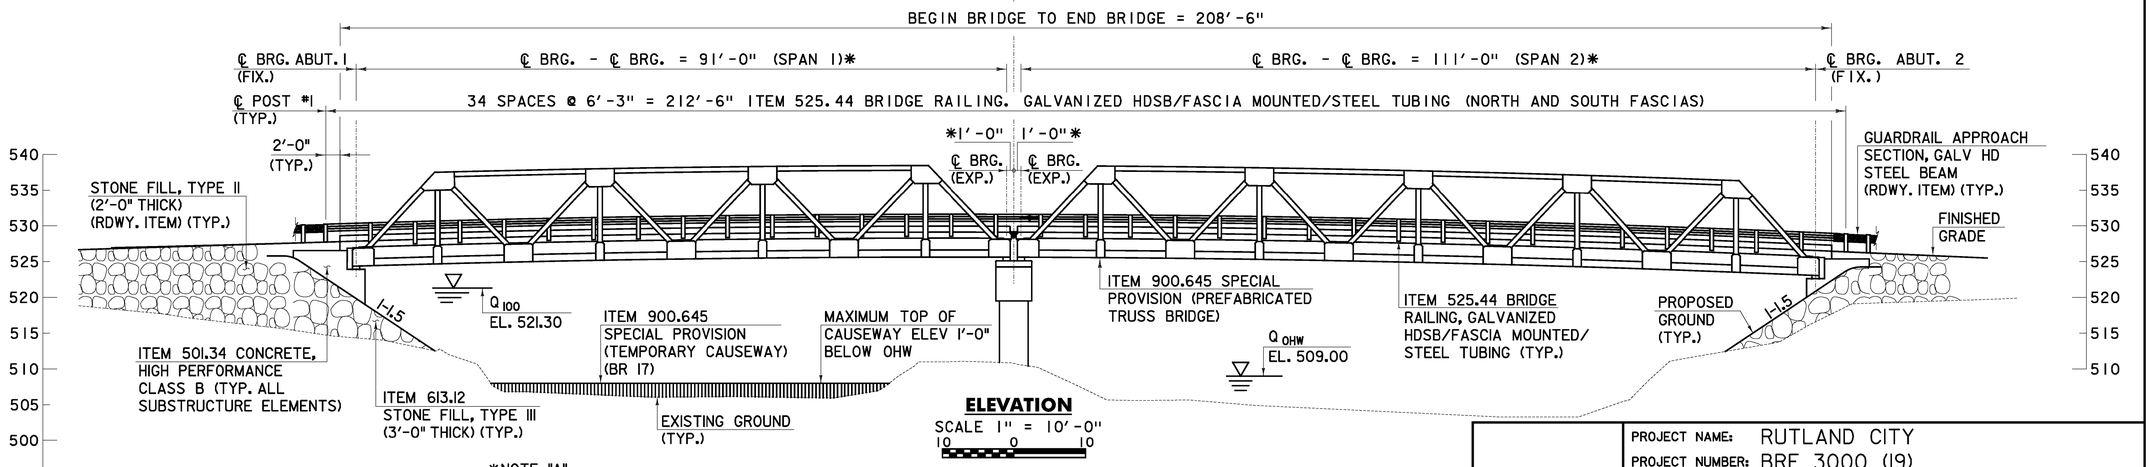

ELEVATION

SCALE 1" = 10'-0"

*NOTE "A":
FINAL SPAN LENGTHS AND TRUSS WIDTH SHALL BE DETERMINED BY TRUSS FABRICATOR. SPAN 1/SPAN 2 LENGTH RATIO SHALL BE AS CLOSE AS POSSIBLE TO 0.82 TO MATCH EXISTING BRIDGE, BUT SHALL NOT BE OUTSIDE OF THE RANGE OF 0.82 TO 0.83. ABUTMENT LOCATIONS SHALL BE AS SHOWN ON PLANS. NO VALUE ENGINEERING SHALL BE ALLOWED IN REGARDS TO THE SPAN RATIO.

CHA

PLAN AND ELEVATION

PROJECT NAME: RUTLAND CITY
PROJECT NUMBER: BRF 3000 (19)

PROJECT LEADER: M.D.S.
DESIGNED BY: D.M.D.
DWG. NO.:

PLOT DATE: 6/30/2014
DRAWN BY: D.M.D.
CHECKED BY: P.M.P.
SHEET 60 OF 245

FILE NAME = V:\Projects\ANY\K2\20615\CADD\MSTN\08_096\consultants\x08_096planelevation.dgn
DATE/TIME = 6/30/2014
USER = 4916