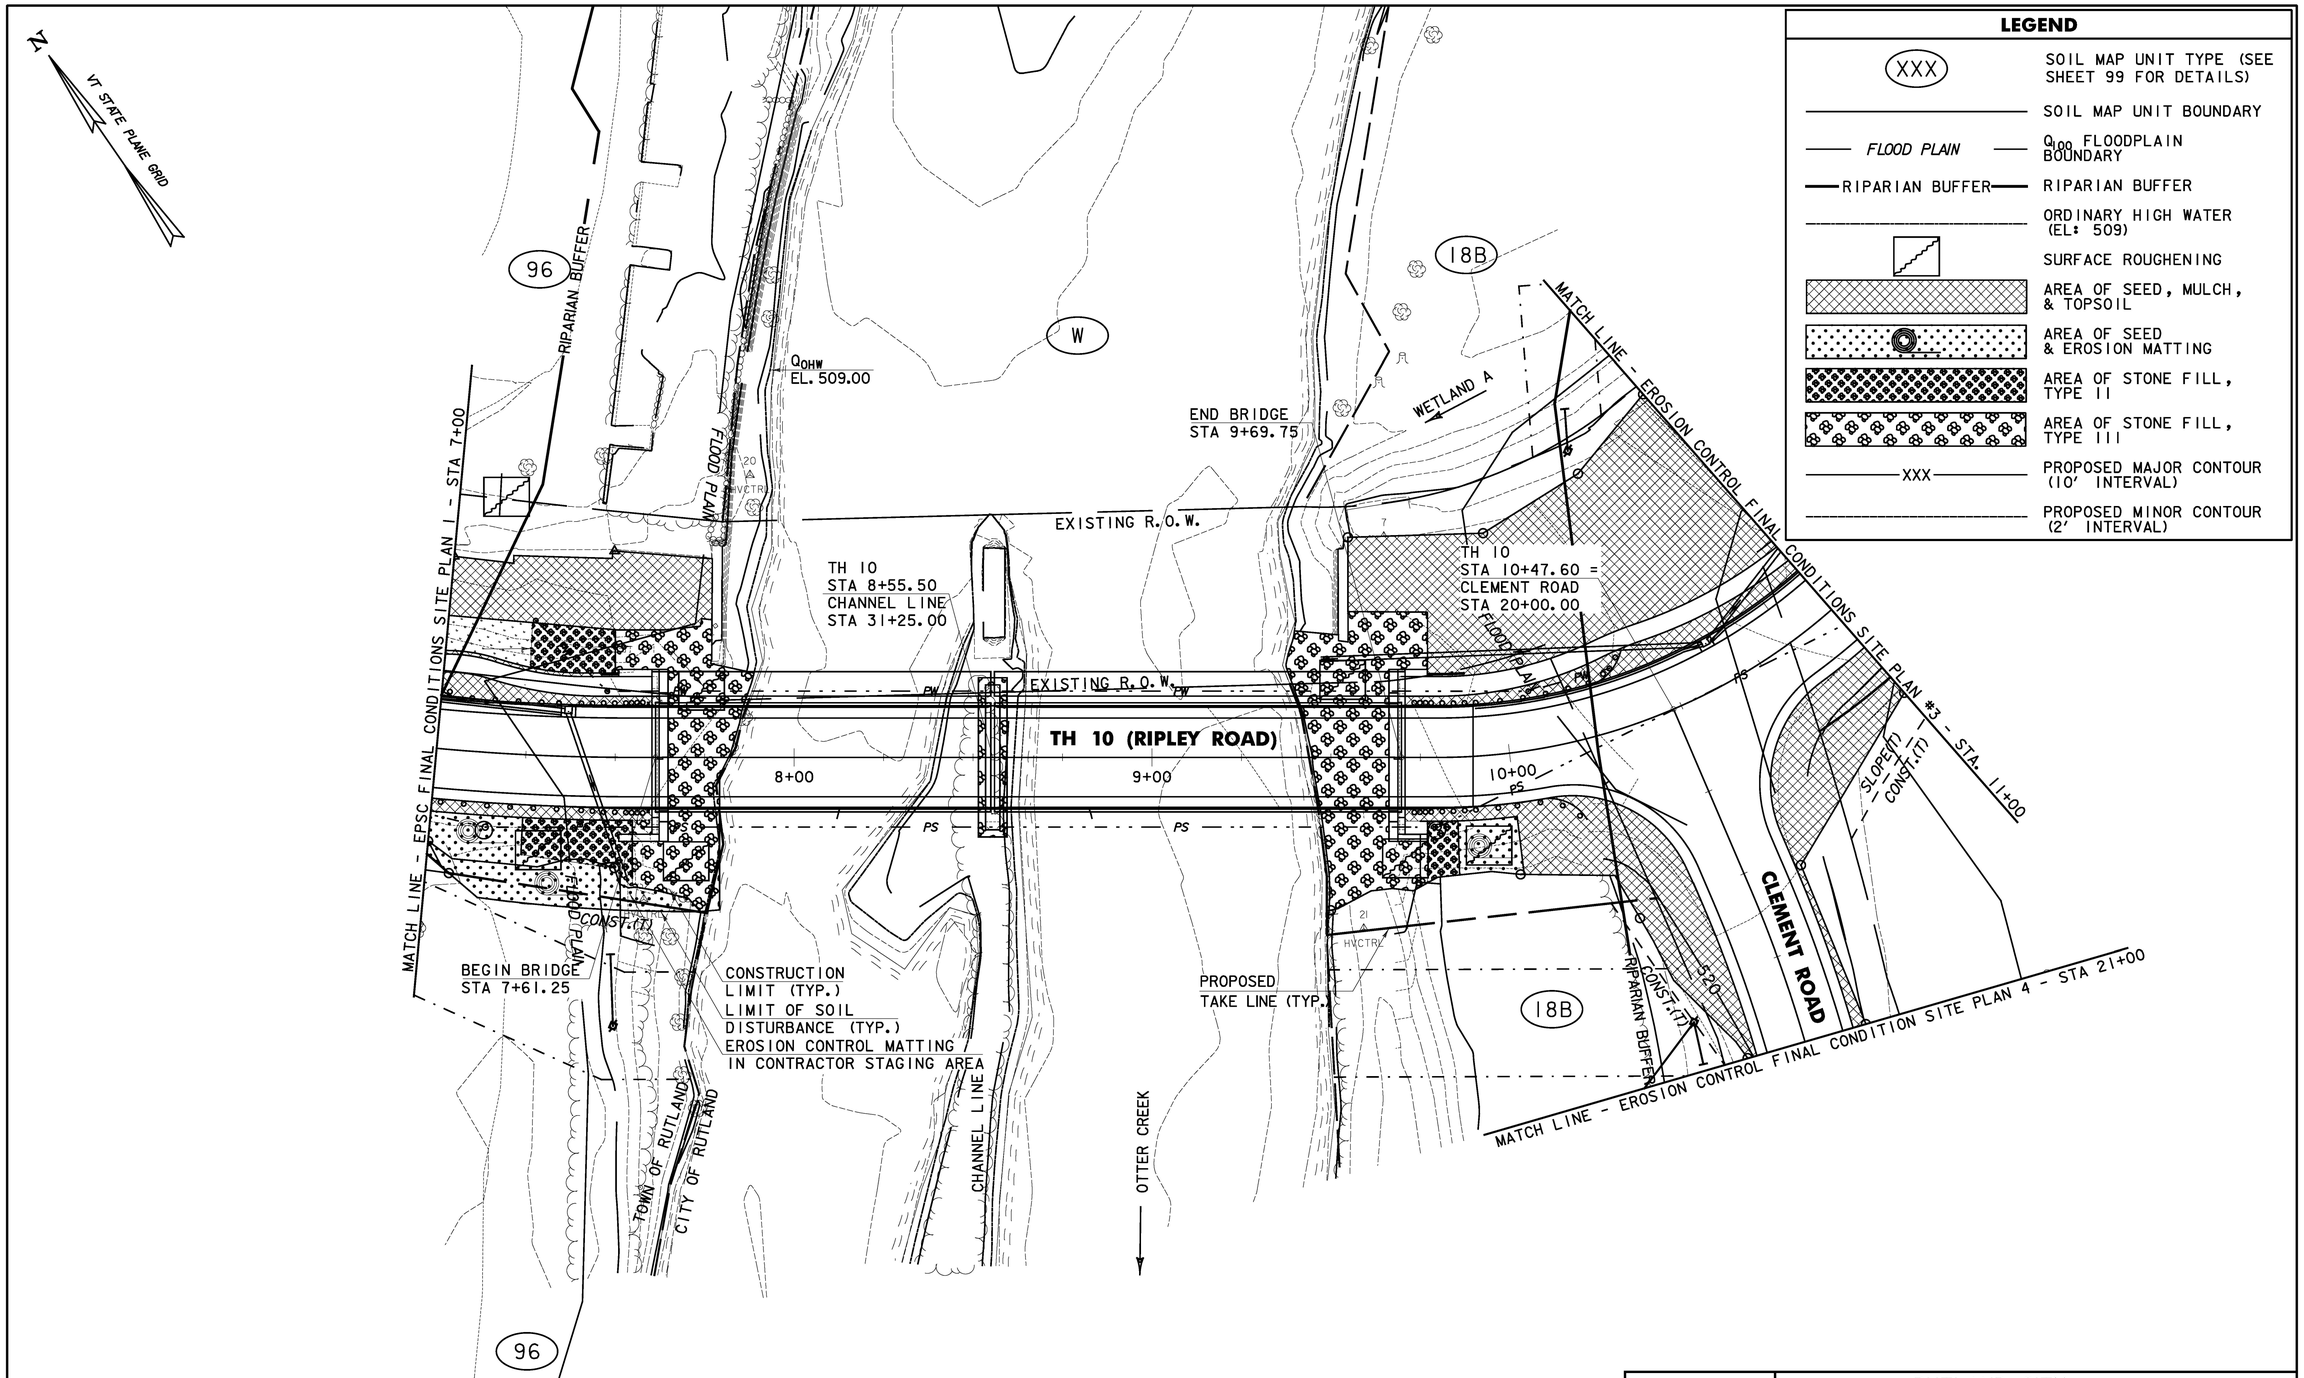

EROSION CONTROL FINAL CONDITION SITE PLAN #2

PROJECT NAME: RUTLAND CITY
PROJECT NUMBER: BRF 3000 (19)

PROJECT LEADER: M.D.S.
DESIGNED BY: C.R.H.
DWG. NO.: EROFINAL-2

PLOT DATE: 6/30/2014
DRAWN BY: C.R.H.
CHECKED BY: D.E.G.
SHEET III OF 245

FILE NAME = V:\Projects\ANYX2\20615\CADD\MSTN\08_096\consultants\x08_096bdr-epscfinal.dgn
DATE/TIME = 6/30/2014
USER = 4916