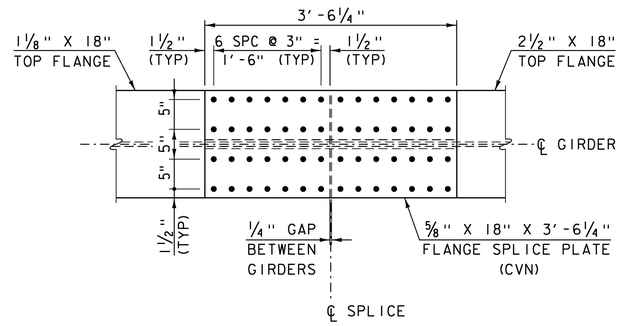

TOP FLANGE PLAN

(BOTTOM FLANGE SIMILAR)

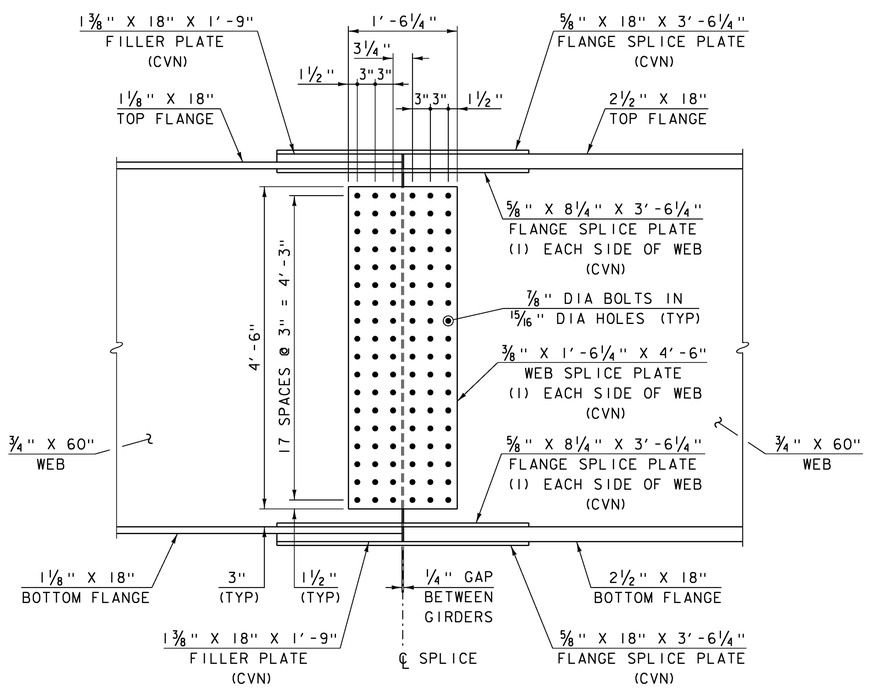

WEB ELEVATION

FIELD SPLICE DETAILS

SCALE: 1" = 1'-0"

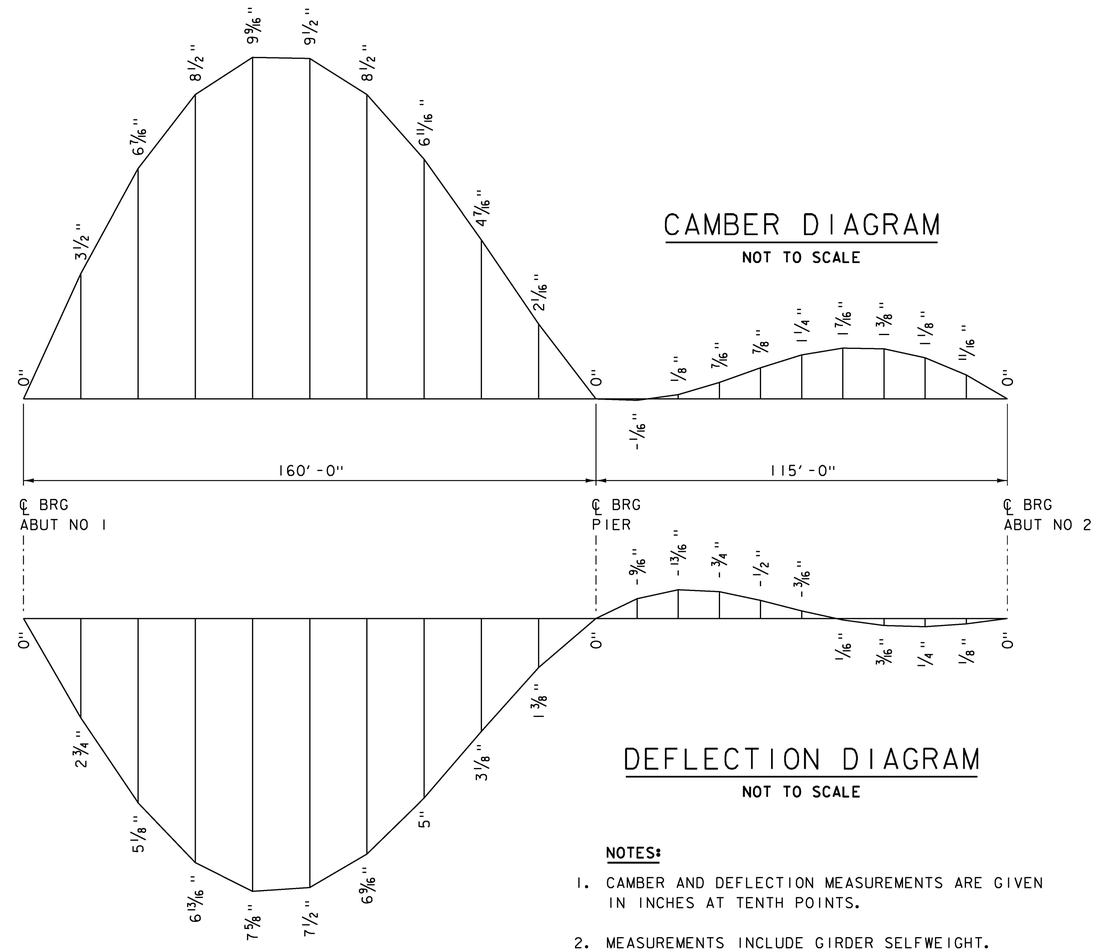

CAMBER DIAGRAM

NOT TO SCALE

DEFLECTION DIAGRAM

NOT TO SCALE

NOTES:

1. CAMBER AND DEFLECTION MEASUREMENTS ARE GIVEN IN INCHES AT TENTH POINTS.
2. MEASUREMENTS INCLUDE GIRDER SELFWEIGHT.

PROJECT NAME: RUTLAND CITY	
PROJECT NUMBER: BRF 3000 (16)	
FILE NAME: s94j092sup.dgn	PLOT DATE: 03-JUL-2014
PROJECT LEADER: C. CARLSON	DRAWN BY: G. ROY
DESIGNED BY: M. EVANS-MONGEON	CHECKED BY: M. EVANS-MONGEON
GIRDER DETAILS	SHEET 166 OF 245