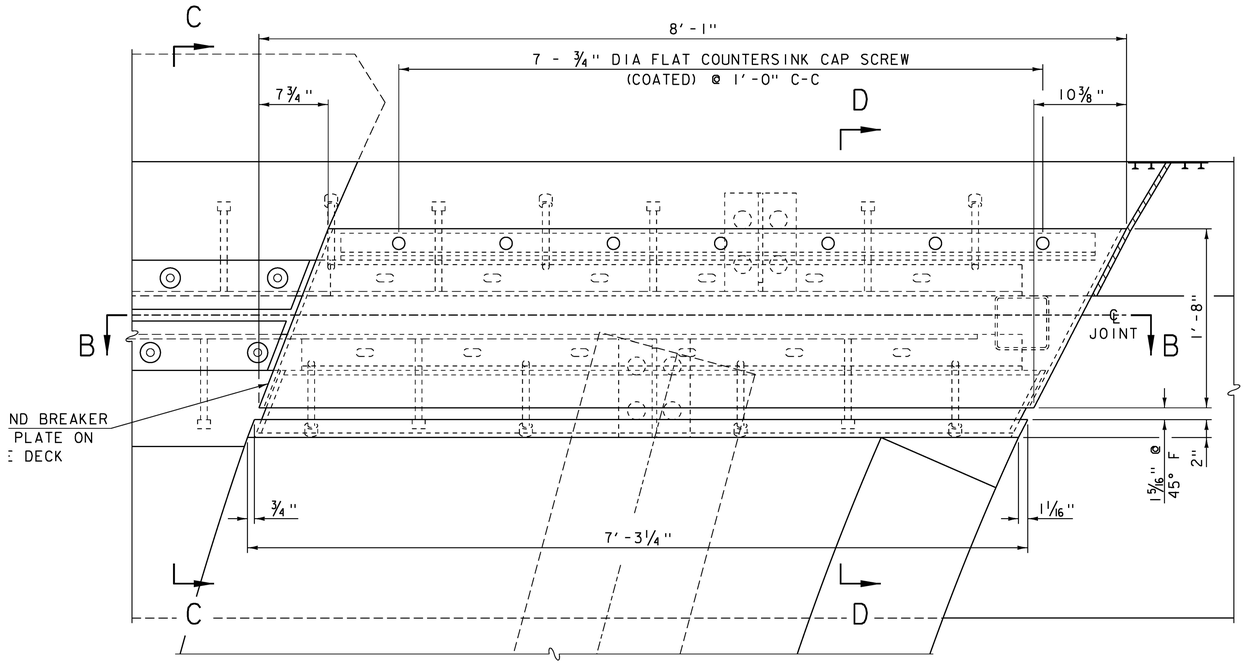

SIDEWALK PLATES PLAN

SCALE: 1 1/2" = 1'-0"

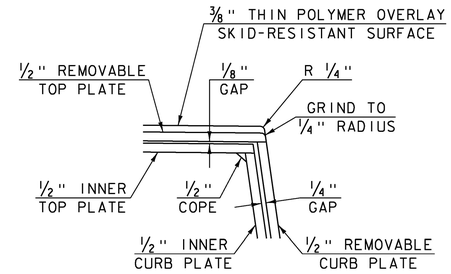

DETAIL "B"

SCALE: 3" = 1'-0"

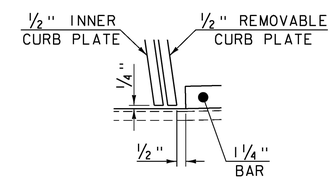

DETAIL "C"

SCALE: 3" = 1'-0"

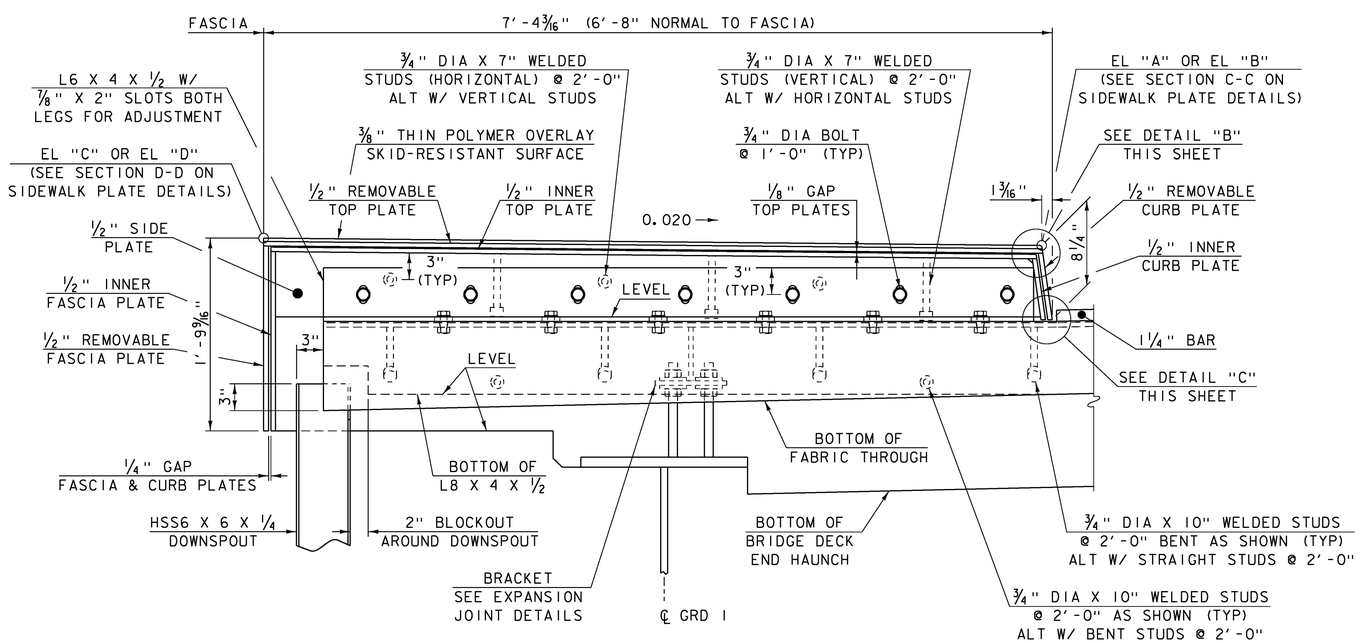

SECTION B-B

SCALE: 1 1/2" = 1'-0"

NOTE:

SEE SIDEWALK PLATE DETAILS FOR SECTIONS C-C AND D-D.

PROJECT NAME: RUTLAND CITY	
PROJECT NUMBER: BRF 3000 (16)	
FILE NAME: s94j092expjt.dgn	PLOT DATE: 03-JUL-2014
PROJECT LEADER: C. CARLSON	DRAWN BY: G. ROY
DESIGNED BY: M. EVANS-MONGEON	CHECKED BY: M. EVANS-MONGEON
SIDEWALK PLATES PLAN AND SECTION	SHEET 170 OF 245