NOTES

1. DESIGN PLAN OF PUMP STATION FROM PORTION OF SHEET 16 OF 18 BY FENTON G. KEYES ASSOCIATES, DATED JULY 1965.
2. REPLACEMENT OF GATE VALVES WITH NEW GATE VALVES AND GASKETS SHALL BE PAID FOR AS ITEM 629.26 GATE VALVE (6"). REPLACEMENT OF SWING CHECK VALVES WITH NEW SWING CHECK VALVES AND GASKETS SHALL BE PAID FOR AS ITEM 900.620 SPECIAL PROVISION (6" SWING CHECK VALVE).

RECORD DRAWING WATER AND SEWER ELEMENTS

SOME OF THE CONTENT SHOWN ON THESE RECORD DRAWINGS HAS BEEN PREPARED BASED ON INFORMATION FURNISHED BY OTHERS. THE LOCATION OF ITEMS SHOWN WITHOUT LABELED DIMENSIONS SHALL BE CONSIDERED AS APPROXIMATE. MODIFICATIONS TO BRIDGE ELEMENTS ARE NOT ADDRESSED ON THESE RECORD PLANS. THE SITE WAS NOT RE-SURVEYED AFTER CONSTRUCTION, SO RECORD LOCATIONS, ELEVATIONS AND FINISH GRADES ARE APPROXIMATE AND SHALL BE CONSIDERED "SCHEMATIC." DETAILS AND CROSS SECTIONS MAY NOT REFLECT "AS-BUILT"CONDITIONS.

W ⟵ ⟶ E

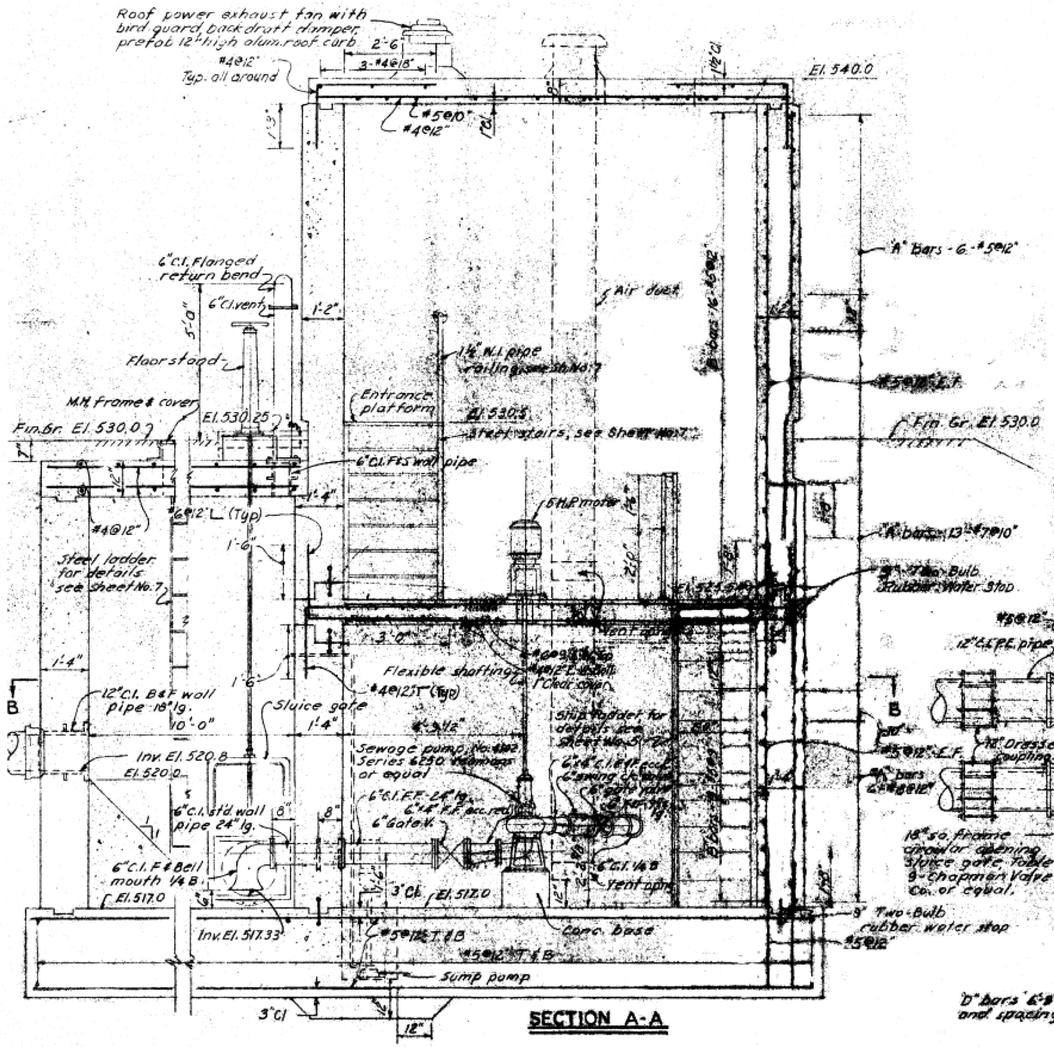

DRYWELL PLAN

DORR DRIVE PUMP STATION ORIGINAL DESIGN PLAN

NOT TO SCALE

WATER AND SEWER PLANS

CONSULTING ENGINEERS
540 Commercial Street, Manchester, NH 03101
(603) 668-8223 • Fax: (603) 668-8802
cld@cldengineers.com • www.cldengineers.com
Maine • New Hampshire • Vermont

PROJECT NAME:	RUTLAND CITY
PROJECT NUMBER:	BRF 3000(16)
FILE NAME: z94J092wtrswrdet.dgn	PLOT DATE: 6/17/2014
PROJECT LEADER: C. BEAN	DRAWN BY: W. GORDON
DESIGNED BY: D. LEWIS	CHECKED BY: S. REICHERT
DORR DRIVE PUMP STATION ORIGINAL PLAN	SHEET 4 OF 22