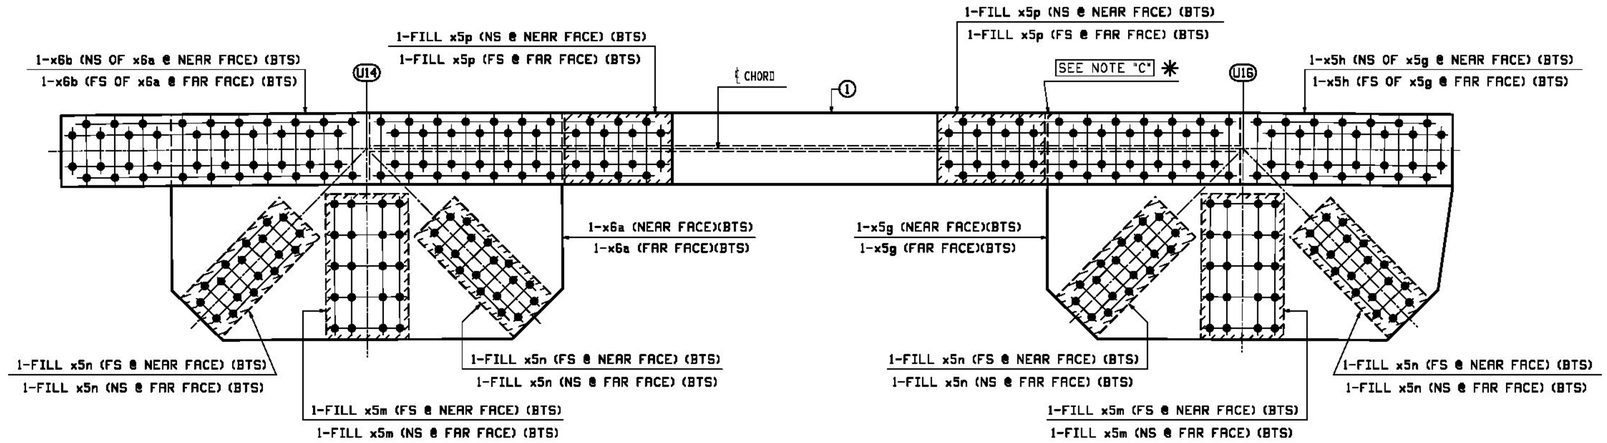

TOP CHORD ASSEMBLIES
(@ SPAN 2)

	MARK	REQ'D	①	
ALIKE EXCEPT FOR MARK	11U14U16N	ONE	BTC6N	(U14 – U16 NORTH)(LOOKING NORTH)
	11U14U16S	ONE	BTC6S	(U14 – U16 SOUTH)(LOOKING NORTH)

ABM INFO		SHOP	BILL OF MATERIAL					JOB NO.	DRAWING NO.	REV.
						LENGTH		598	11	
PAGE	LINE	MARK	QTY	MARK	MATERIAL	FT	INCHES	REMARKS	WT	PROCUREMENT NOTES
		11U14U16N	1		TOP CHORD ASS'Y			SEE NOTE "G"	9632	
			1	BTC6N	TOP CHORD			SEE DWG. 8	5110	
3	M		2	x5g	PL $\frac{3}{4}$×39$\frac{9}{16}$	5	11$\frac{1}{2}$	M270-50F2 (FCM)	602	
3	N		2	x5h	PL $\frac{3}{4}$×13$\frac{1}{4}$	7	7$\frac{1}{16}$	M270-50F2	257	
3	S		4	x5m	PL $\frac{11}{16}$×14$\frac{5}{8}$	2	1$\frac{3}{4}$	FILL	73	
3	T		8	x5n	PL $\frac{9}{16}$×10	2	1	FILL	40	
3	Q		4	x5p	PL $\frac{3}{4}$×12$\frac{7}{8}$	1	7	FILL	52	
3	M		2	x6a	PL $\frac{3}{4}$×39$\frac{9}{16}$	5	9	M270-50F2 (FCM)	581	
3	P		2	x6b	PL 1×13$\frac{7}{16}$	9	0$\frac{1}{16}$	M270-50F2	412	
		11U14U16S	1		TOP CHORD ASS'Y			SEE NOTE "G"	9632	
			1	BTC6S	TOP CHORD			SEE DWG. 8	5110	
3	M		2	x5g	PL $\frac{3}{4}$×39$\frac{9}{16}$	5	11$\frac{1}{2}$	M270-50F2 (FCM)	602	
3	N		2	x5h	PL $\frac{3}{4}$×13$\frac{1}{4}$	7	7$\frac{1}{16}$	M270-50F2	257	
3	S		4	x5m	PL $\frac{11}{16}$×14$\frac{5}{8}$	2	1$\frac{3}{4}$	FILL	73	
3	T		8	x5n	PL $\frac{9}{16}$×10	2	1	FILL	40	
3	Q		4	x5p	PL $\frac{3}{4}$×12$\frac{7}{8}$	1	7	FILL	52	
3	M		2	x6a	PL $\frac{3}{4}$×39$\frac{9}{16}$	5	9	M270-50F2 (FCM)	581	
3	P		2	x6b	PL 1×13$\frac{7}{16}$	9	0$\frac{1}{16}$	M270-50F2	412	

11U14U16N & 11U14U16S ARE ALIKE EXCEPT FOR MARK

Vermont Agency of Transportation
RECEIVED
ON: March 21, 2016
and Checked for
CONFORMANCE
BY: ABC DATE:

☒ NO EXCEPTION TAKEN ☐ MAKE CORRECTIONS NOTED
☐ REJECTED ☐ REVISE AND RESUBMIT
☐ SUBMIT SPECIFIED ITEM

CHECKING IS ONLY FOR THE GENERAL CONFORMANCE WITH THE DESIGN CONCEPT OF THE PROJECT AND GENERAL COMPLIANCE WITH THE INFORMATION GIVEN IN THE CONTRACT DOCUMENTS. ANY ACTION SHOWN IS SUBJECT TO THE REQUIREMENTS OF THE PLANS AND SPECIFICATIONS. CONTRACTOR IS RESPONSIBLE FOR DIMENSIONS WHICH SHALL BE CONFIRMED AND CORRELATED AT THE JOB SITE; FABRICATION PROCESSES AND TECHNIQUES OF CONSTRUCTION; COORDINATION OF HIS WORK WITH THAT OF ALL OTHER TRADES AND THE SATISFACTORY PERFORMANCE OF THE WORK.

CHA
DATE 1/29/2016 BY J. Najdowski

✱ SHOP NOTE "C"
FOR PLATE ORIENTATION PLACE CLIP TOWARDS SIDE SHOWN.

SHOP NOTE "G"
ALL STEEL (EXCEPT FOR BOLTS) SHALL BE HOT DIP GALVANIZED IN ACCORDANCE WITH SUBSECTION 506.15.

NOTES:
1. FOR GENERAL NOTES SEE DWG. GN1.
2. FOR STANDARD DETAILS SEE DWG. X5 & X6.
3. FOR SUB-ASSEMBLY DETAILS SEE DWG. 8.
4. BTS DENOTES BOLT TO SHIP OR SECURE FOR SHIPMENT.

REV.	DATE	REMARKS	DWN	CHK	APVL	SHOP
0						

MATERIAL:	SURFACE PREP. & PAINT:	HOLES:	SHOP BOLTS:
M270-50 (UN)	SEE DWG. GN1	15/16ø	NONE

DESCRIPTION: TOP CHORD ASSEMBLIES (SPAN 2)

CASCO BAY STEEL STRUCTURES, INC.
1 WALLACE AVE. SOUTH PORTLAND, ME 04106
PHONE (207) 780-6722 FAX. (207) 780-6726
TENSOR 3265

STRUCTURE: TH-10 OVER OTTER CREEK PONY TRUSS BRIDGE	DRAWN: RB	DATE: 12/18/15
	CHK'D: WJL	DATE: 1/15/16
LOCATION: RUTLAND CITY, VERMONT	JOB NO. 598	DWG NO. 11
PROJ NO. BRF 3000 (19)		
CUSTOMER: KUBRICKY CONSTRUCTION CORP.		REV. △

Fri Jan 29, 2016 10:38:39 AM J:\work\jobs\2015\15-1.dwg