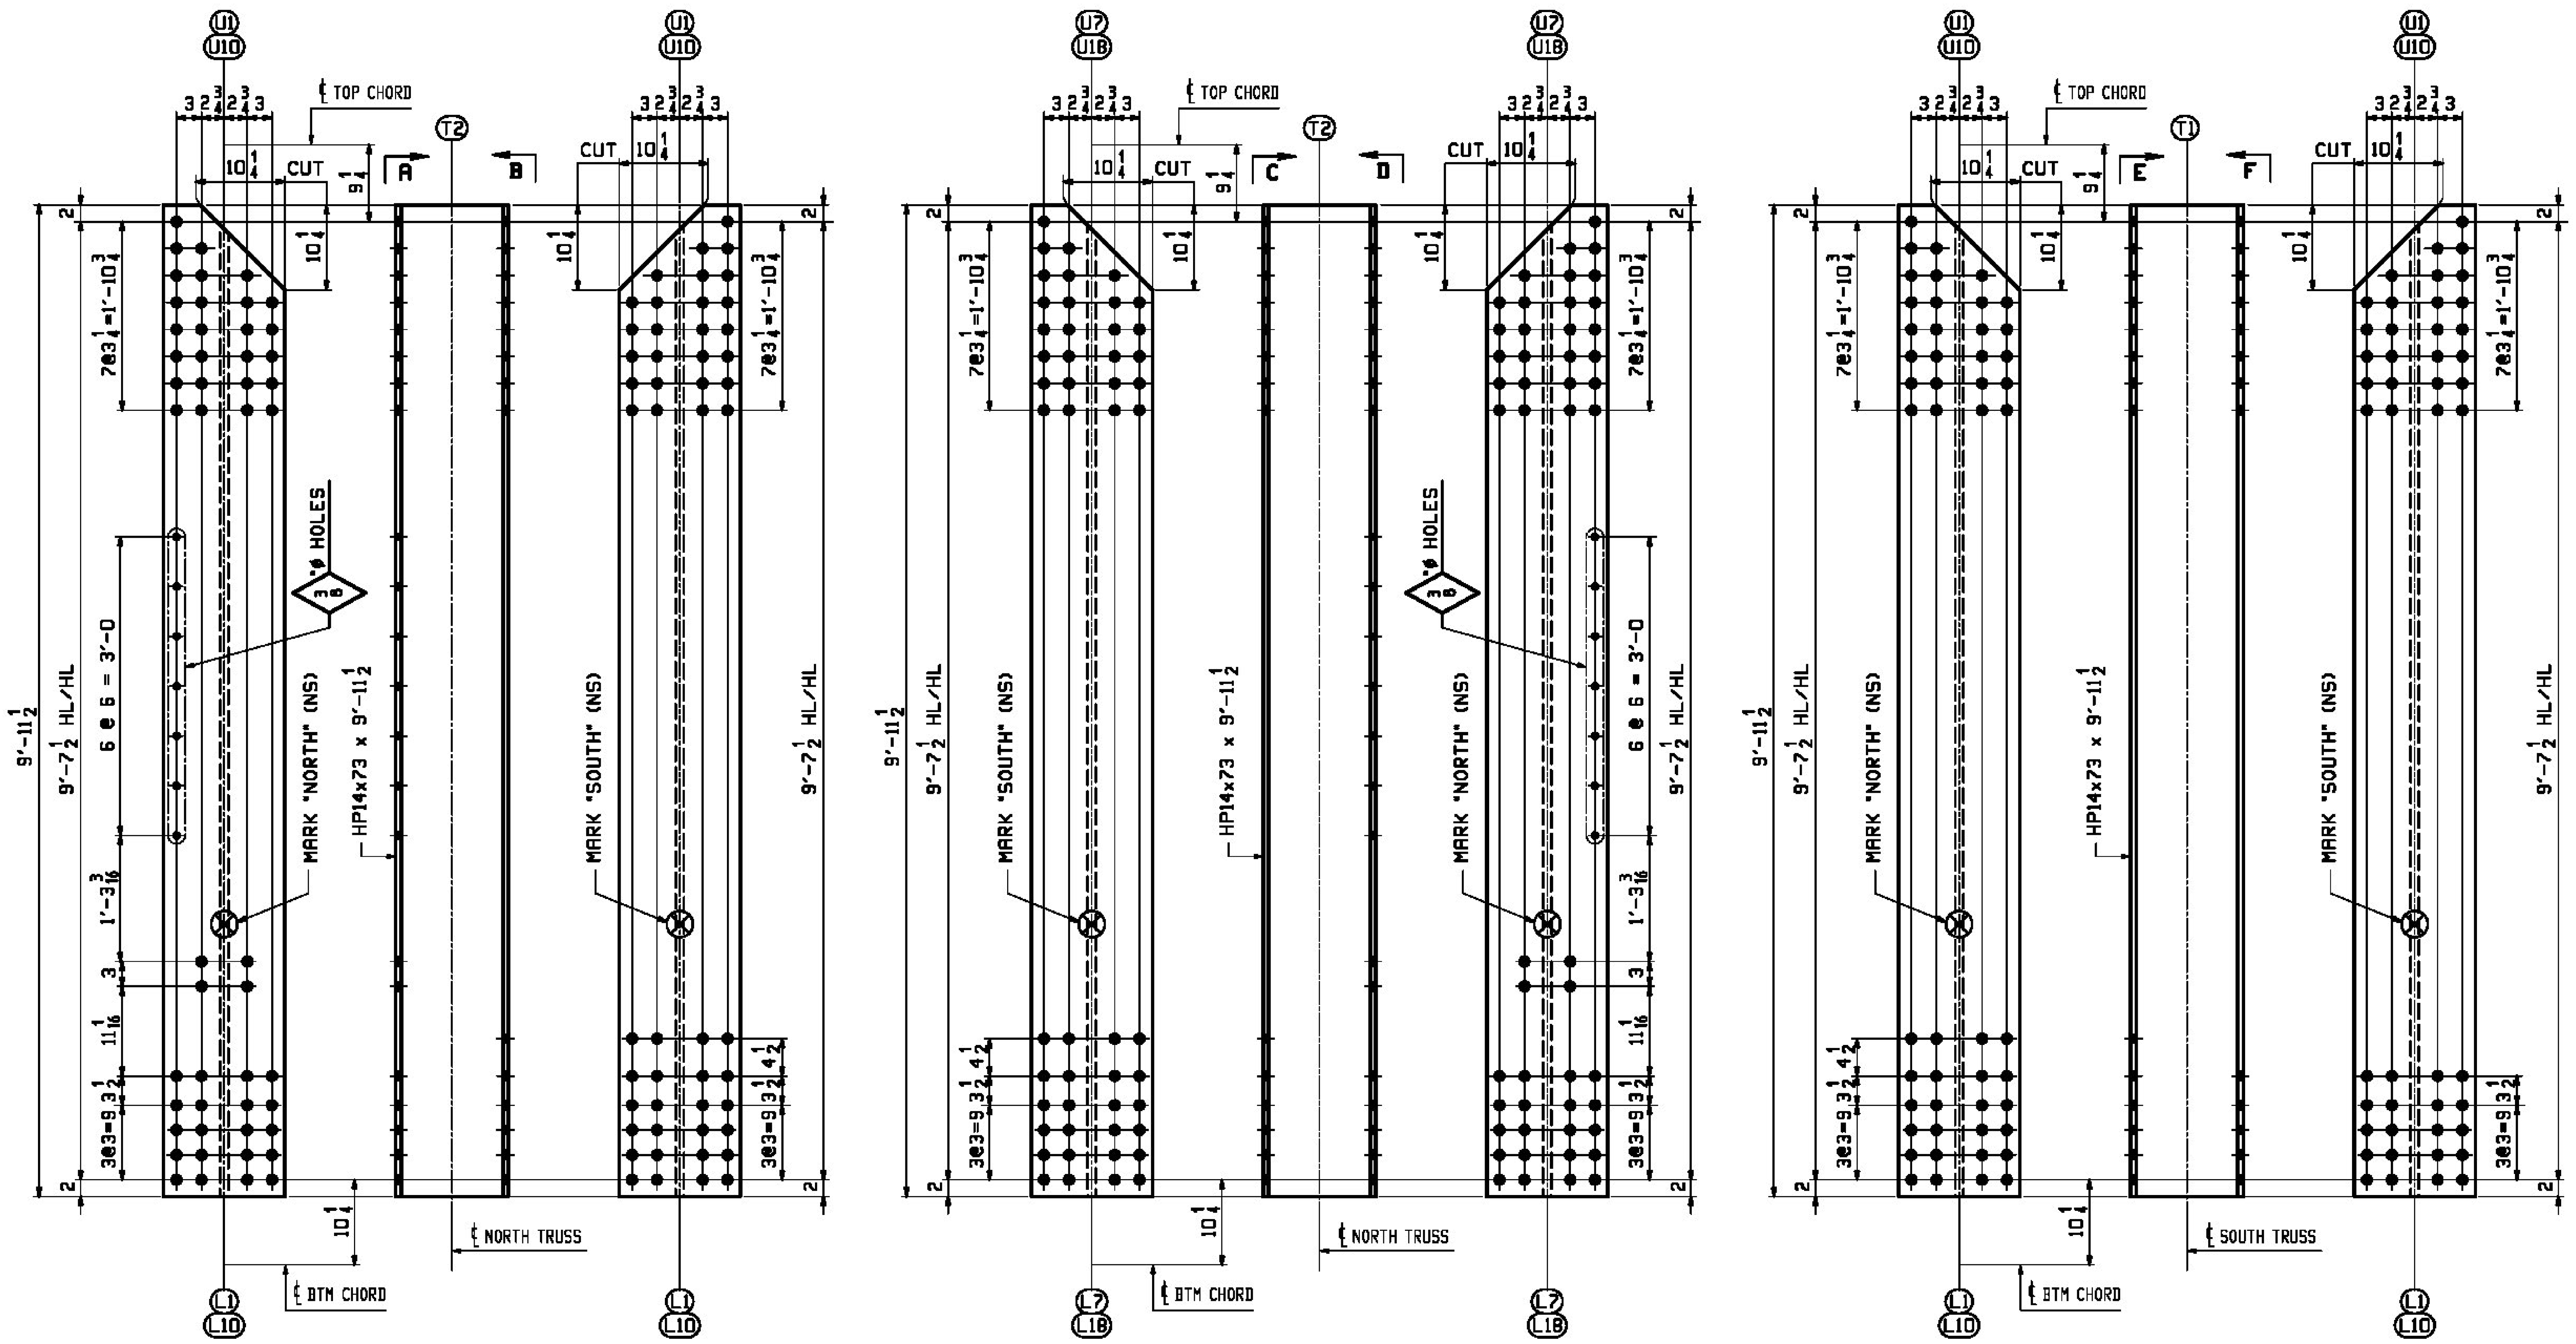

VIEW -A (OUTER NORTH FACE) | VIEW -B (INSIDE SOUTH FACE) | VIEW -C (INSIDE SOUTH FACE) | VIEW -D (OUTER NORTH FACE) | VIEW -E (INSIDE NORTH FACE) | VIEW -F (OUTER SOUTH FACE)

ABN INFO		SHIP	BILL OF MATERIAL					JOB NO. 598	DRAWING NO. 12	REV.
PAGE	LINE	MARK	QTY	MARK	MATERIAL	LENGTH FT	LENGTH INCHES	REMARKS	WT	PROCUREMENT NOTES
					VERTICALS					
1	J	12V1N	1		HP 14x73	9	11 1/2	GALV. M270-50F2 (FCM) ALIKE EXCEPT FOR MARK	727	
1	J	12V10N	1		HP 14x73	9	11 1/2	GALV. M270-50F2 (FCM)	727	
1	J	12V7N	1		HP 14x73	9	11 1/2	GALV. M270-50F2 (FCM) ALIKE EXCEPT FOR MARK	727	
1	J	12V18N	1		HP 14x73	9	11 1/2	GALV. M270-50F2 (FCM)	727	
1	J	12V1S	1		HP 14x73	9	11 1/2	GALV. M270-50F2 (FCM) ALIKE EXCEPT FOR MARK	727	
1	J	12V10S	1		HP 14x73	9	11 1/2	GALV. M270-50F2 (FCM)	727	

Vermont Agency of Transportation
RECEIVED
ON: March 21, 2016
and Checked for
CONFORMANCE
BY: ABC DATE:

SHOP NOTE "G"

ALL STEEL SHALL BE HOT DIP GALVANIZED IN ACCORDANCE WITH SUBSECTION 506.15.

ONE ~ VERTICAL ~ 12V1N (L1 - U1 NORTH)
ONE ~ VERTICAL ~ 12V10N (L10 - U10 NORTH)
ALIKE EXCEPT FOR MARK

ONE ~ VERTICAL ~ 12V7N (L7 - U7 NORTH)
ONE ~ VERTICAL ~ 12V18N (L18 - U18 NORTH)
ALIKE EXCEPT FOR MARK

ONE ~ VERTICAL ~ 12V1S (L1 - U1 SOUTH)
ONE ~ VERTICAL ~ 12V10S (L10 - U10 SOUTH)
ALIKE EXCEPT FOR MARK

[X] NO EXCEPTION TAKEN
[ ] MAKE CORRECTIONS NOTED
[ ] REJECTED
[ ] REVISE AND RESUBMIT
[ ] SUBMIT SPECIFIED ITEM

CHECKING IS ONLY FOR THE GENERAL CONFORMANCE WITH THE DESIGN CONCEPT OF THE PROJECT AND GENERAL COMPLIANCE WITH THE INFORMATION GIVEN IN THE CONTRACT DOCUMENTS. ANY ACTION SHOWN IS SUBJECT TO THE REQUIREMENTS OF THE PLANS AND SPECIFICATIONS. CONTRACTOR IS RESPONSIBLE FOR DIMENSIONS WHICH SHALL BE CONFIRMED AND CORRELATED AT THE JOB SITE; FABRICATION PROCESSES AND TECHNIQUES OF CONSTRUCTION; COORDINATION OF HIS WORK WITH THAT OF ALL OTHER TRADES AND THE SATISFACTORY PERFORMANCE OF THE WORK.

CHA

DATE 1/29/2016 BY J. Najdowski

NOTES:
1. FOR GENERAL NOTES SEE DWG. GN1.
2. FCM - DENOTES FRACTURE CRITICAL MATERIAL.

REV.	DATE	REMARKS	DWN	CHK	APVL	SHOP
0		~				

MATERIAL:	SURFACE PREP. & PAINT:	HOLES:	SHOP BOLTS:
M270-50	SEE DWG. GN1	15/16 ø (UN)	NONE

DESCRIPTION: TRUSS VERTICALS

CASCO BAY STEEL STRUCTURES, INC.
1 WALLACE AVE. PHONE (207) 780-6722
SOUTH PORTLAND, ME 04106 FAX. (207) 780-6726
TENSOR 3285

STRUCTURE:	TH-10 OVER OTTER CREEK PONY TRUSS BRIDGE	DRAWN: RB	DATE: 12/18/15
		CHKD: WJL	DATE: 1/15/16
LOCATION:	RUTLAND CITY, VERMONT	JOB NO.	DWG NO.
PROJ NO.	BRF 3000 (19)	598	12
CUSTOMER:	KUBRICKY CONSTRUCTION CORP.		REV. △