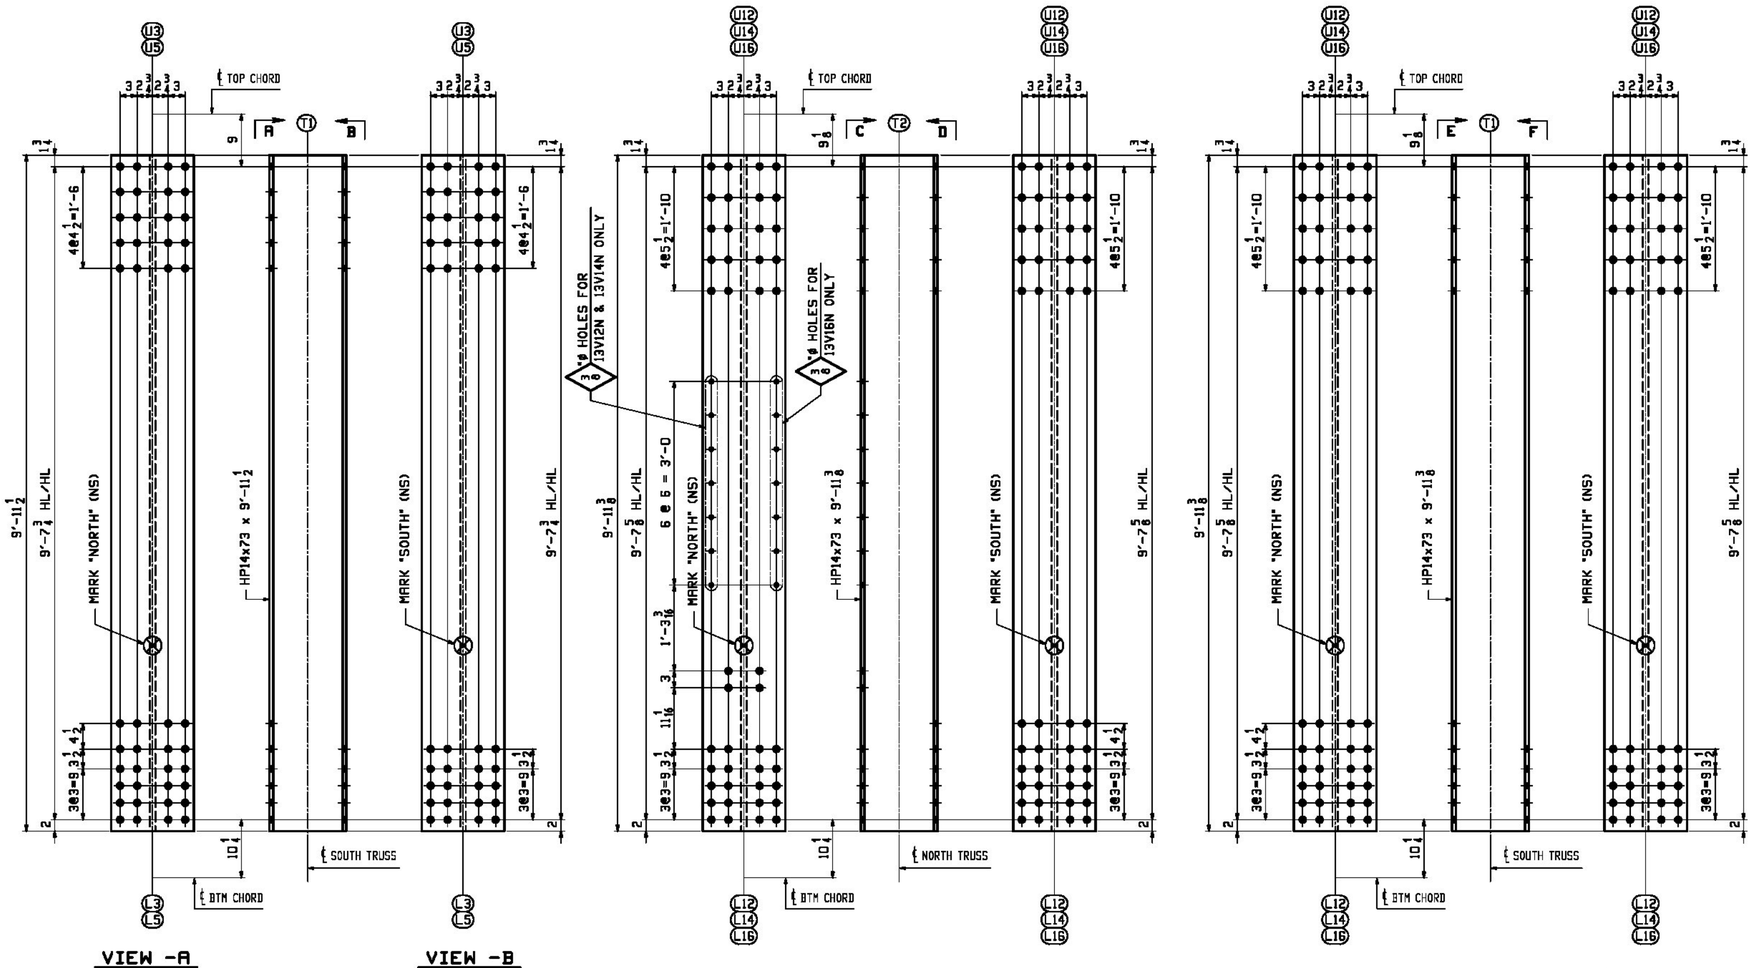

ABM INFO		SHIP	BILL OF MATERIAL						JOB NO. 598	DRAWING NO. 13	REV.
PAGE	LINE	MARK	QTY	MARK	MATERIAL	LENGTH FT	LENGTH INCHES	REMARKS	WT	PROCUREMENT NOTES	
					VERTICALS						
1	J	13V3S	1		HP 14x73	9	11 1/2	GALV. FLANGE EXCEPT FOR MARK M270-50F2 (FCM)	727		
1	J	13V5S	1		HP 14x73	9	11 1/2	GALV. M270-50F2 (FCM)	727		
1	J	13V12N	1		HP 14x73	9	11 3/8	GALV. FLANGE EXCEPT FOR MARK M270-50F2 (FCM)	726		
1	J	13V14N	1		HP 14x73	9	11 3/8	GALV. M270-50F2 (FCM)	726		
1	J	13V16N	1		HP 14x73	9	11 3/8	GALV. M270-50F2 (FCM)	726		
1	J	13V12S	1		HP 14x73	9	11 3/8	GALV. FLANGE EXCEPT FOR MARK M270-50F2 (FCM)	726		
1	J	13V14S	1		HP 14x73	9	11 3/8	GALV. M270-50F2 (FCM)	726		
1	J	13V16S	1		HP 14x73	9	11 3/8	GALV. M270-50F2 (FCM)	726		

SHOP NOTE "G"

ALL STEEL SHALL BE HOT DIP GALVANIZED IN ACCORDANCE WITH SUBSECTION 506.15.

ONE ~ VERTICAL ~ 13V3S (L3 - U3 SOUTH)
ONE ~ VERTICAL ~ 13V5S (L5 - U5 SOUTH)
ALIKE EXCEPT FOR MARK

ONE ~ VERTICAL ~ 13V12N (L12 - U12 NORTH)
ONE ~ VERTICAL ~ 13V14N (L14 - U14 NORTH)
ALIKE EXCEPT FOR MARK

ONE ~ VERTICAL ~ 13V16N (L16 - U16 NORTH) (AS NOTED)

ONE ~ VERTICAL ~ 13V12S (L12 - U12 SOUTH)
ONE ~ VERTICAL ~ 13V14S (L14 - U14 SOUTH)
ONE ~ VERTICAL ~ 13V16S (L16 - U16 SOUTH)
ALIKE EXCEPT FOR MARK

X NO EXCEPTION TAKEN
REJECTED
MAKE CORRECTIONS NOTED
REVISE AND RESUBMIT
SUBMIT SPECIFIED ITEM

CHECKING IS ONLY FOR THE GENERAL CONFORMANCE WITH THE DESIGN CONCEPT OF THE PROJECT AND GENERAL COMPLIANCE WITH THE INFORMATION GIVEN IN THE CONTRACT DOCUMENTS AND ARTICLES SHOWN IS SUBJECT TO THE REQUIREMENTS OF THE PLANS AND SPECIFICATIONS. CONTRACTOR IS RESPONSIBLE FOR DIMENSIONS WHICH SHALL BE CONFIRMED AND CORRELATED AT THE JOB SITE; FABRICATION PROCESSES AND TECHNIQUES OF CONSTRUCTION; COORDINATION OF HIS WORK WITH THAT OF ALL OTHER TRADES AND THE SATISFACTORY PERFORMANCE OF THE WORK.

CHA

DATE 1/29/2016 BY J. Najdowski

Vermont Agency of Transportation
RECEIVED
ON: March 21, 2016
and Checked for
CONFORMANCE
BY: ABC DATE:

NOTES:
1. FOR GENERAL NOTES SEE DWG. GN1.
2. FCM - DENOTES FRACTURE CRITICAL MATERIAL.

REV.	DATE	REMARKS	DWN	CHK	APVL	SHOP
0						

MATERIAL:	SURFACE PREP. & PAINT:	HOLES:	SHOP BOLTS:
M270-50	SEE DWG. GN1	15/16ø (UN)	NONE

DESCRIPTION: TRUSS VERTICALS

CASCO BAY STEEL STRUCTURES, INC.
1 WALLACE AVE. SOUTH PORTLAND, ME 04106
PHONE (207) 780-6722 FAX. (207) 780-6726
TENSOR 3265

STRUCTURE: TH-10 OVER OTTER CREEK PONY TRUSS BRIDGE

DRAWN:	DATE:
RB	12/19/15
CHKD: WJL	DATE: 1/15/16

LOCATION:	RUTLAND CITY, VERMONT	JOB NO.	DWG NO.
PROJ NO.	BRF 3000 (19)	598	13
CUSTOMER:	KUBRICKY CONSTRUCTION CORP.		REV. △