X NO EXCEPTION TAKEN ☐ MAKE CORRECTIONS NOTED
☐ REJECTED ☐ REVISE AND RESUBMIT
☐ SUBMIT SPECIFIED ITEM

CHECKING IS ONLY FOR THE GENERAL CONFORMANCE WITH THE DESIGN CONCEPT OF THE PROJECT AND GENERAL COMPLIANCE WITH THE INFORMATION GIVEN IN THE CONTRACT DOCUMENTS. ANY ACTION SHOWN IS SUBJECT TO THE REQUIREMENTS OF THE PLANS AND SPECIFICATIONS. CONTRACTOR IS RESPONSIBLE FOR DIMENSIONS WHICH SHALL BE CONFIRMED AND CORRELATED AT THE JOB SITE; FABRICATION PROCESSES AND TECHNIQUES OF CONSTRUCTION; COORDINATION OF HIS WORK WITH THAT OF ALL OTHER TRADES AND THE SATISFACTORY PERFORMANCE OF THE WORK.

CHA
DATE 3/25/2013 BY James Rashford

CAD DWG. REF: 16422010.DWG— 4

ANCHOR HOLE DETAIL
FULL SCALE

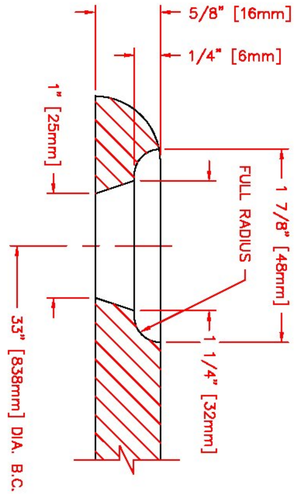

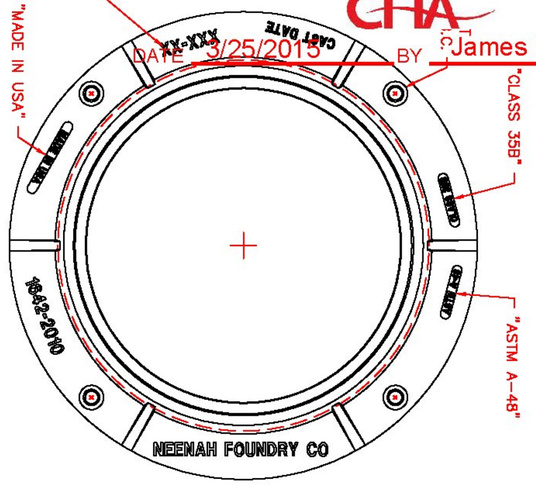

(4) 1" [25mm] DIA. HOLES FOR 3/4" [19mm] DIA. ANCHOR BOLTS ON 33" [838mm] [ILLEGIBLE] B.C.

NOTE: ALL DIMENSIONS ARE SHOWN IN ENGLISH AND [METRIC].
SUITABLE FOR HS-25 LOADING
MATERIAL: CAST GRAY IRON ASTM A-48, CLASS 35B
FINISH: NOT PAINTED
WEIGHT: 147#

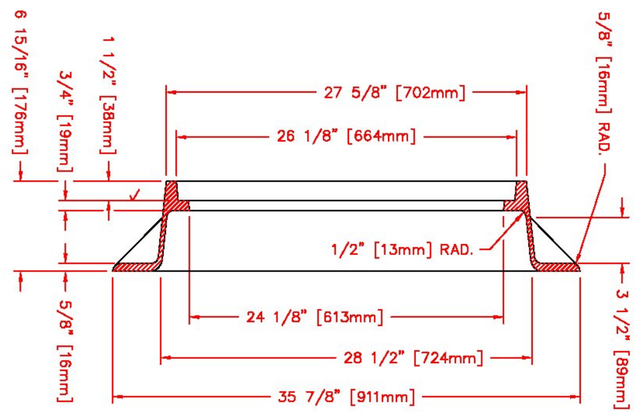

WAS COMPONENT NO. 1642-0001

NO.	DATE	DESCRIPTION	MADE
5	10-14-2003	CORRECTED FILLETS	
4	08-26-2003	ADDED LETTERING ON FLANGE	
3	10-30-98	CHG. A-A DIM. FROM 35 3/8"	CLK
DATE		REVISION	CHK
			INT

DR. E. REMME
CHK.
APP.
DATE 2-10-96

SCALE 1/8"=1"
DIM CHK.

TITLE:
R-1642
FRAME

NEENAH FOUNDRY COMPANY
NEENAH, WISCONSIN 54956

NF-16422010 B