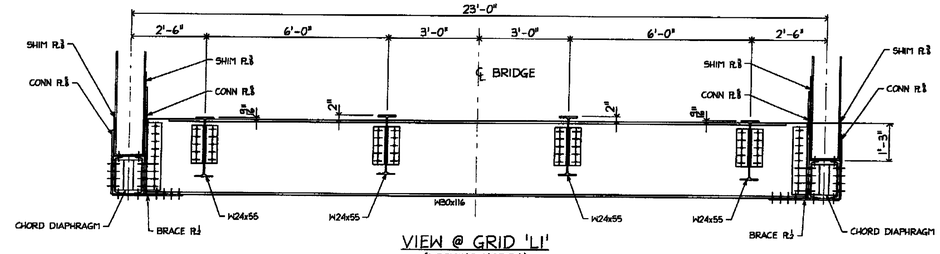

VIEW @ GRID 'L1'
(LOOKING NORTH)

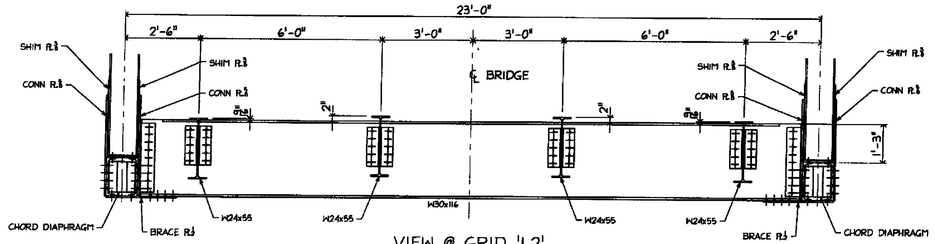

VIEW @ GRID 'L2'
(LOOKING NORTH)

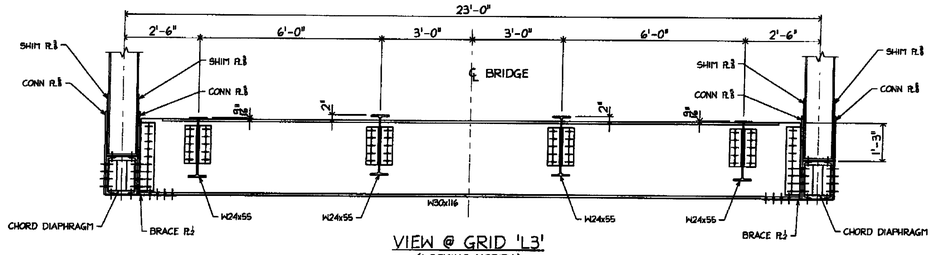

VIEW @ GRID 'L3'
(LOOKING NORTH)

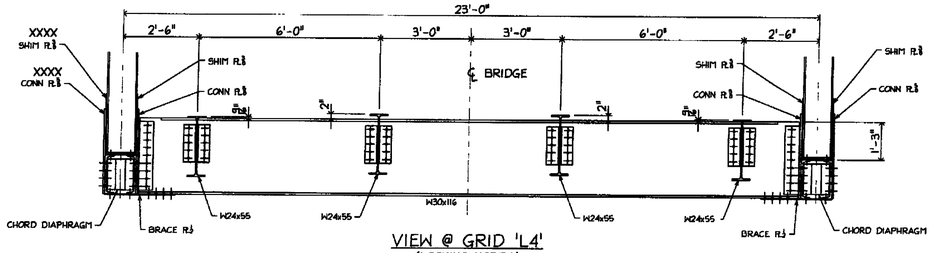

VIEW @ GRID 'L4'
(LOOKING NORTH)

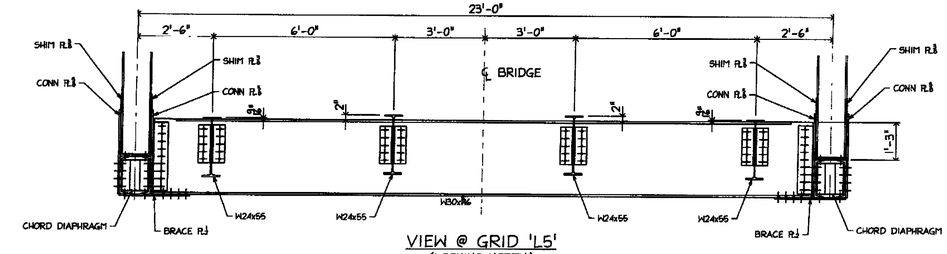

VIEW @ GRID 'L5'
(LOOKING NORTH)

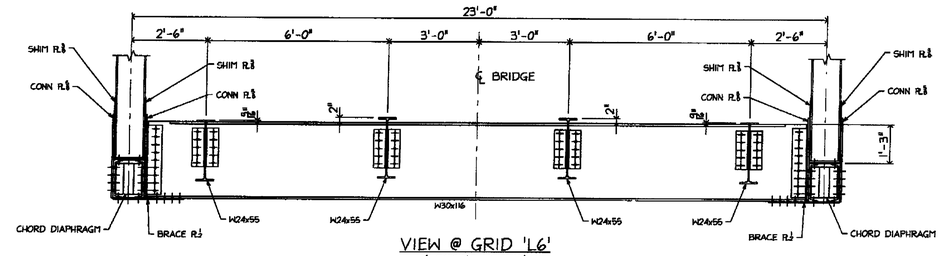

VIEW @ GRID 'L6'
(LOOKING NORTH)

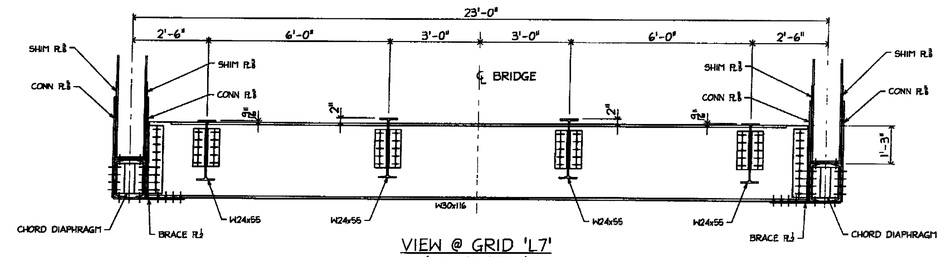

VIEW @ GRID 'L7'
(LOOKING NORTH)

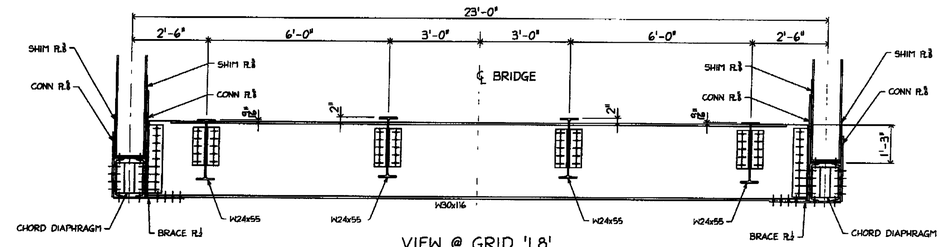

VIEW @ GRID 'L8'
(LOOKING NORTH)

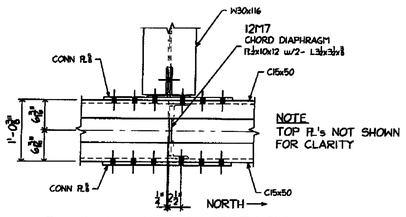

PLAN @ CHORD DIAPHRAGM

SHOP DRAWINGS APPROVED AS NOTED
NO EXCEPTION TAKEN
REVISE AS NOTED
RESUBMISSION NOT REQUIRED
REVISE AS NOTED
RESUBMISSION REQUIRED
REJECTED
DATE 3/24/09
SIGNATURE
Stantec
TBK
REVIEW BY STANTEC IS FOR THE SOLE PURPOSE OF ASCERTAINING GENERAL CONFORMITY WITH DESIGN. CONTRACTOR IS RESPONSIBLE FOR DIMENSIONS, CONFIRMATION AND CONSTRUCTION METHODS, COORDINATION OF WORK, ACCURACY, DETAIL DESIGN OF COMPONENTS, AND ERRORS OR OMISSIONS ON SHOP DRAWINGS

3/11/09 PER APP'L COMMENTS DATED 3/06/09

ARC ENTERPRISES, INC.
KINGFIELD, MAINE

PROJECT STATE OF VERMONT – AGENCY OF TRANSPORTATION
BRIDGE No 31 – RICHMOND, VERMONT

SCALE. NTS	APPROVED BY	DRAWN BY: KAJ
DATE 2/18/09		CHKD. BY: CMDS – DB2

BRIDGE @ HIGHWAY #1 OVER WINOOSKI RIVER
SECTIONS & DETAILS

T BUCK CONSTRUCTION

DWG NO. 09-113 – E6